


GRUNNMYND 1:50

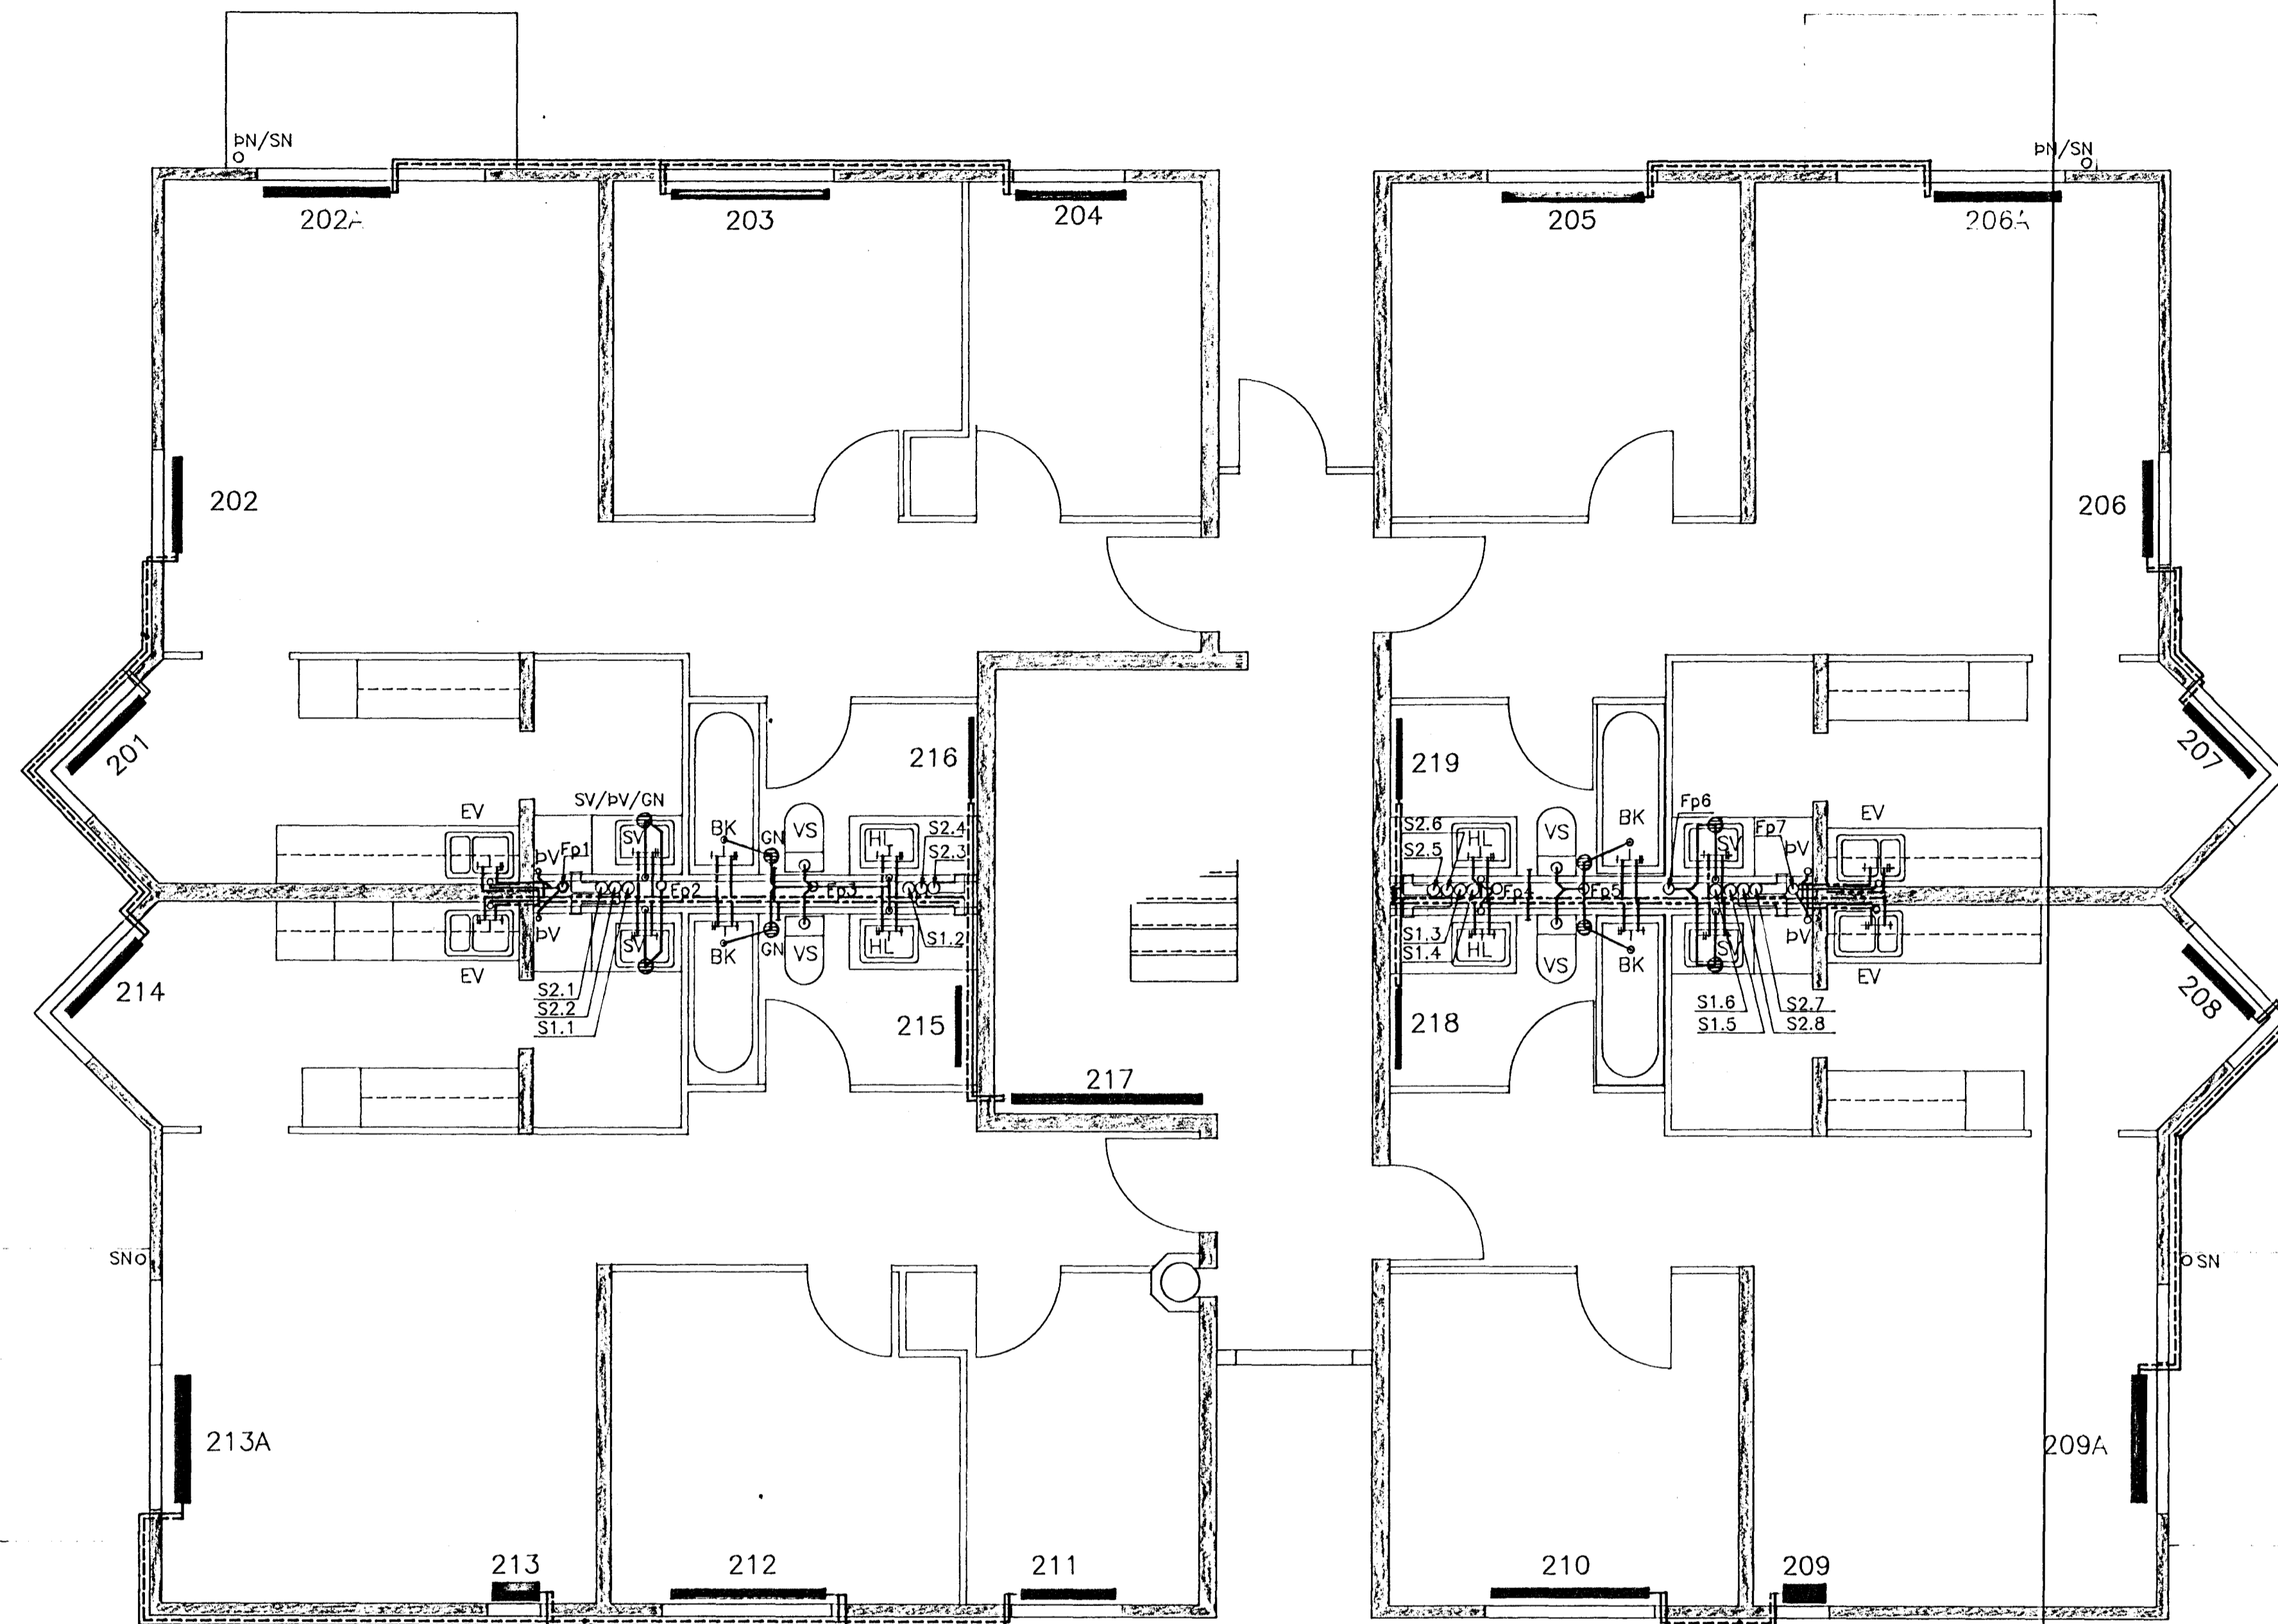

OFNASKRÁ 2.HÆÐ


NR OFNS	HERBERGI	VARMAPÖRF Wött	HÁMARKS		VALDIR OFNAR, DELTA t=40					OFNLOKAR, DANFOSS				ENDANLEG STILLING
			HÆD mm	LENGD mm	TEGUND	GERD/HÆD	AFKÖST Wött	LENGD mm	ÞYKKT mm	TENGING A-B-C-D	TEGUND	litr/klst	STILLING p=0.5 mV	
201	ELDHÚS	1020	600	1000	VORYL	C-60	1015	810	103	CD	RA-2000	22	2.0	
202	STOFA	1420	600	1000	VORYL	C-60	1420	1134	103	AB	RA-2000	31	3.0	
202A	STOFA	580	300	1300	VORYL	C-28.5	806	1296	103	CD	RA-2000	17	1.5	
203	HJÓN	840	600	1650	VORYL	1-60	890	1782	59	AB	RA-2000	19	2.0	
204	HERBERGI	590	600	1050	VORYL	A-60	642	972	59	AB	RA-2000	14	1.5	
205	HJÓN	990	600	1650	VORYL	C-60	1089	1620	59	CD	RA-2000	23	2.5	
206	STOFA	1420	600	1000	VORYL	C-60	1420	1134	103	AB	RA-2000	17	1.5	
206A	STOFA	580	300	1300	VORYL	C-28.5	806	1296	103	CD	RA-2000	17	1.5	
207	ELDHÚS	1020	600	1000	VORYL	C-60	1015	810	103	AB	RA-2000	22	2.0	
208	ELDHÚS	1220	600	1000	VORYL	C-60	1218	972	103	CD	RA-2000	26	2.5	
209	STOFA	610	600	450	VORYL	C-60	608	486	103	AB	RA-2000	13	1.5	
209A	STOFA	1190	300	1300	RUNTYL	C21/2	1333	1300	165	AB	RA-2000	28	2.5	
210	HJÓN	840	600	1650	VORYL	1-60	811	1620	59	AB	RA-2000	17	1.5	
211	HERBERGI	660	600	1050	VORYL	A-60	642	972	59	AB	RA-2000	14	1.5	
212	HJÓN	840	600	1650	VORYL	1-60	811	1620	59	CD	RA-2000	17	1.5	
213	STOFA	610	600	450	VORYL	C-60	608	486	103	AB	RA-2000	13	1.5	
213A	STOFA	1190	300	1300	RUNTYL	C21/2	1333	1300	165	AB	RA-2000	28	2.5	
214	ELDHÚS	1220	600	1000	VORYL	C-60	1218	972	103	CD	RA-2000	26	2.5	
215	BAD	400	600	800	VORYL	1-60	406	810	59	AB	FJVR-10	9		
216	BAD	400	600	800	VORYL	1-60	406	810	59	CD	FJVR-10	9		
217	STIGAHÚS	1400	600	1800	VORYL	2-60	1419	1782	103	CD	FJVR-10	31		
218	BAD	400	600	800	VORYL	1-60	406	810	59	CD	FJVR-10	9		
219	BAD	400	600	800	VORYL	1-60	406	810	59	AB	FJVR-10	9		


SAMTALS:

19840

20708

ÁSKILID, ELDRI
TEIKNING ÓGILD

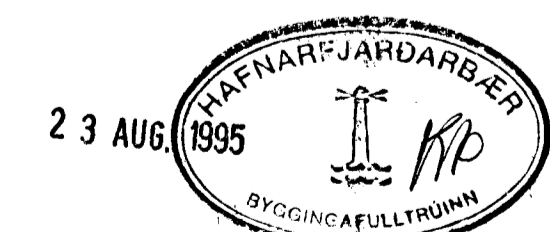

SÚÐURBRAUT 2A, HAFNARFIRDI		HITA- NEYSLUVATNS- OG ÞRIFAKERFI GRUNNMYND, 2.HÆÐ	
 VERKFAEÐISTOFA STEFÁNS & BJÖRNS <small>BEIARHRAUNI 20 • 220 HAFNARFJÖRÐUR SMÍ 565-1340 • FAX 565-1341 KL: 610185-1419</small>		B: Breytt 16.08.95, Gólfgeisli út Hannab: SV Teiknab: SV Mát: 1:50 Samþykkt: <i>Stefán Björnsson</i> Daga: 31.07.95 Nr: 9437-L04-B	