


Grunnmynd 1/50

Suðurgata 17. Hf. 2.hæð.

- Herbergi 10,5m<sup>2</sup>
- Herbergi 10,3m<sup>2</sup>
- Eldhús 7,9m<sup>2</sup>
- Baðh. 5,3m<sup>2</sup>
- Stofa 30,0m<sup>2</sup>
- annað 23,3m<sup>2</sup>
- samtals 87,3m<sup>2</sup>
  
- Pallur 12,7m<sup>2</sup>
- samtals 100,0m<sup>2</sup>

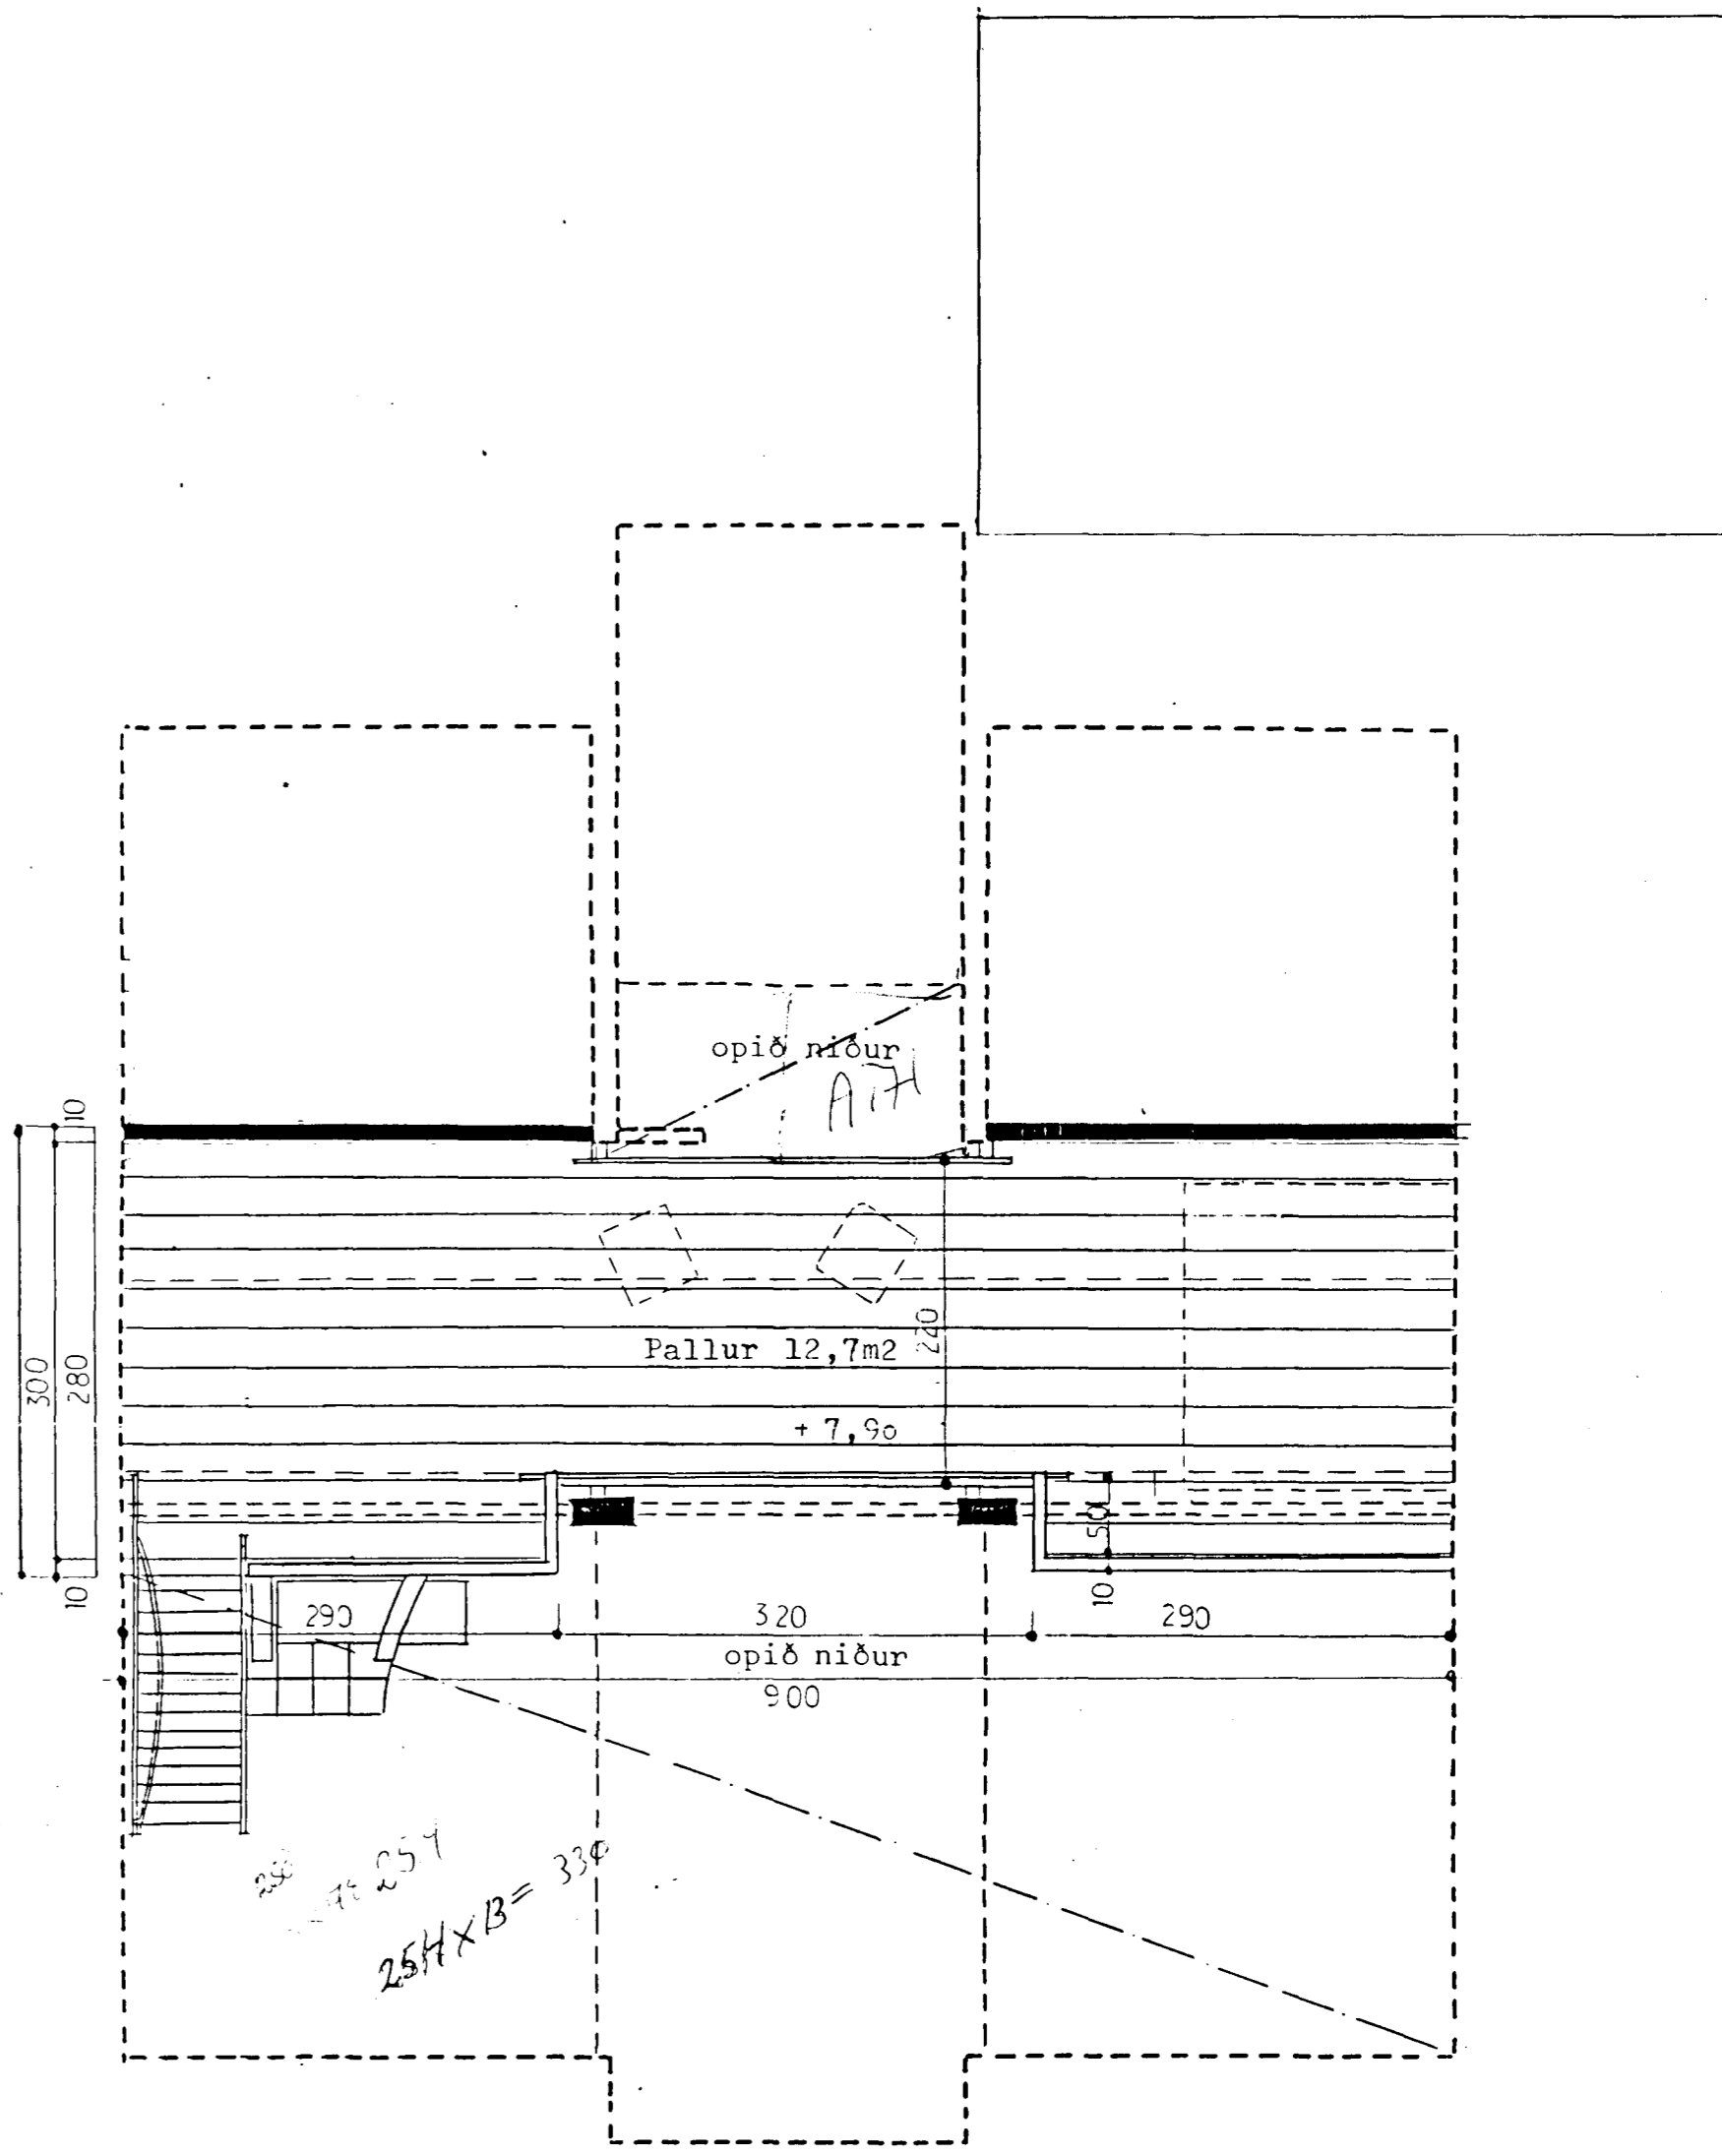

Grunnmynd 1/50