


Fullnægja þarf kröfur
Brandmálkastofnanna vegna af
heild byggingarinnar.
(Sjå tekiðni búkun)




NOED-VESTUR




SUD-AUSTUR

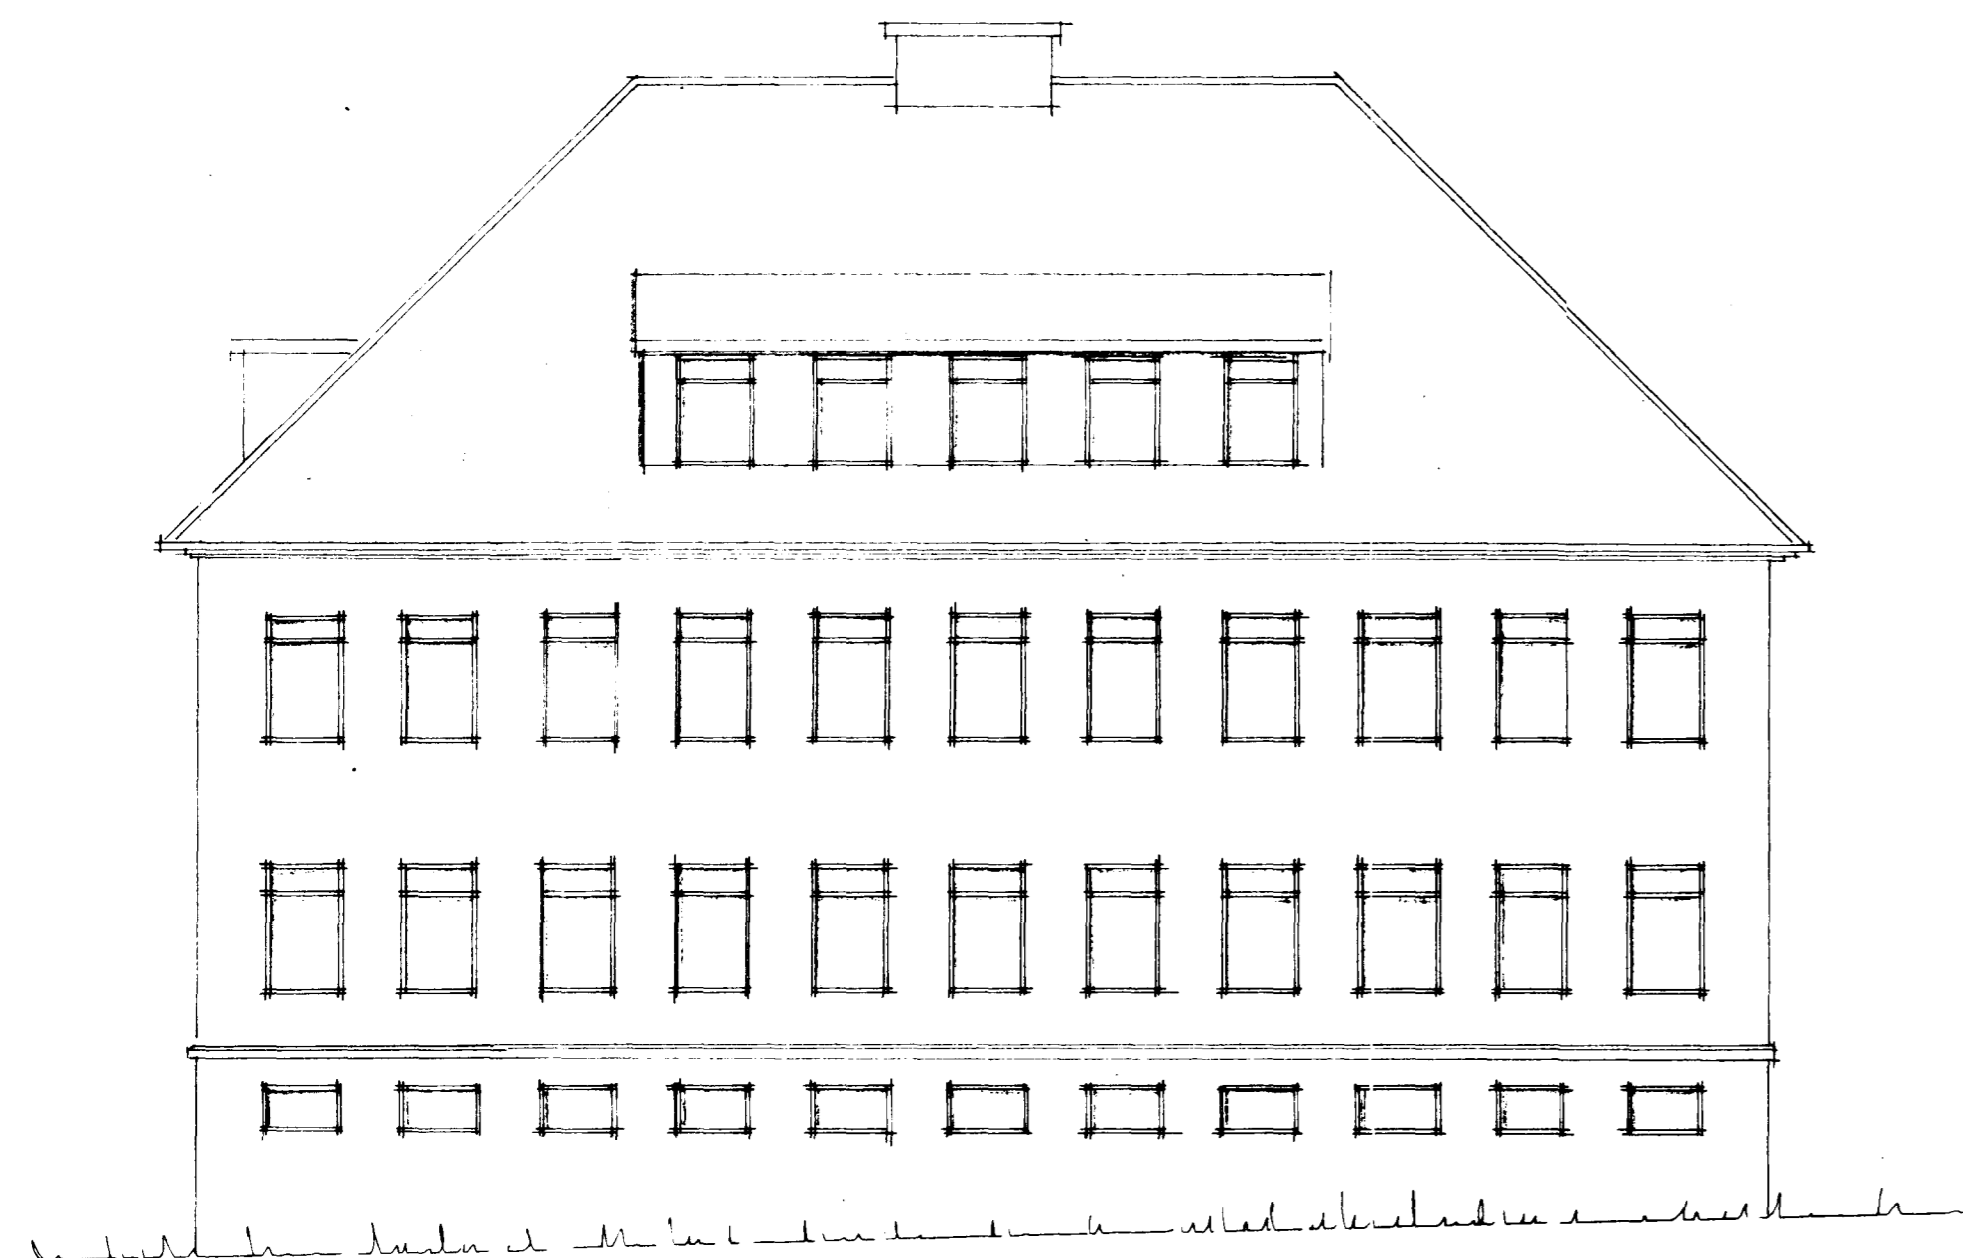

SUD-VESTUR

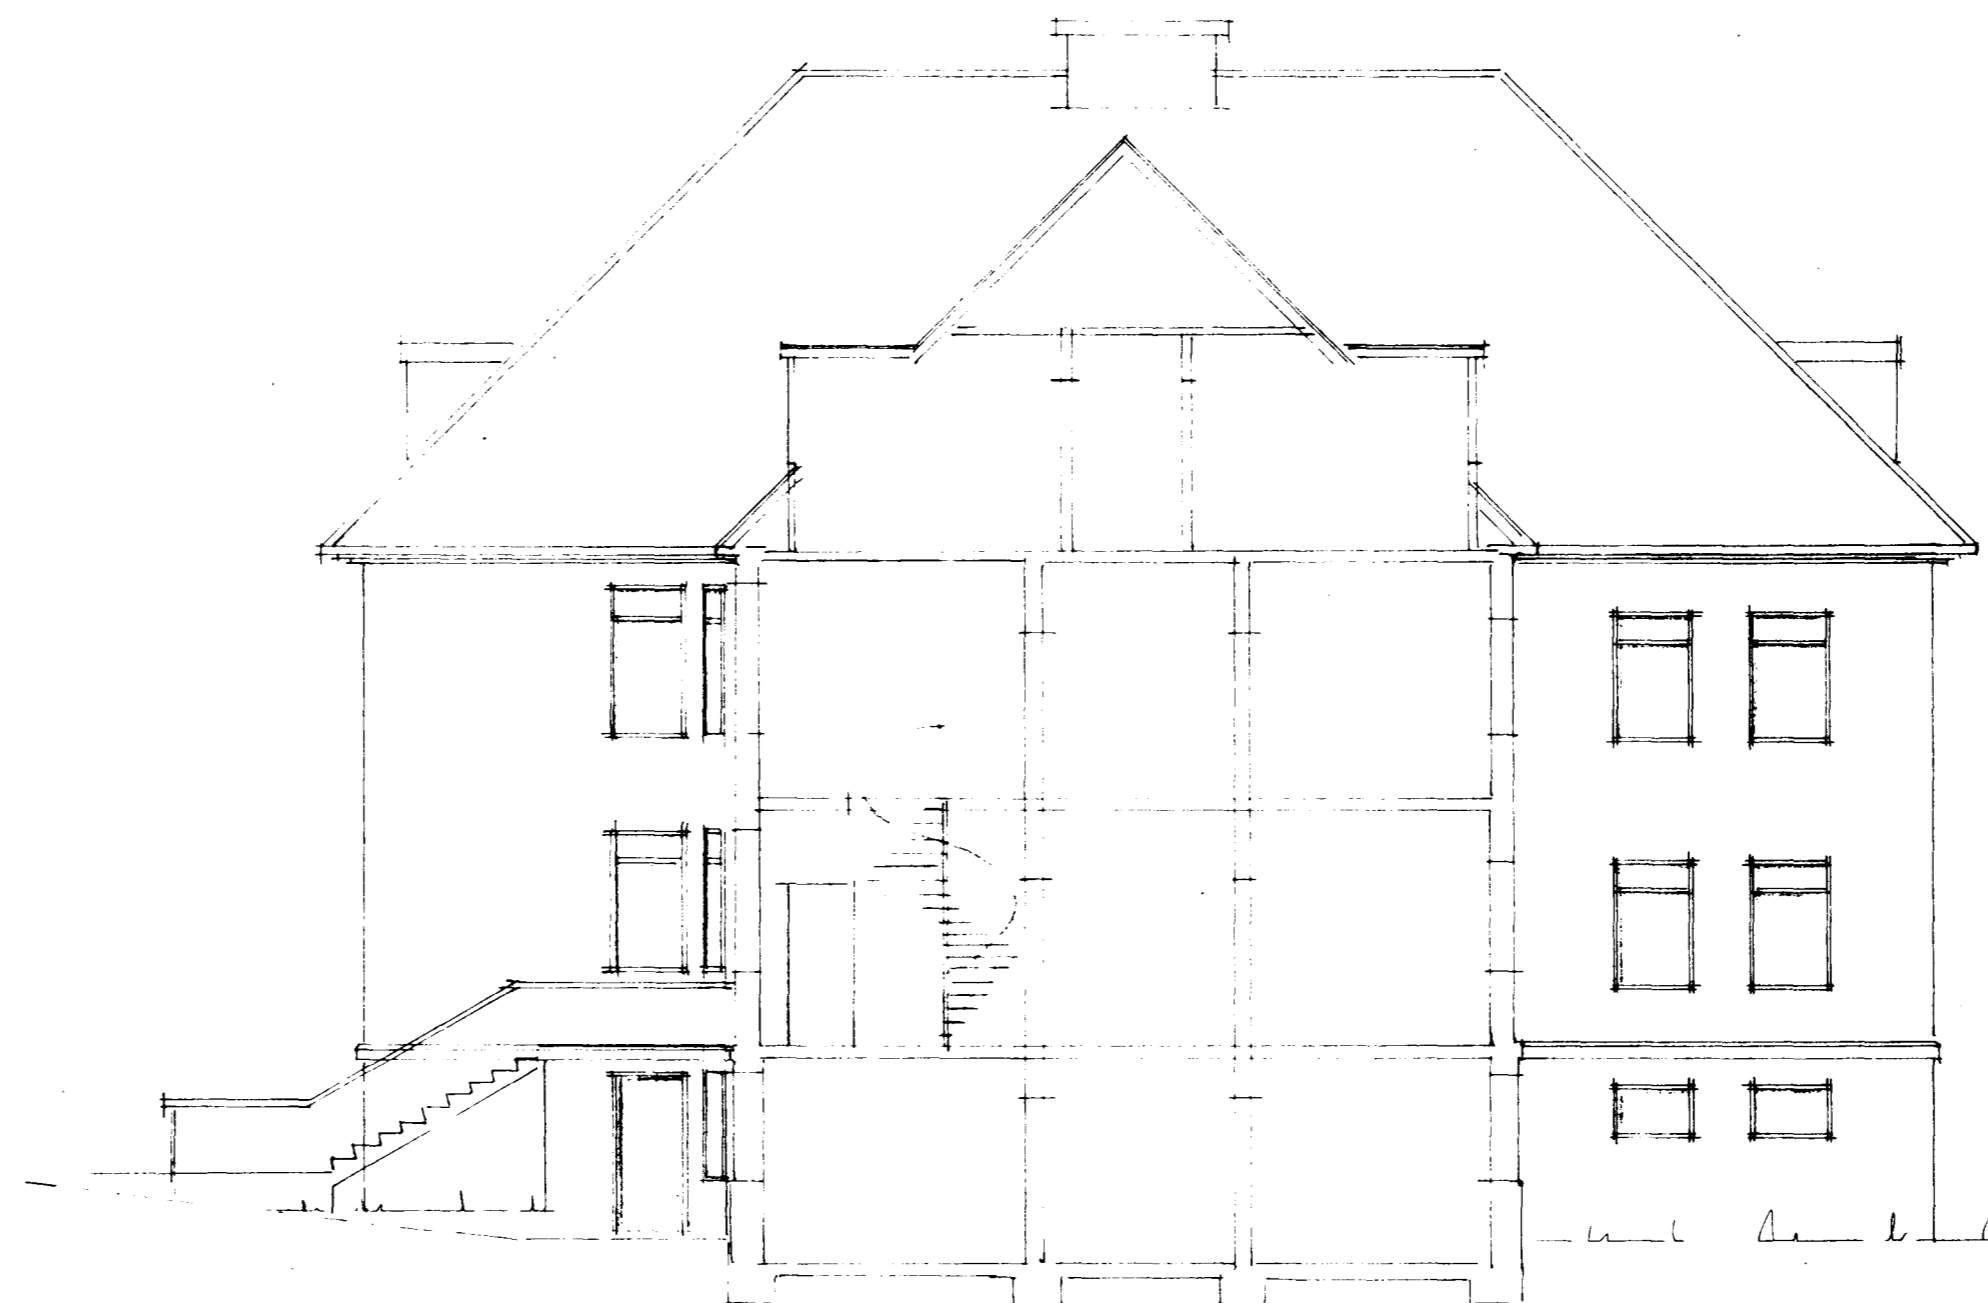

NOED AUSTUR

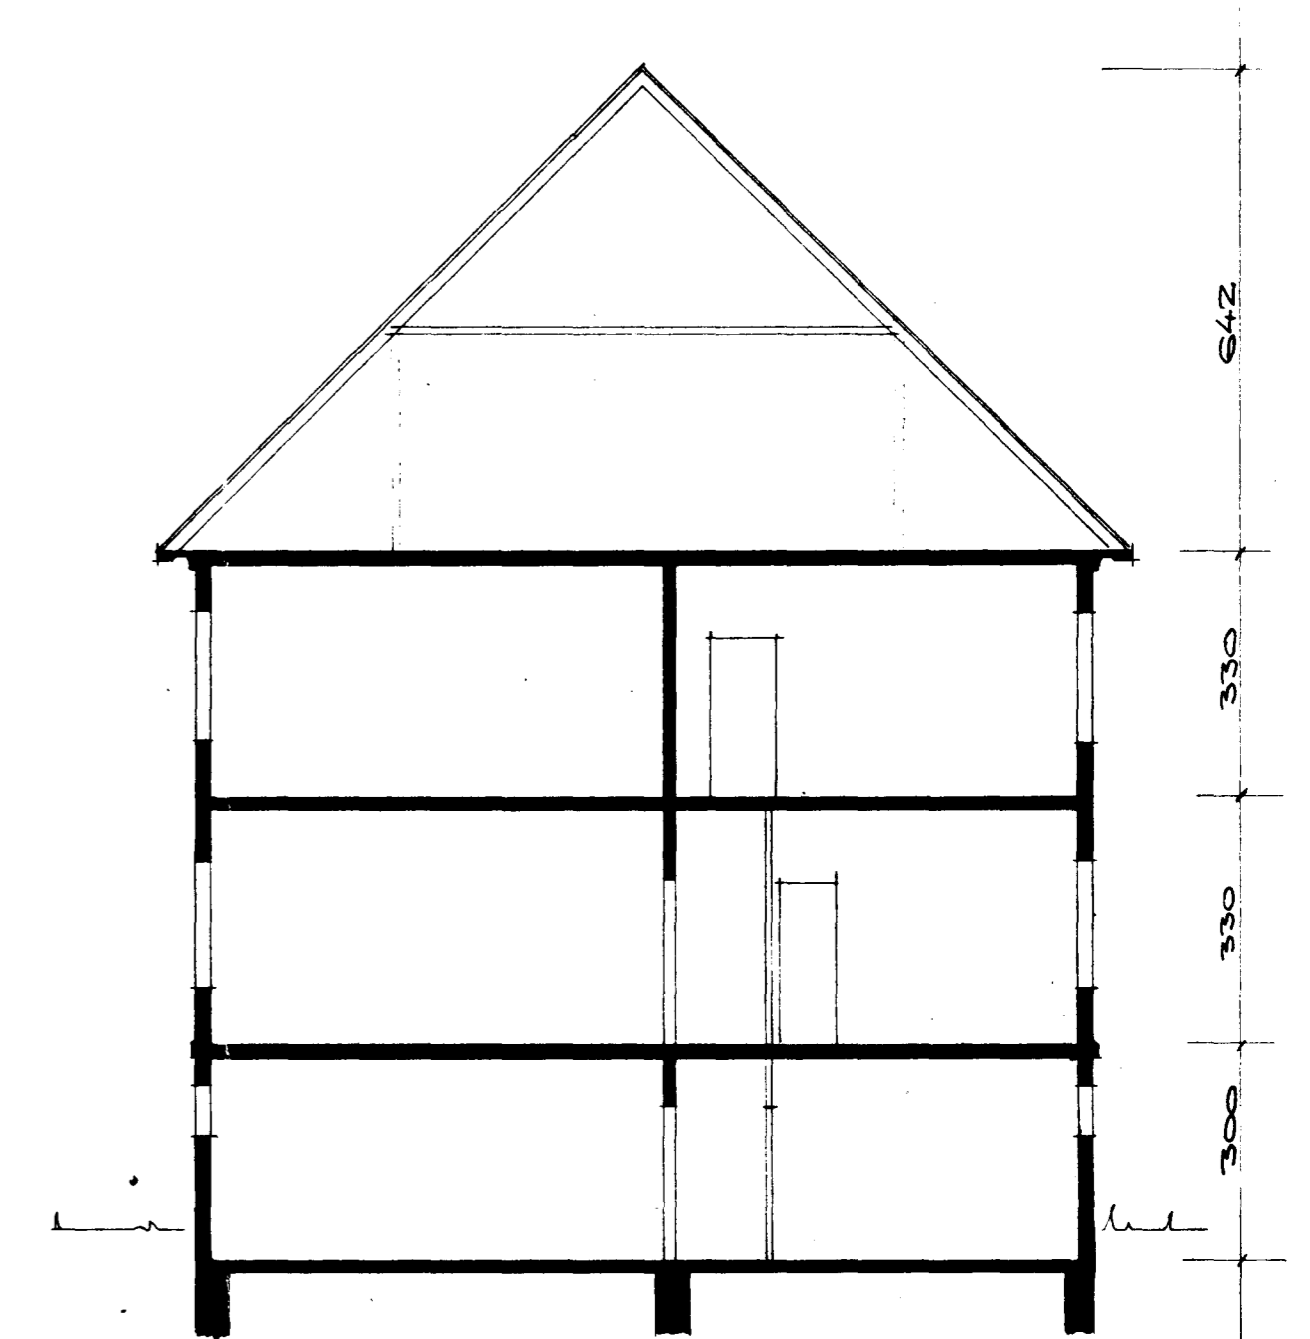

SNID A-A