


GRUNNMYND  
KVARDI 1:50

VATNSINNITAK 1 1/2" RALU  
OFAN VID KJALLARADLF

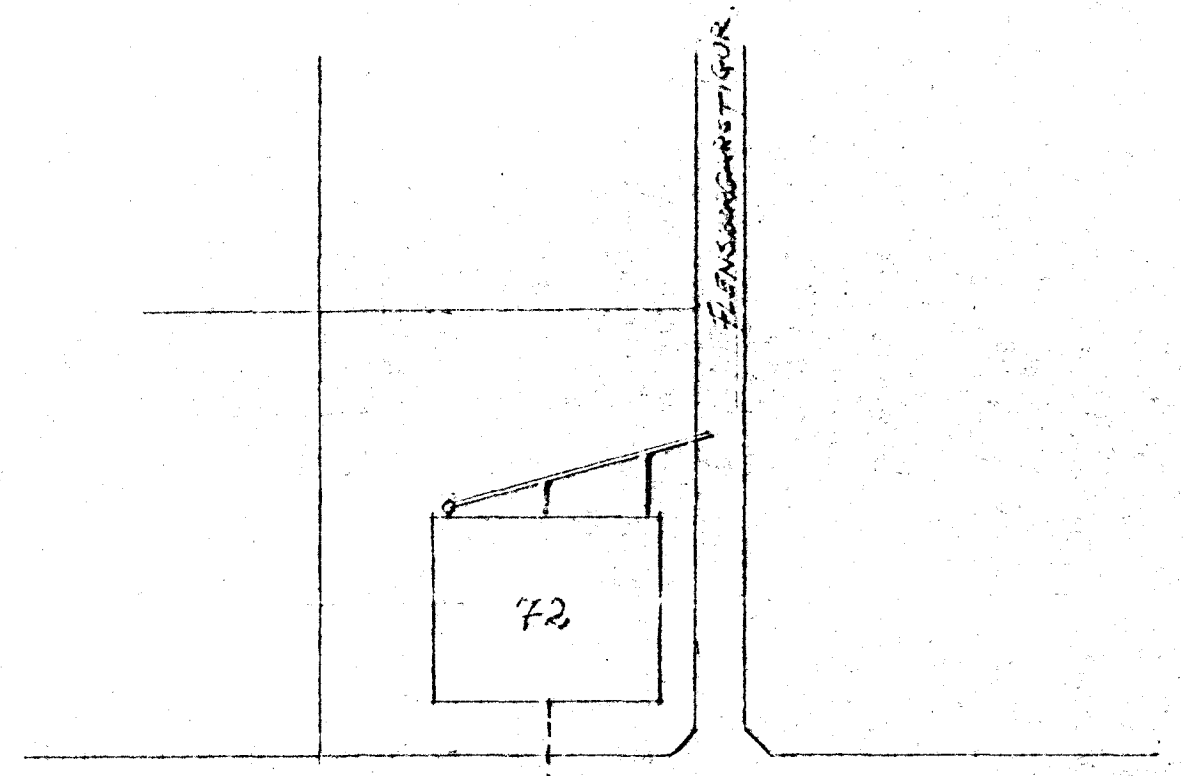

SUURGATA

AFSTODUMYND  
KVARDI 1:500

SUURGATA 72

SKOLPLÖGN I GRUNNI

Hafnarfjörður í des. 1968  
Forskiptur Siggeirsson F.T.F.I.