

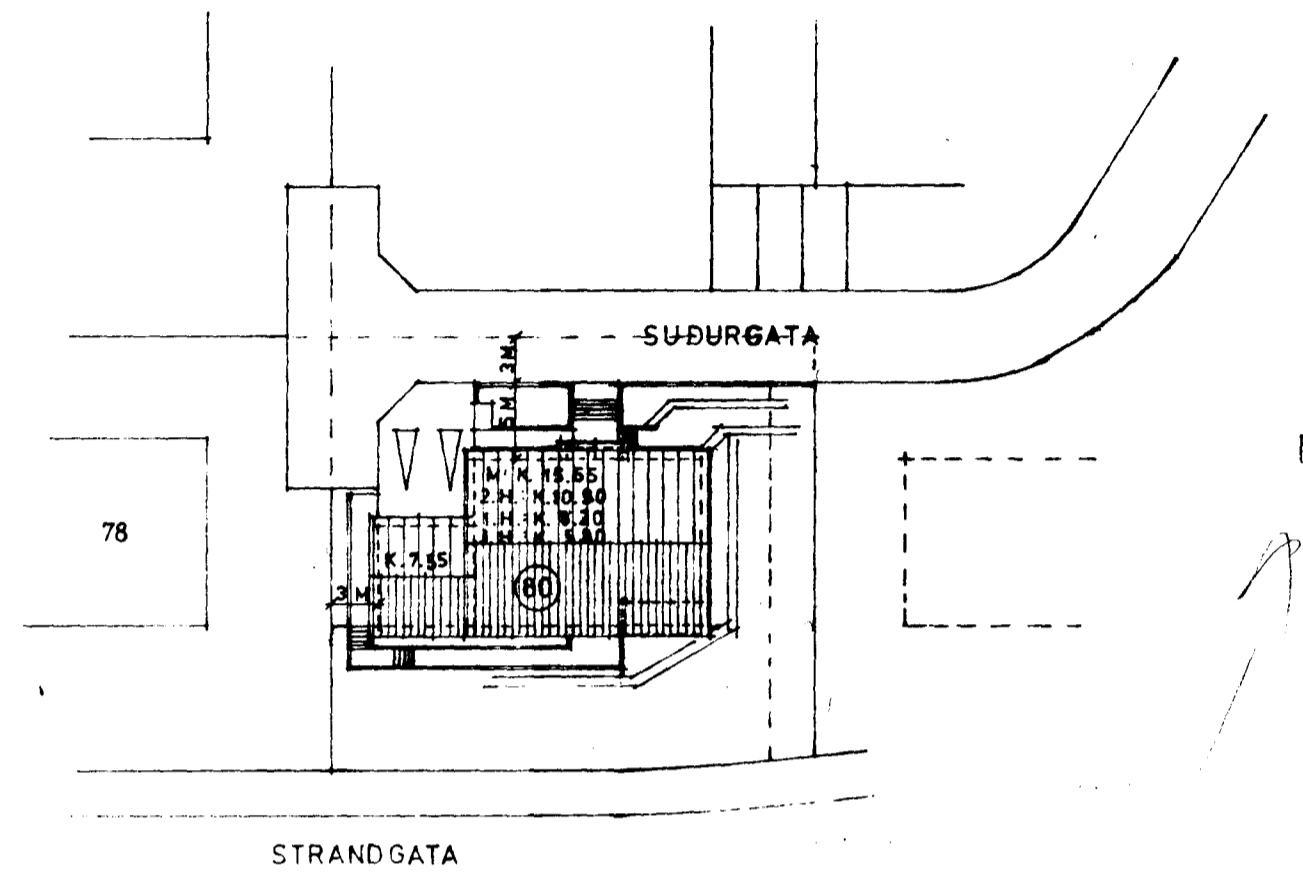


Samþykkt á fundi bygginga-
nefndar þ. 4. 2. 1981
12. 5. 1982
BYGGINGAFULLTÖLUNN
Í HAFNARFIRDI
S. Jónsson

Þessi opna búnaðs skala vera
á löttum. F.S.S.

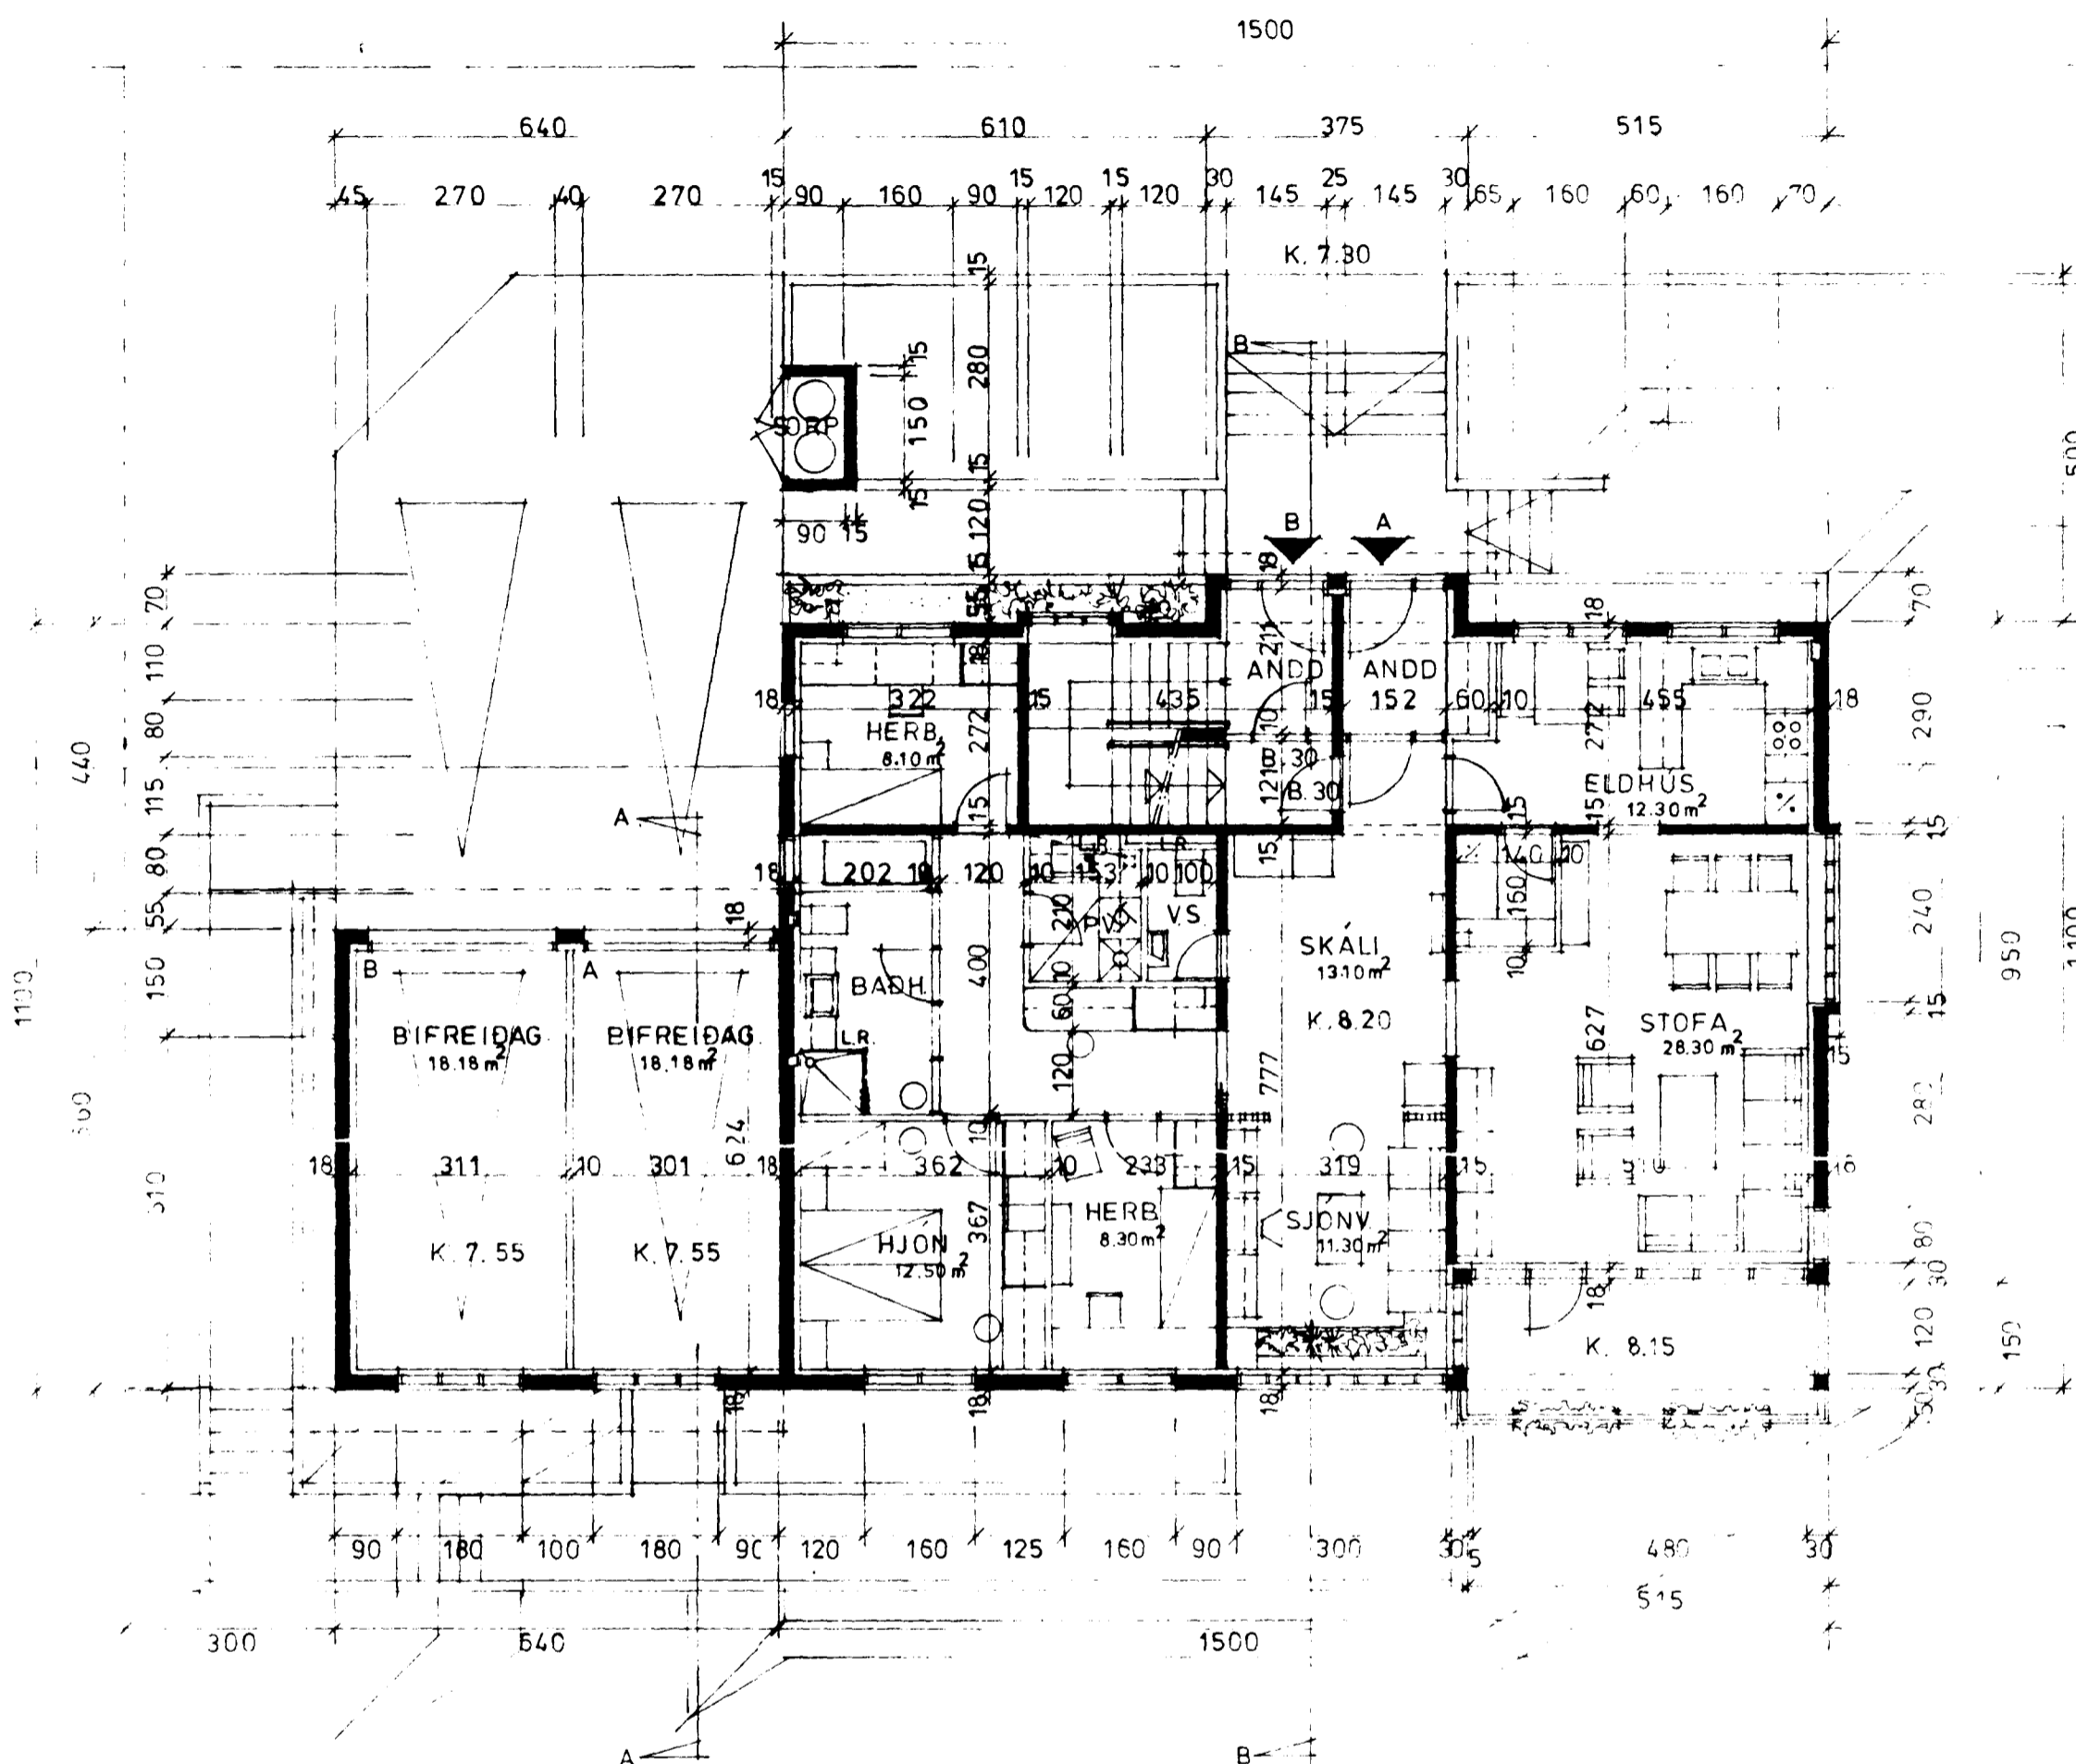

AFST. MYND: 1/500

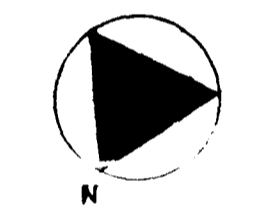

BRÚTTÓ:


JARÐHÆÐ:	193,24 m²
1. HÆÐ:	159,90 m²
2. HÆÐ:	157,27 m²
BIFRG:	42,24 m²
552,65 m²	

RÚMMÁL:

ÍBÚÐ:	1383,60 m³
BIFRG:	221,76 m³
1605,36 m³	

KÓLNURTÖLUR SÉU
SAMKV. ISL. ST. 66.

1. HÆÐ M. 1:100.

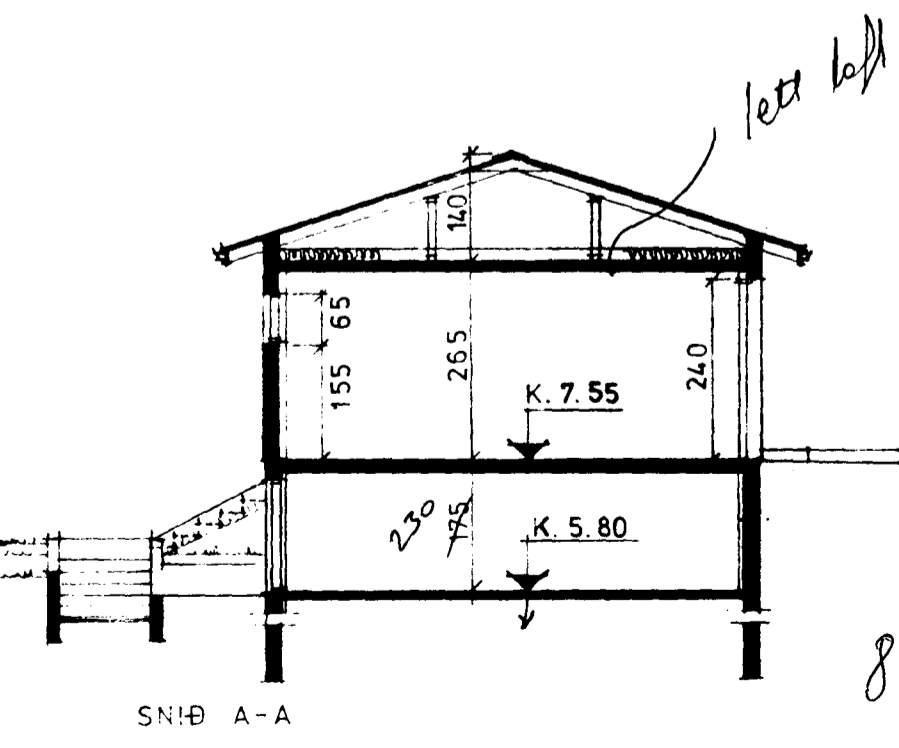

SNÍÐ A-A

8470-0800 01

02

Þ. Jónsson