


RÚMMYND 1:50

23 JAN 1989

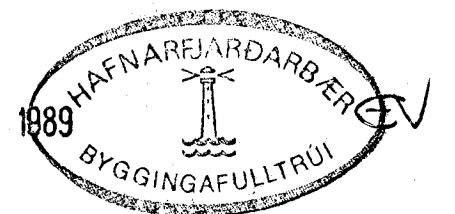

DI 12.01.89 OFN NR. 106 OG 101 FERDIR.		SIGN.	
BR. NR.	DAGS	EDLI BREVTINGAR	
SUÐURHVAMMUR 20 HAFNARFIRÐI		DAGS	JULI 88
RÚMMYND HITALAGNA		HANNAÐ	4.21
		TEIKNAD	4.21
		VERK NR.	B752
MÆLIKV. 1:50		BLAD NR.	2-05
SIGURÐUR ÞORLEIFSSON TEKNIFRÉÐINGUR F.T.F.I.			
STRANDGÖTU 11 HAFNARFIRÐI SÍMI 54751			