
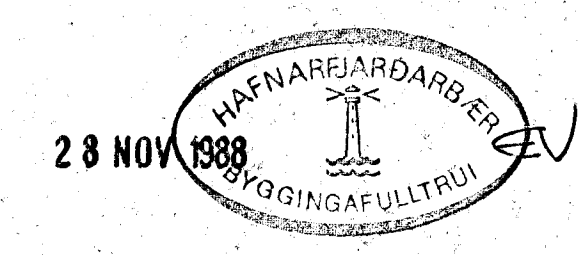


GRUNNMYND 1:50

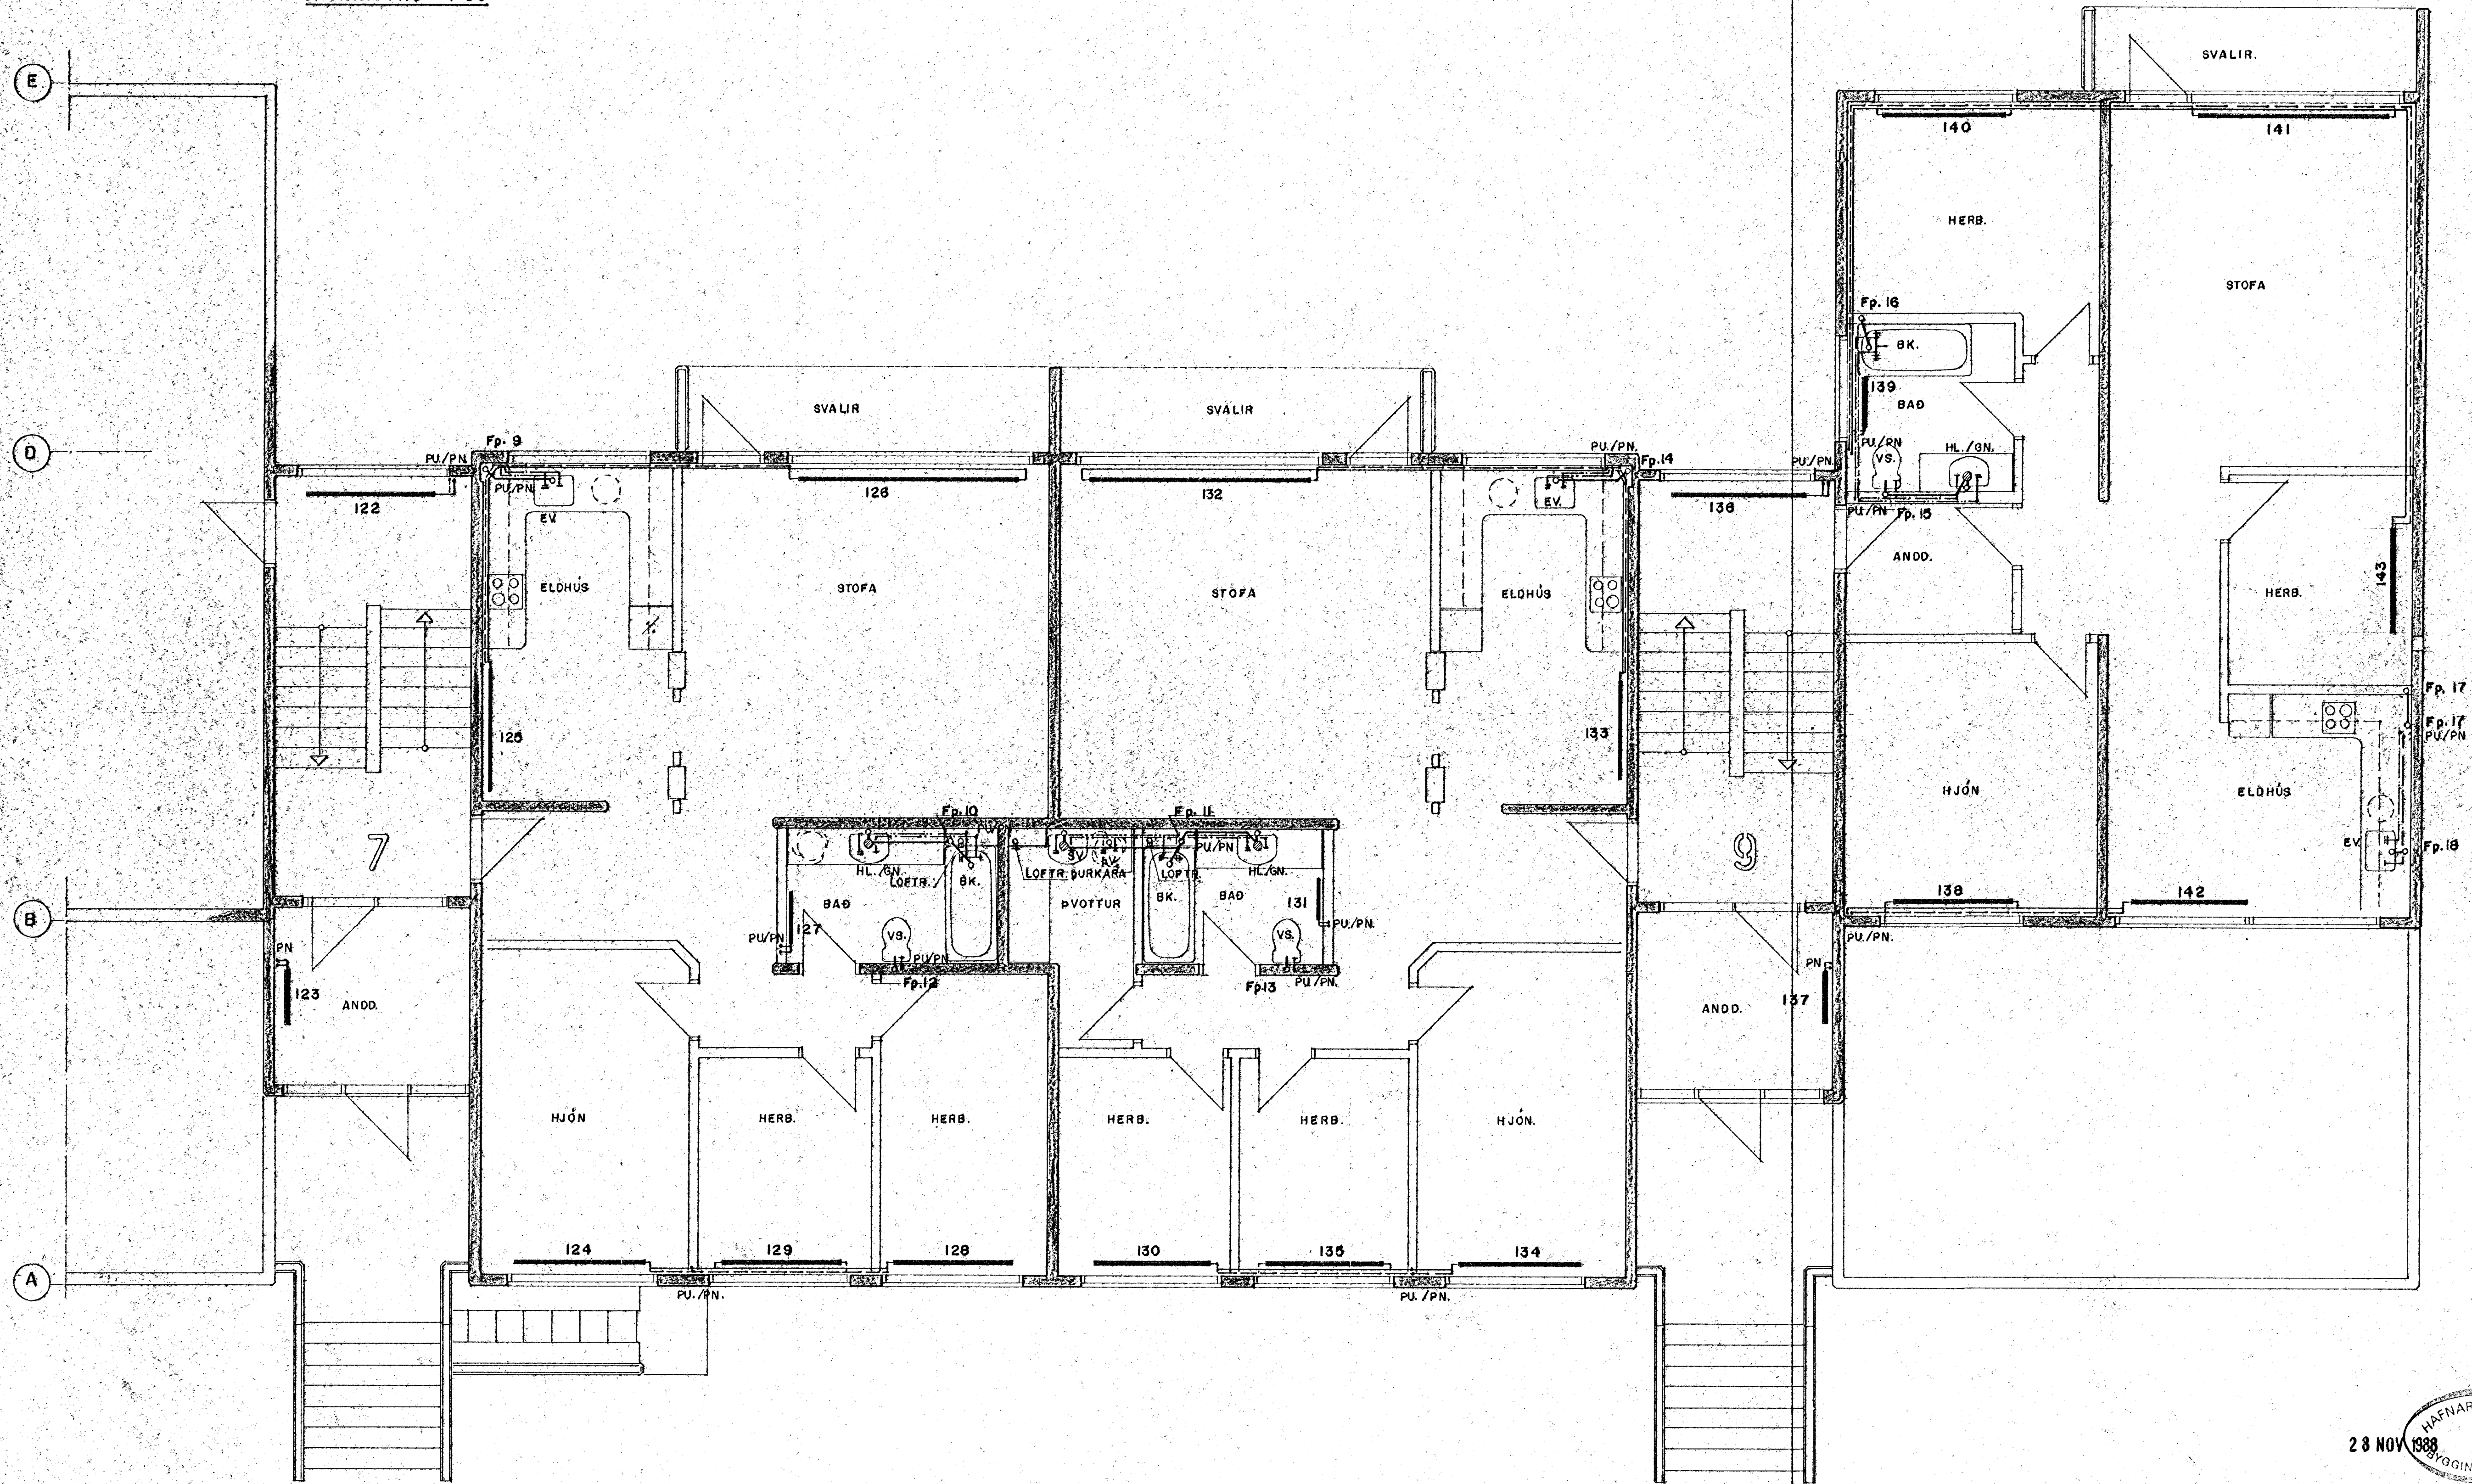

SUDURHVAMMUR 5-7-9, HAFNARFIRÐI					
A	II.11.88	OFNI NR.143 BÆTT INN	B8	GRT	HITA- OG PRIFALÖGN
SK.NR	SPREYTING				GRUNNMYND I. HÆÐ
Verkfræðistofa Stefáns og Björns s.f. CONSULTING ENGINEERS REYKJAVÍKURVEGI 68 HAFNARFIRÐI - Sími 91 651340					SKV. 1:50 VERK.NR. 88.08 DR.NR. L7
TEK.NR	AB	TEK.NR	GRT	TEK.NR	B.G.
DAGS	13.07.88	TEK.NR		TEK.NR	