
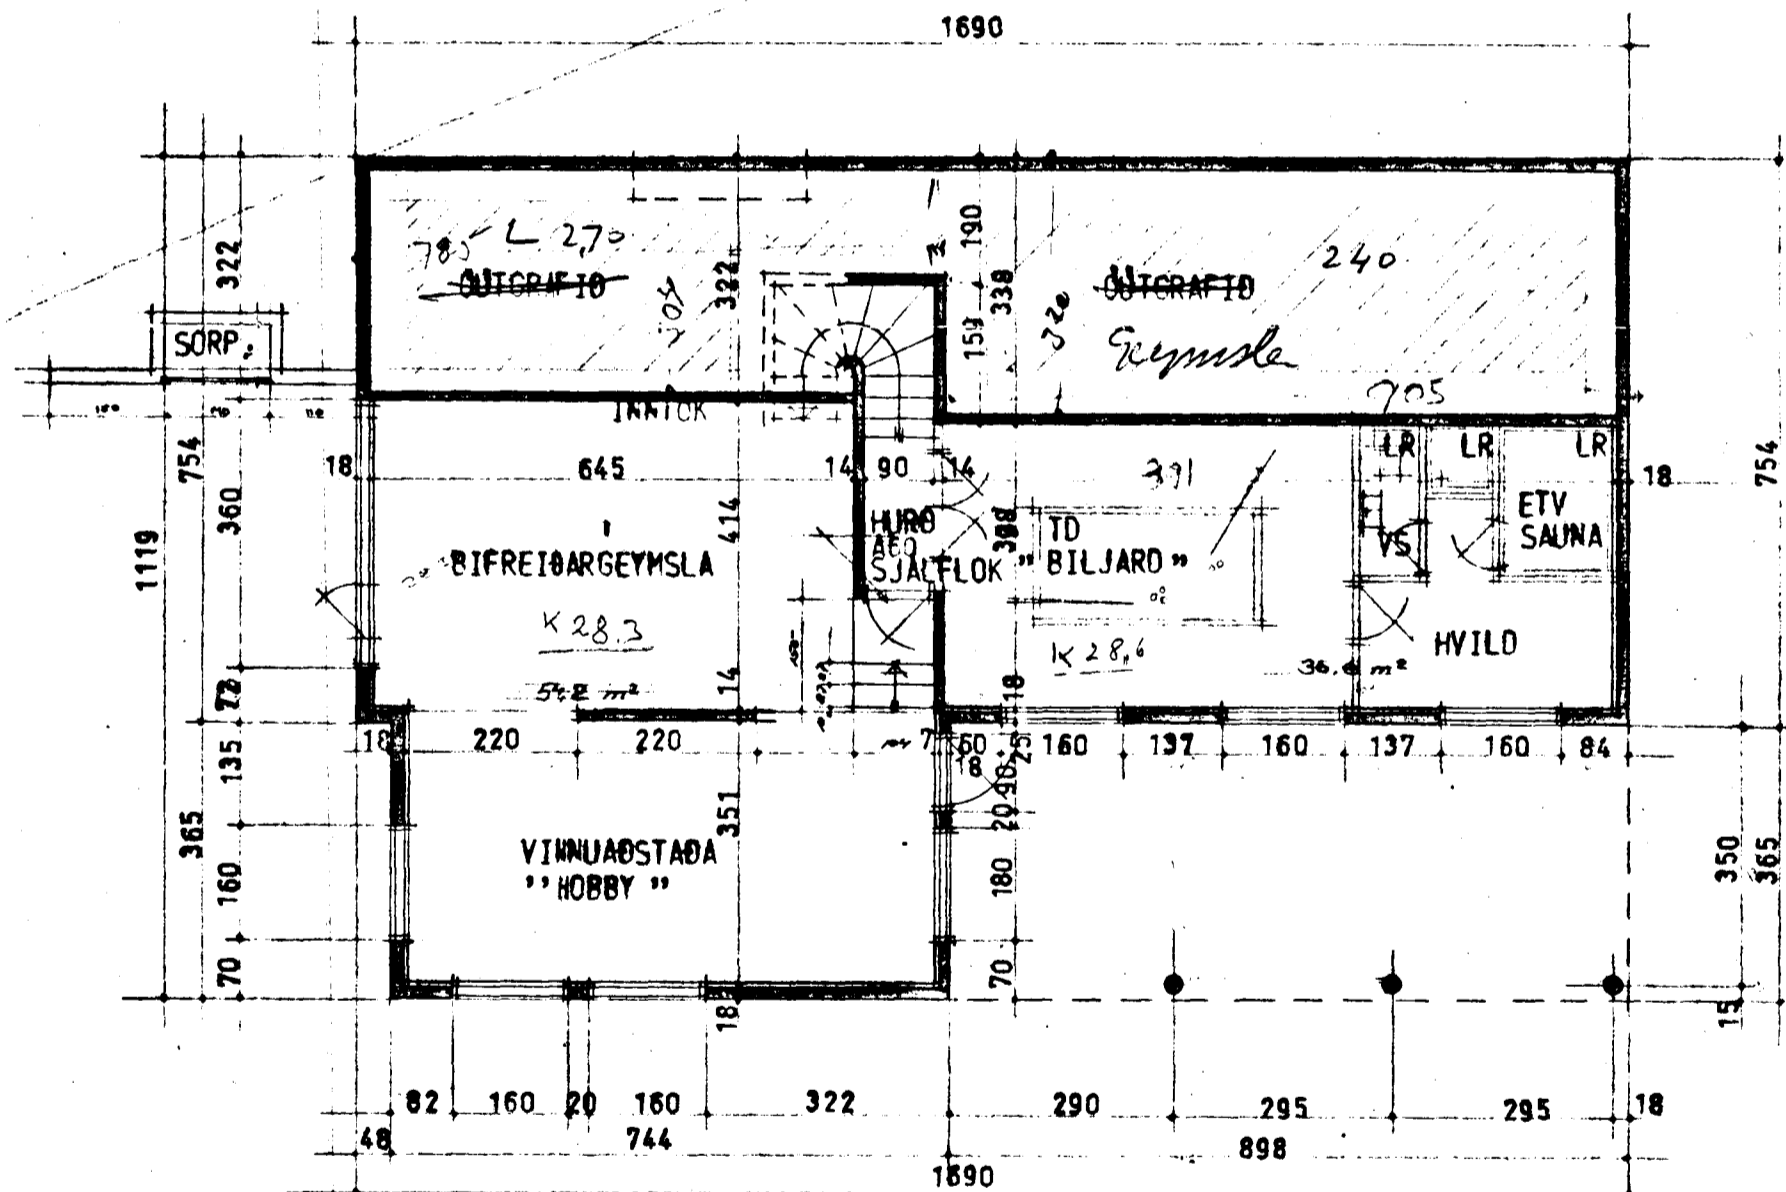


E. Jónsson


FLATARMÁL EFRI HAÐAR	153,2 M ² BRUTTO	132,3 M ² NETTO
FLATARMÁL NEÐRI HAÐAR M.BILG.	97,4 M ² BRUTTO	87,6 M ² NETTO
SAMTALS	250,6 M ² BRUTTO	219,9 M ² NETTO

FLATARMÁL LÖÐAR	1034,2 M ²
NÝTINGARHLUTFALL LÖÐAR	0,24

VEGGIR : MÓÐAL K-GILDI	M	1,00
GDLF : K-GILDI	M	0,40
ÞAK : K-GILDI	M	0,30

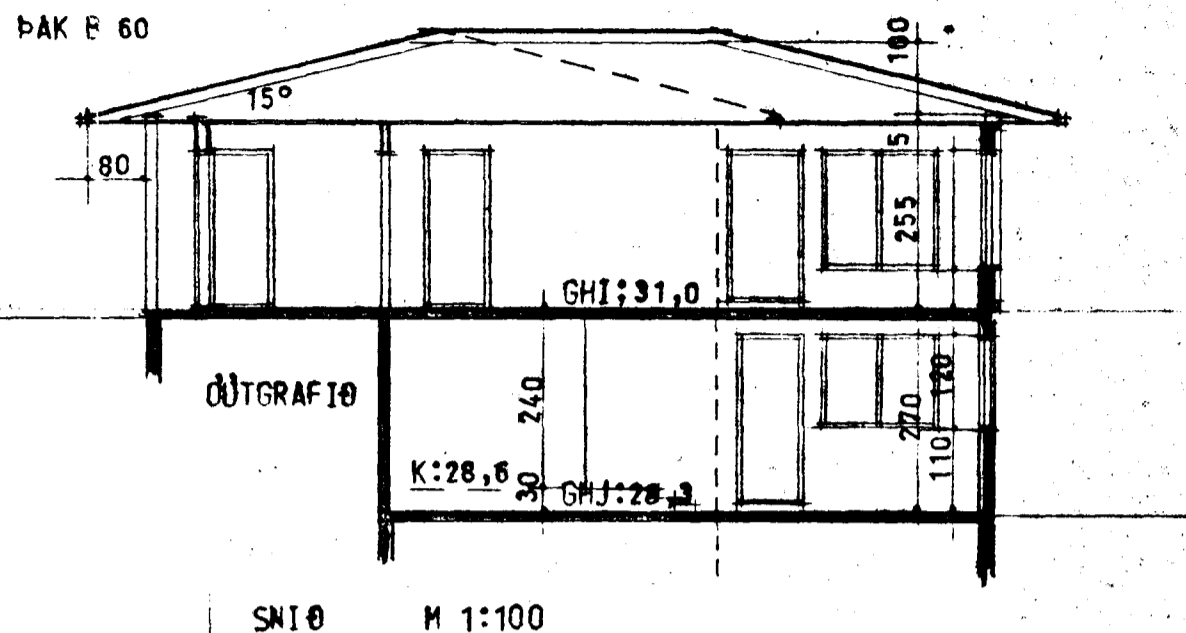

GRUNNMYND KJALLARA M 1:100

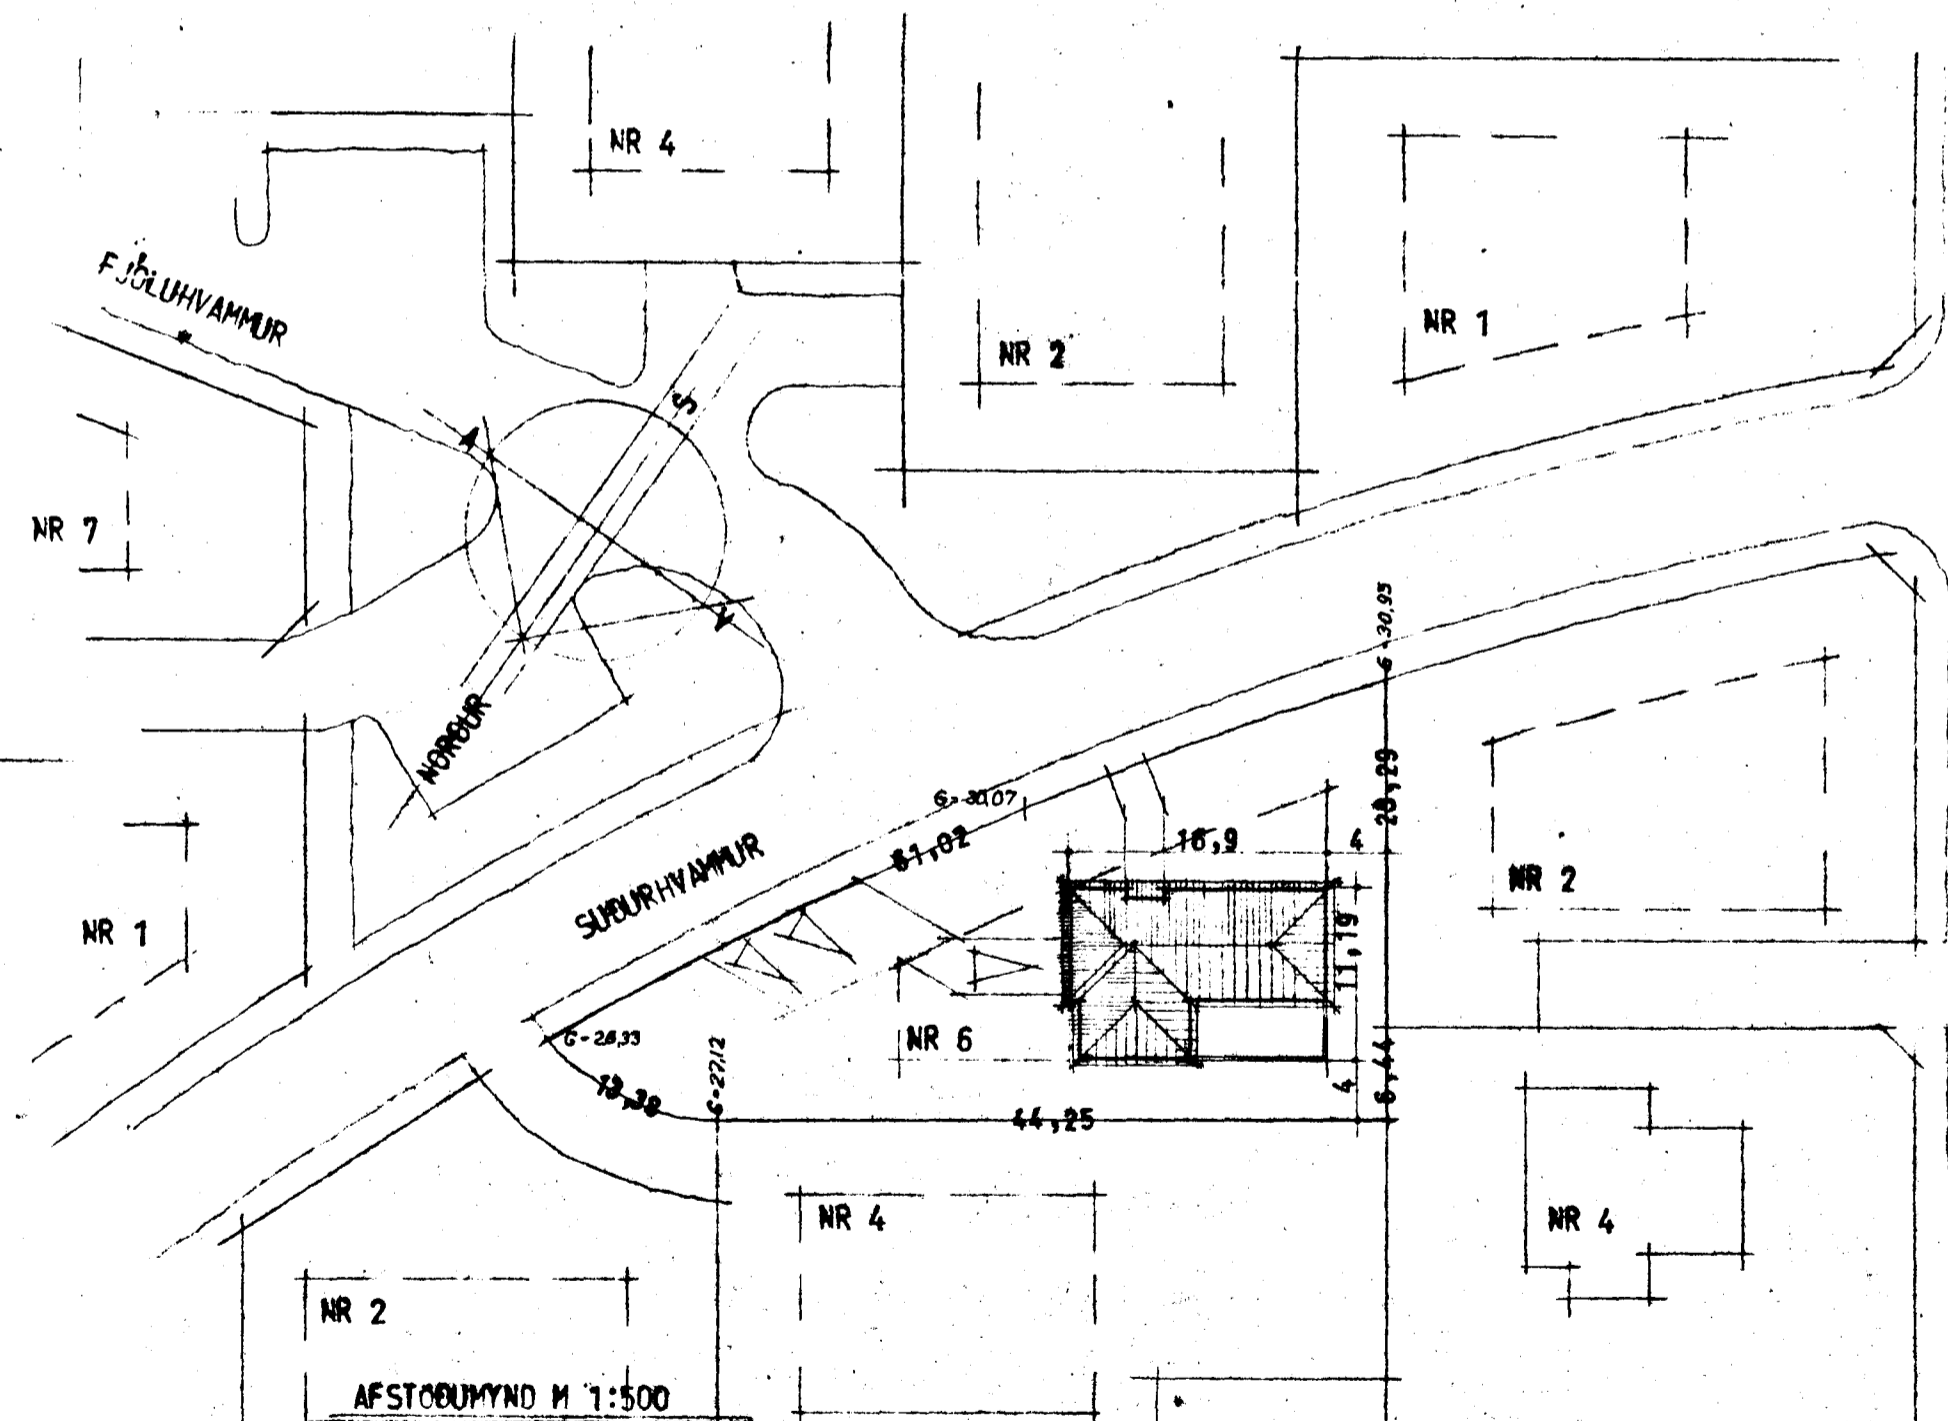

NR 2
AFSTÖÐUMYND M 1:500

VERKEFNI	TEIKN.NR.	TEIKN.NR.
SÚÐURHYMUR 6, HAFNAFIRÐI	DAGB. AG 79	101
AFSTÖÐUMYND	M 1:500	
GRUNNMYND KJALLARA OG SNIÐ	M 1:100	

ARKO *Samþykkt bygginga-
nefndar þ. 5.19.1979*
ÁSMUNDIUR, RÓBERT OG KALDAL SKÓLAVÖRÐUSTÍG 46 SÍMI 21930