


GRUNNMYND 1:50

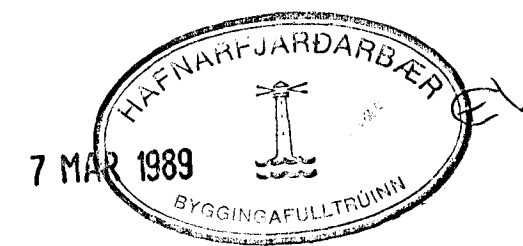

01	020389	LEGU LAGNA BREYTT	4.21
BR.NR.	DAGS	EDLI BREYTINGAR	SIGN.
SUDURVANGUR IS HAFNARFIREÐI			DAGS. DES. BB
GRUNNMYND RISHEDAR			HANAB 4.21
HITA OG VATNSLAGNIK			TEIKNAB 4.21
MELIKV. 1:50			VERK NR. 8810
SIGURÐUR ÞORLEIFSSON TEKNIFRÆÐINGUR F.T.F.I.			BLADNR.
STRANDGÖTU 11 HAFNARFIREÐI SÍMI 54751			2-06