


SUNHEIC VEGUR 5. HAFNAZFIREI.
SKALE 1:100.
BREYTING.


ambykkt & fundi byggð
efndar þ. 2/11 1960

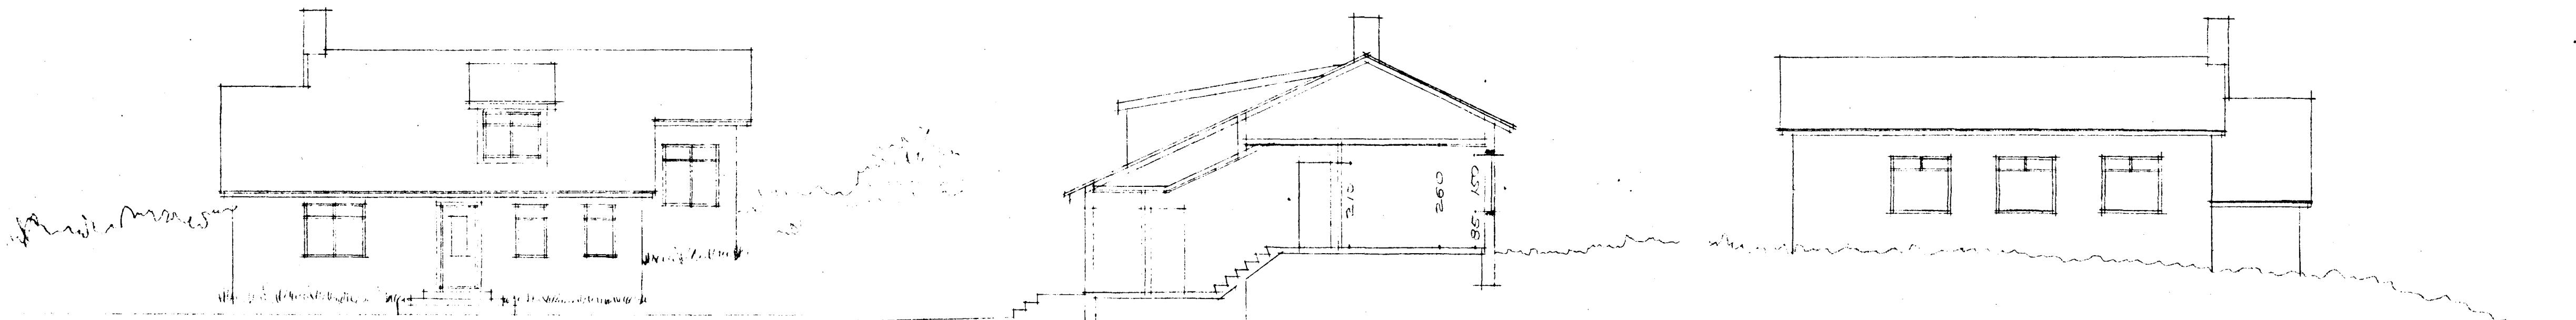

S U D U R



NORDU

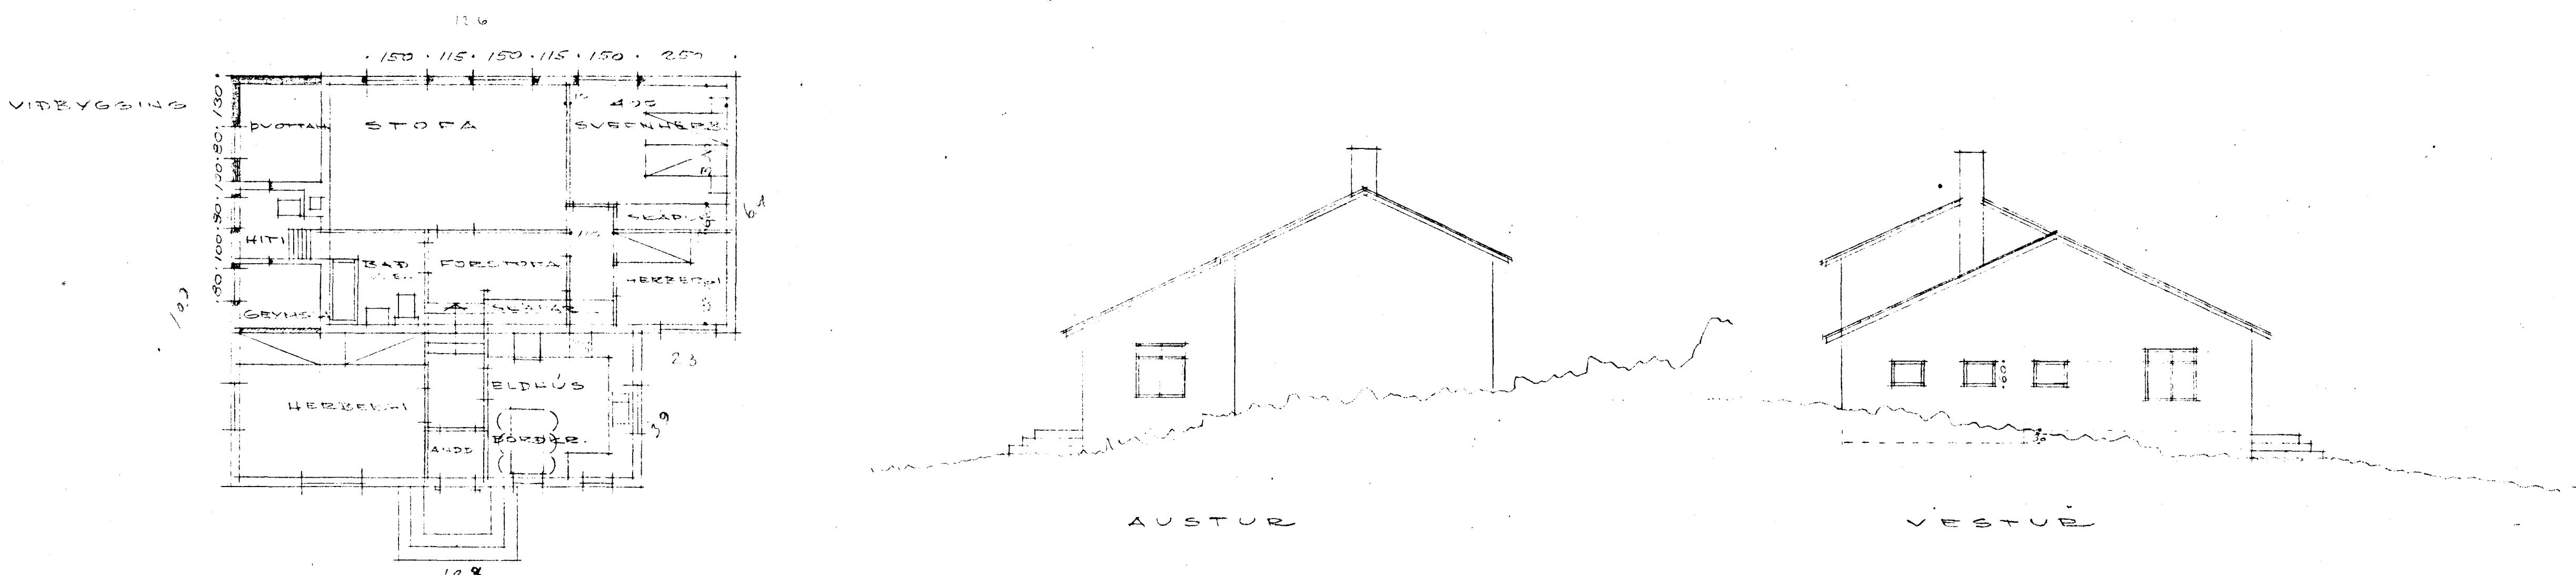

U S T U R

V E S T U E

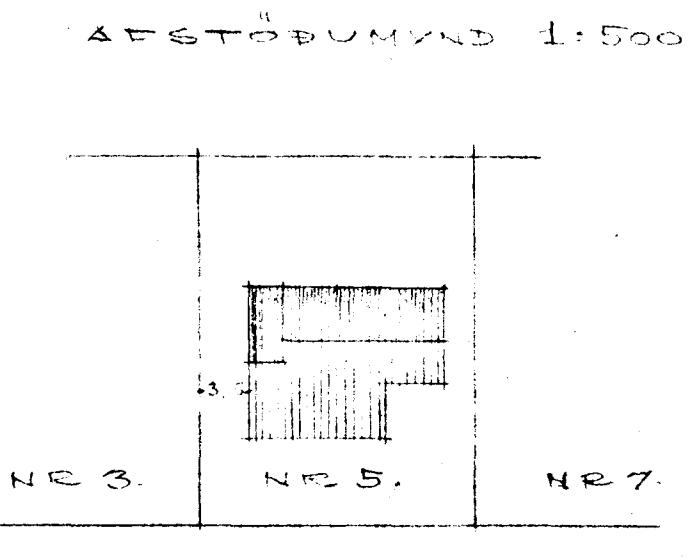

SUNNUVEGUR


169-1.
EYTIN
AL 1:100
-10.-1960.
ERTAN SIGURDSSON
KITEKT