



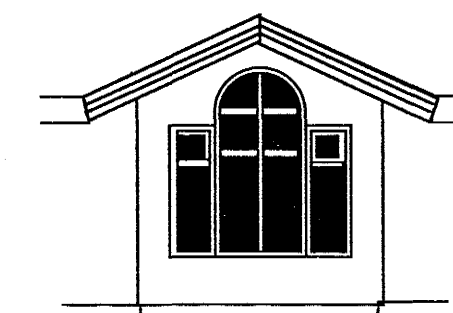



Samþykkt þann

20 JÚNÍ 2001

Byggingafulltrúinn í Hafnarfirði  
F.h. Sigurbjartur Halldórsson

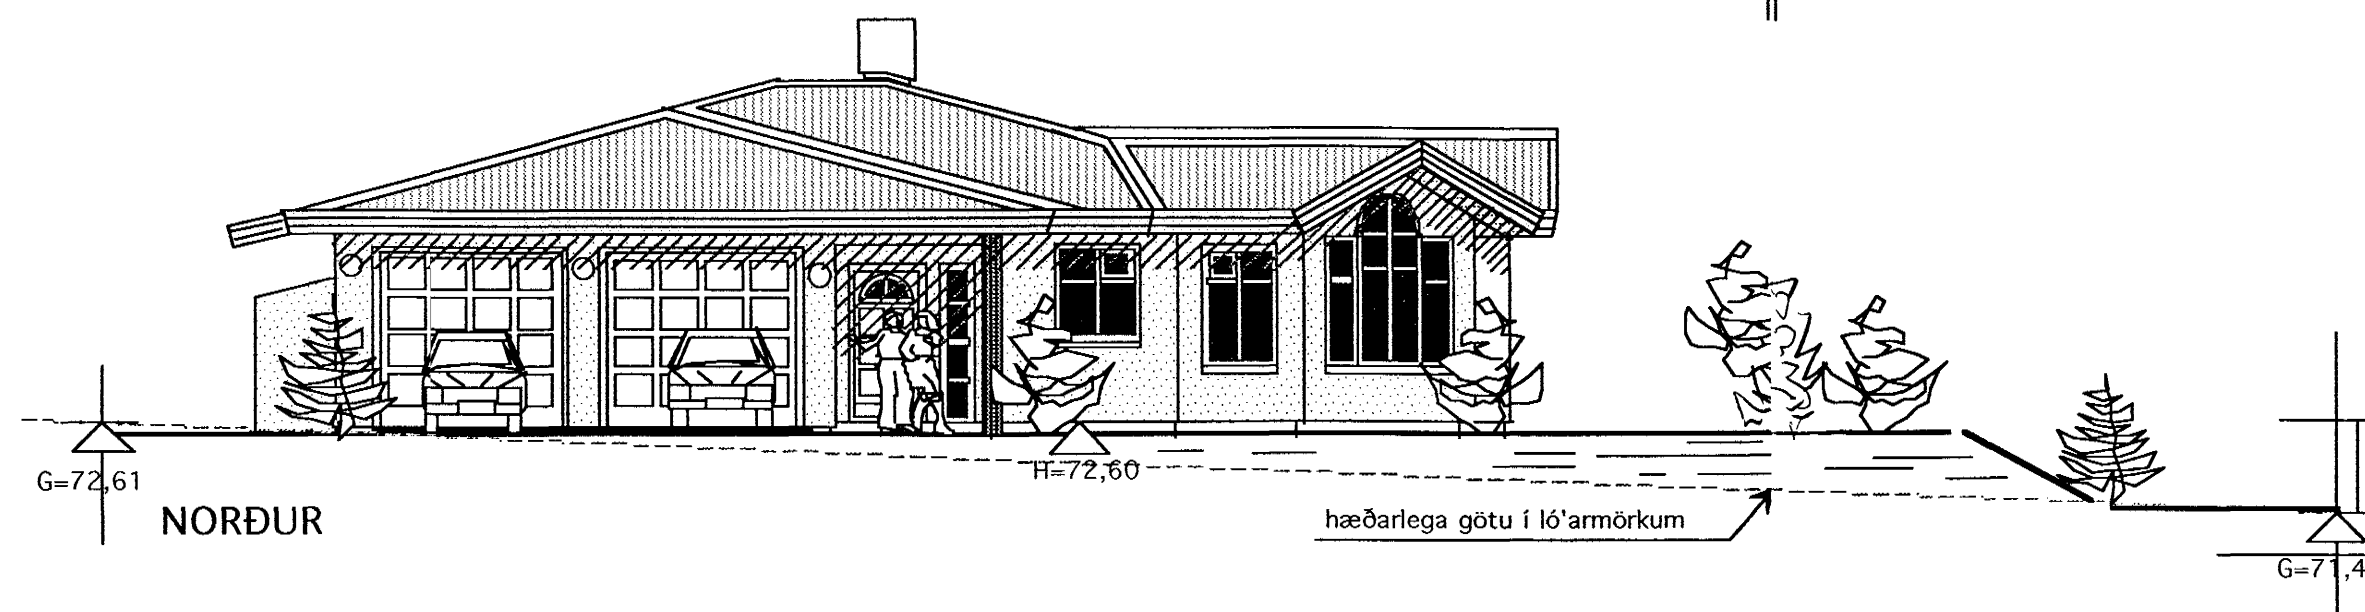

Ásýnd útbygging eldhús

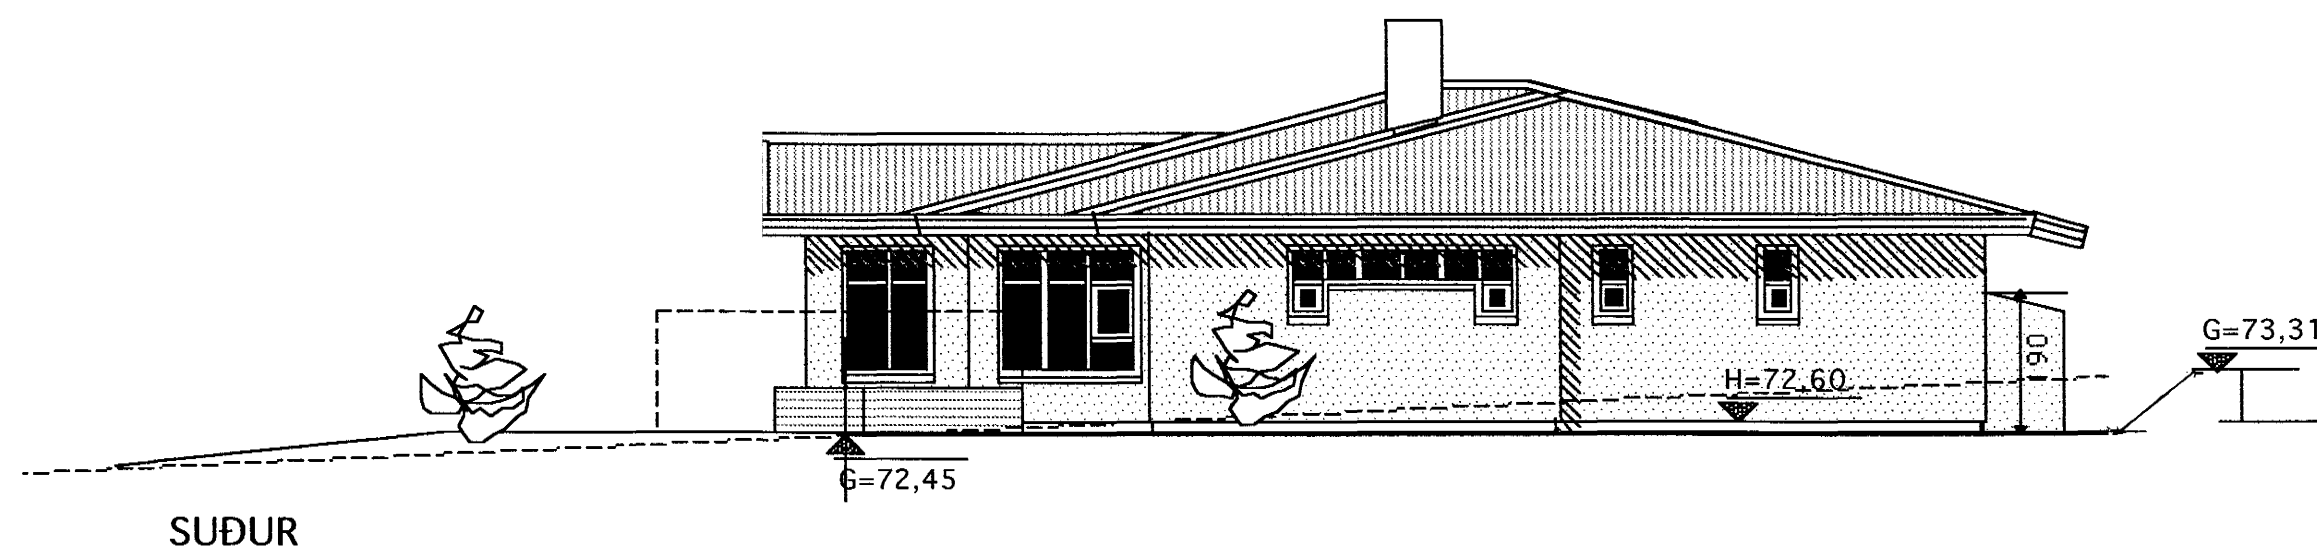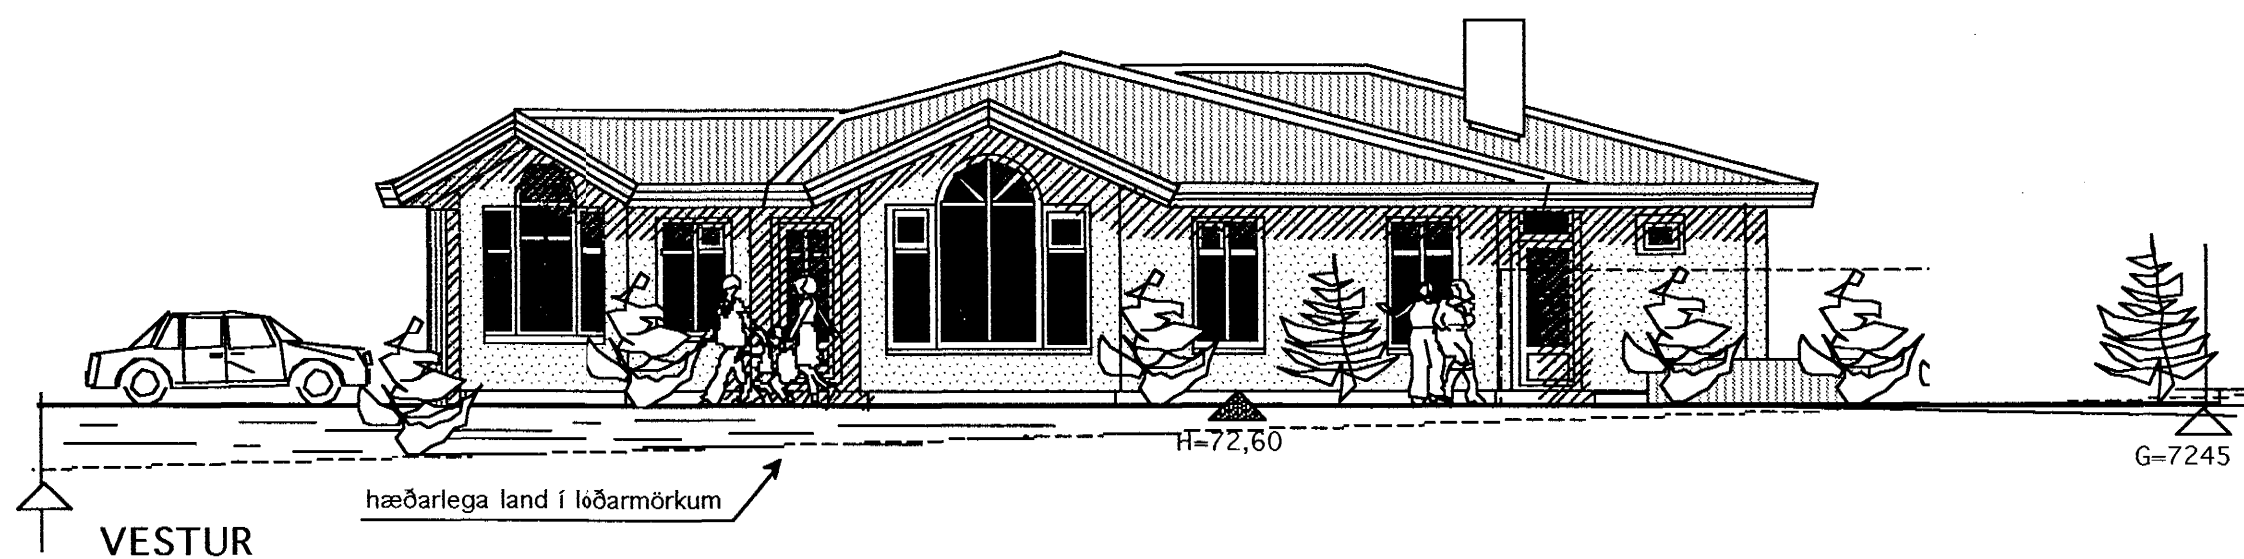

BREYTT 12 JÚNÍ 2001  
Samkv. minnisþúktum S.H dags. 31.05 2001



Verkefni  
SVÖLUÁS 34  
HAFNARFIRÐI

Heiti  
ÚTLITSMYNDIR

kvarði	1:100 1:500	verk.nr	200110
dags.	20 MAÍ. 2001	dags br.	12 JÚNÍ. 2001
hönnun	G. G.	teikn nr	A-3
teikn	G. G.		

Hringbraut 17 220 Hafnarfirði  
s. 555-2020 FAX 555-2021  
Gisli G. Gunnarsson BFI kt. 020649-2409

*G. Gunnarsson*