

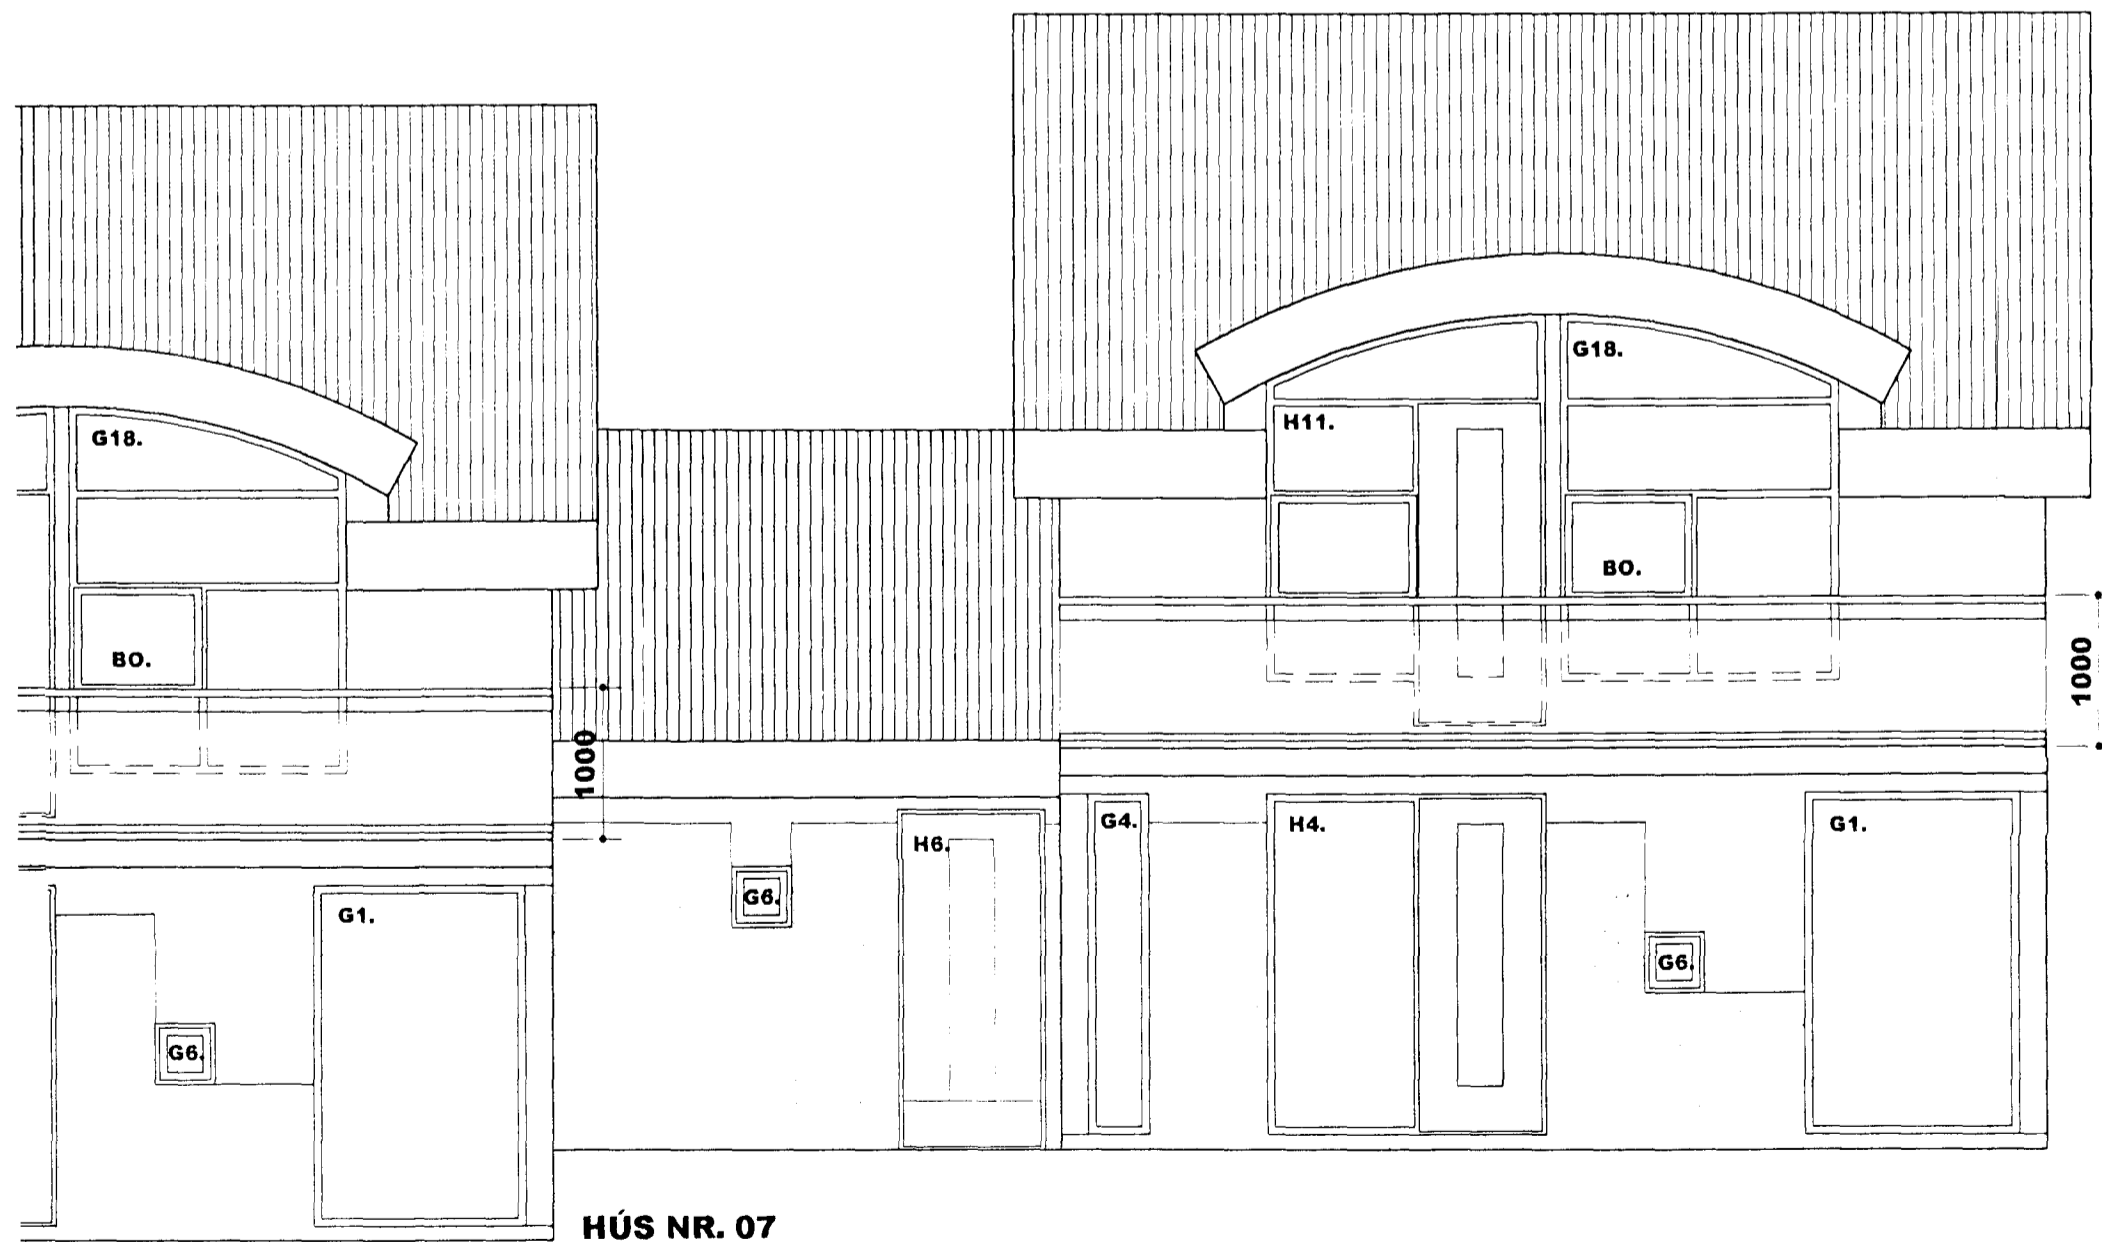


HÚS NR. 11
VESTUR.

HÚS NR. 09

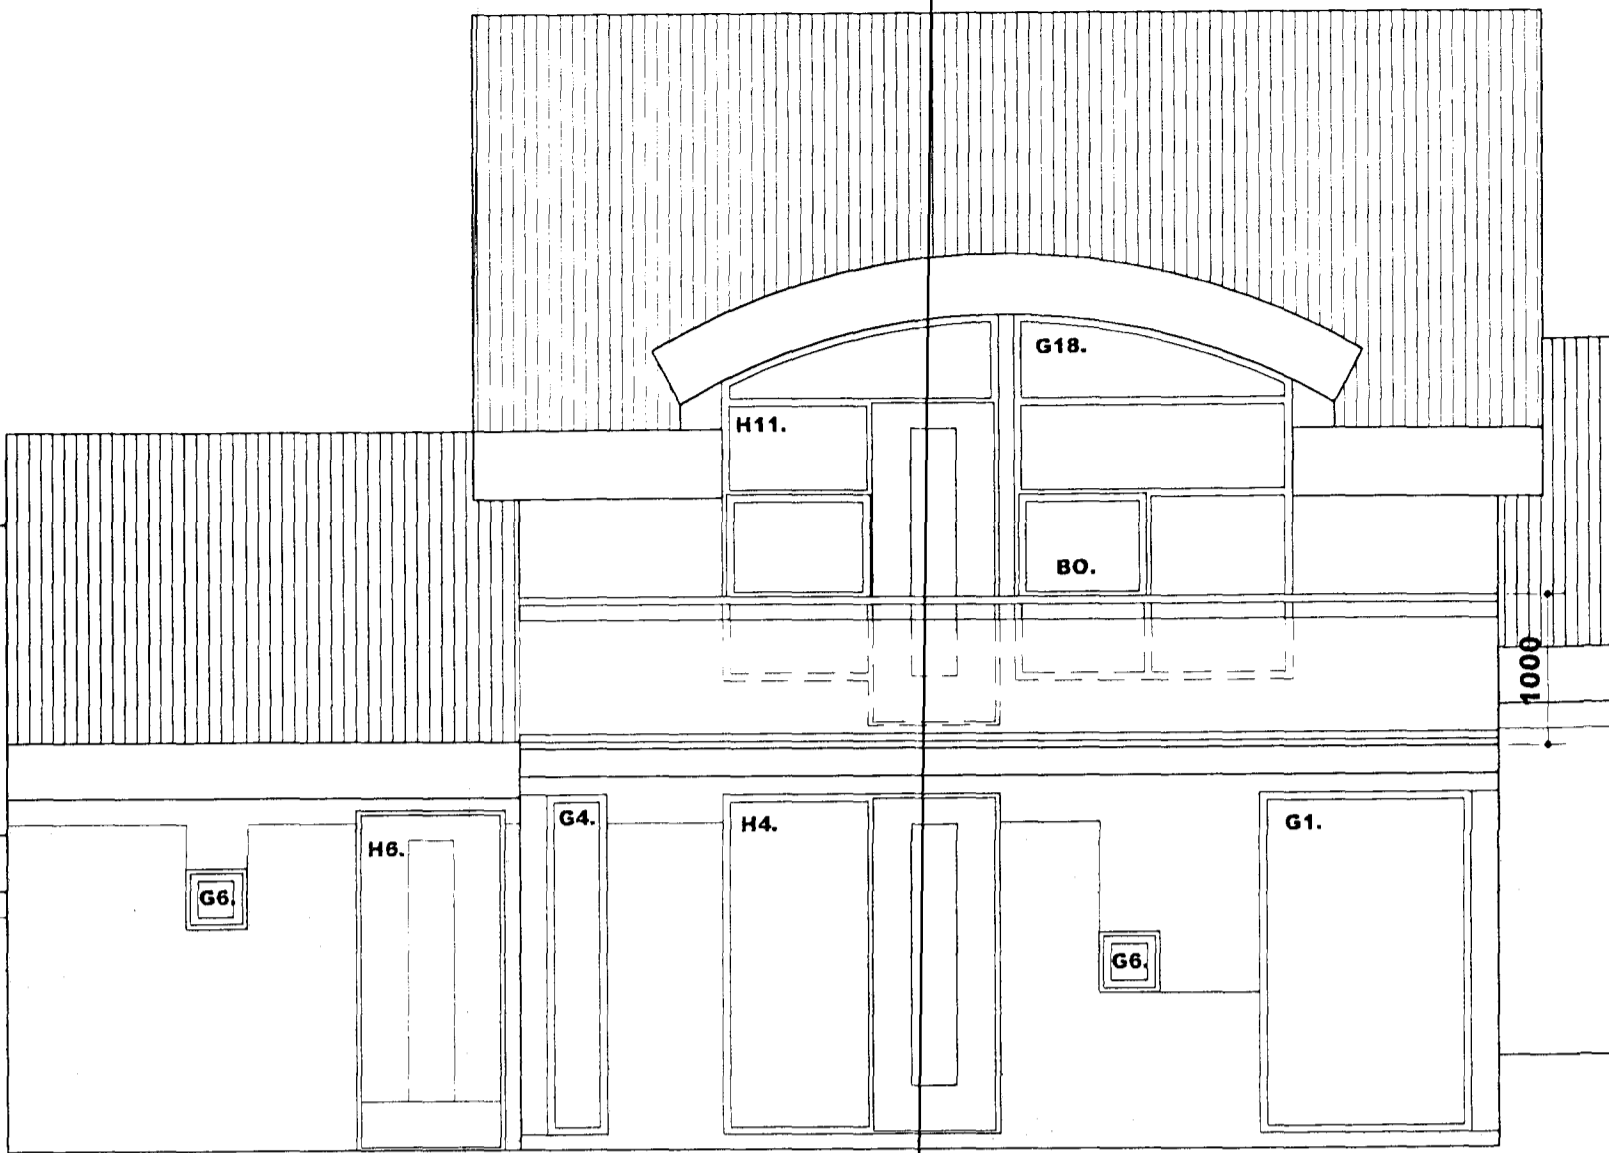

HÚS NR. 07

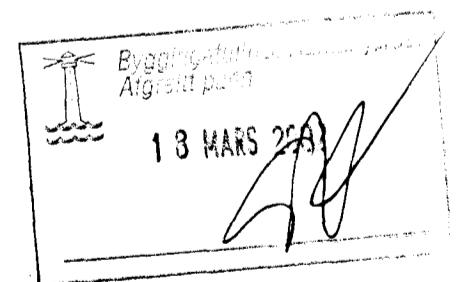

20.02.02 BREYTING: HÆÐ Á GLUGGUM OG HURÐUM.
STÖÐVEGGUR Í LÓÐARMÖRKUM SJÁ TEIKN. 04/10

HEITI: RÁÐHÚS VIÐ SVÖLUÁS 07, 09 OG 11, 220 HF.

HANNAÐ: HÓMEIRA GHARAVI ÞORGEIR ÞORGEIRSSON

DAGS: 20.02.02 MKV: 1:50 TEIKN.NR.12 / 18 VERKEFNI NR.0107150

SAMPYKKT: KENNITALA: 240657-5469

BYGGINGAR OG SKIPULAGSHÖNNUN ehf. kt:501000-2050 VSK:24965
SUDURLANDSBRÁUT 10, 108 REYKJAVÍK. S/ F: 588.8890 teiknistofan@tal.is

