





Samþykkt þann
 23 JULI 2003
 Byggingafulltrúinn í Hafnarfirði
 F.h. Sigurbjartur Halldórsson

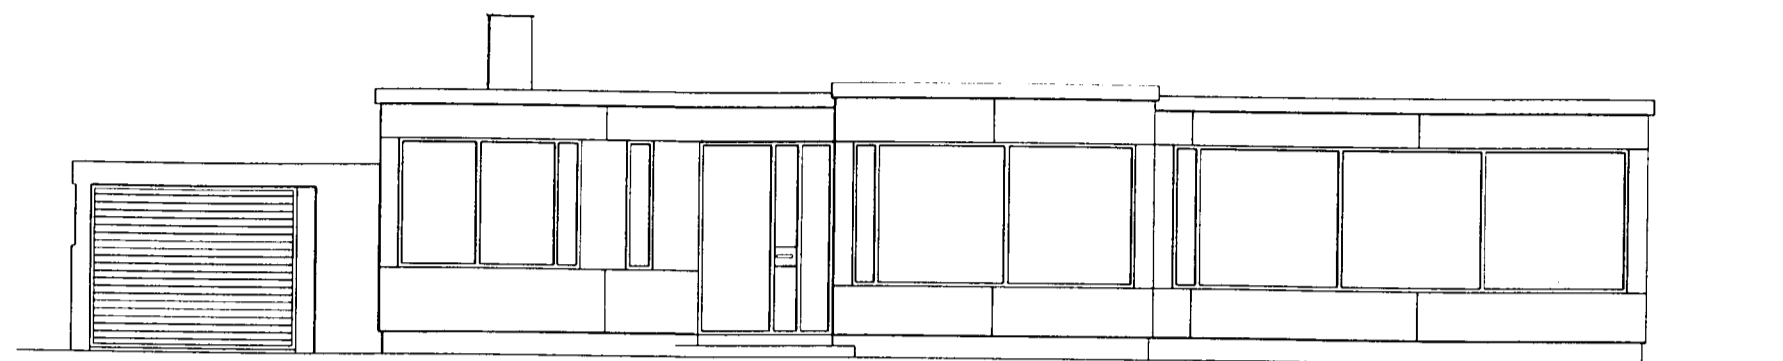


SUDUR



AUSTUR

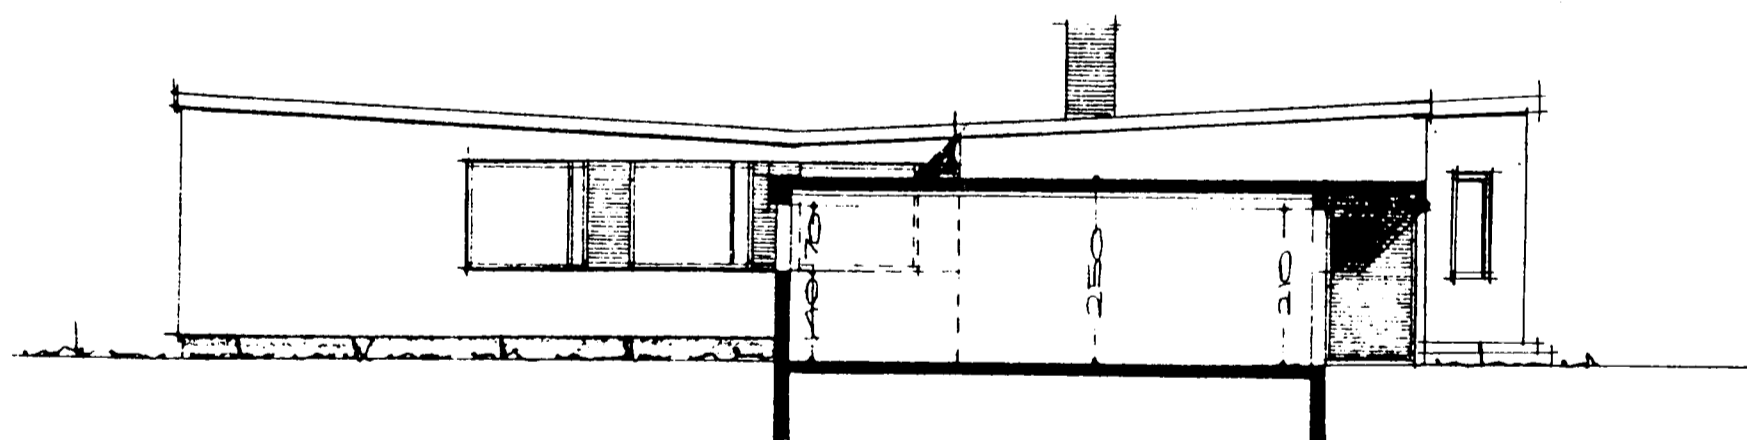

VESTUR

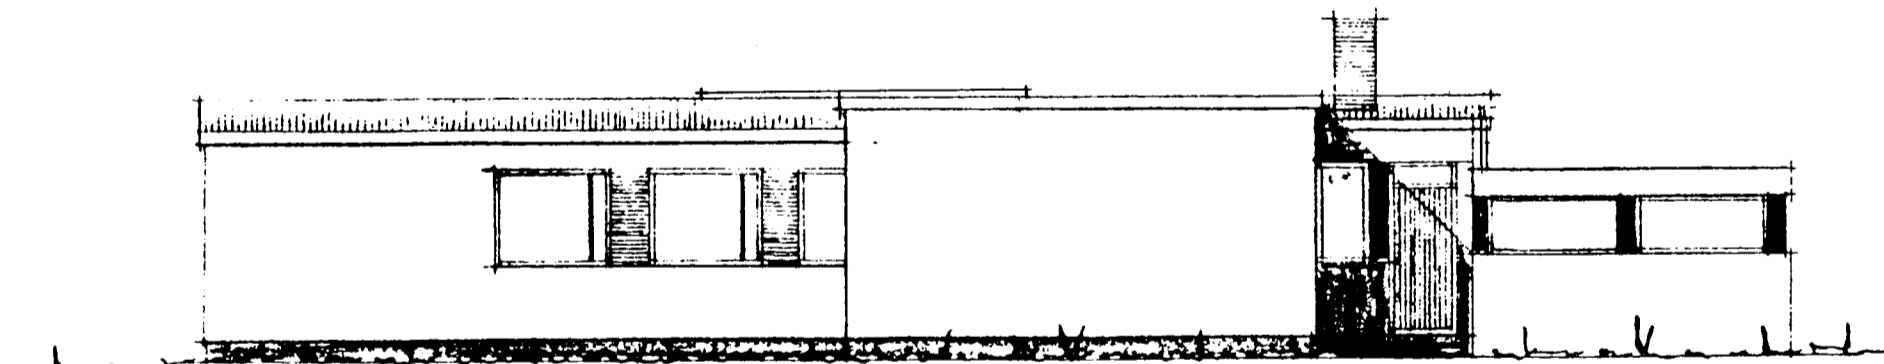

NORÐUR

Breyting: Suðurhlíð klædd með STENI-klæðningu, 7. júlí 2003 - P.Ól.

SVÖLUBRAUN 10

KVARDI : 1:100
 DAGS : 1. 6. 80
 VERKNA :
 TEIKNNA :

UNNID : P.Ól.

Breyting á anddyri og skála.

Ótlit.

Arkitektar
 Pálmar Ólason og
 Einar Ingimarsson

Vinnustofa Lynghólsí 3
 110 Reykjavík
 Sími 672 772, fex 672 781

Einar Ingimarsson *Pálmar Ólason*

TEIKNUN SF
 ARKITEKTASTOFA
 FELLSMULA 26
 105 R, S.82022

REYKJAVÍK 1 MAÍ 1988
Þjartan Sveinsson