
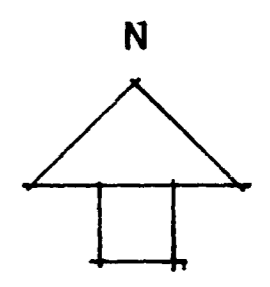


tifftopdf - www.rubissoftware.com - Demo Version

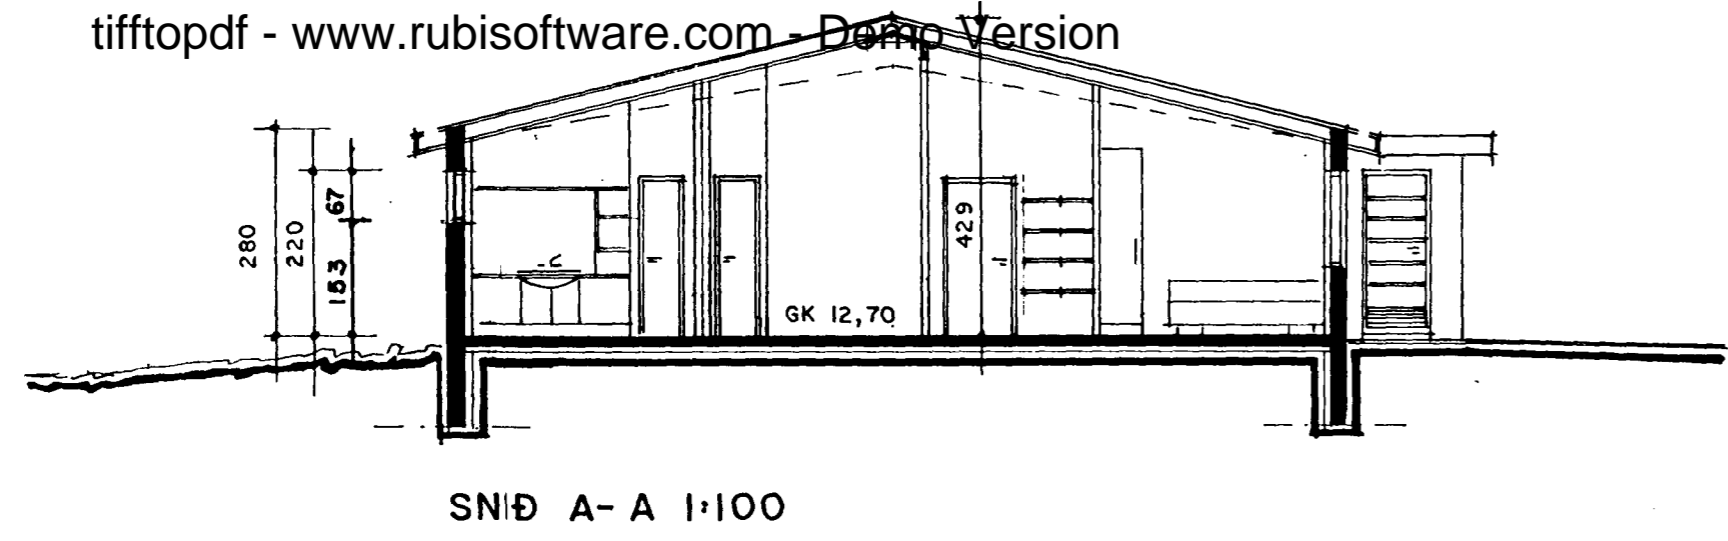

Skráningartafa: Teigabyggð Hafnarfirði				Skrásetjari: Sigurður Hafsteinsson													
Landnúmer: 178109				Kennitala: 030859-7749													
Matshlutanúmer: 01				Dags.: 25.1.1999													
Uppskipting og lýsing				Stærðir													
D0	D1	D2	D3	D4	D5	D5M	D6	D7	D8	D9	D10a	D10b	D11	D12	D16	D17	
Lokun	Rým hæð	Nokun ítt	HÖLUS Rokun	Eignar-hæð	Borðflur m²	Mítflur m²	Skipr m²	Op m²	Brúflur m²	Brúflur sk = 1,8	Salméð min	Salméð max	Brúflur rúmfl. m²	Neroflur m²	Birt fl. í m²	Reiniss. skiptunumál	Skiptunumál m²
					178,8	0,0	0,0	0,0	178,8	0,0			662,3	154,9	178,8		545,2
													35,8				
	01	1. hæð			178,8	0,0	0,0	0,0	178,8	0,0			626,5	154,9	178,8		545,2
A	0101	IBUD	N	0101	148,4				148,4		2,80	4,30	524,9	127,9	148,4		452,4
A	0102	BILSKUR	B	0101	30,4				30,4		2,80	4,20	101,6	27,0	30,4		90,2
B	0103	SORP	T	0101	2,4				2,4		1,80	1,80	4,3				2,6

BREYTT: GLUGGUM, INNRA SKIPULAGI OG HÆÐARKÖTA.

MKV. 1:100	TEIGABYGGÐ 5 HAFNARFIRÐI.	DAGS. FEB. 1999.
	SNID 1:100 AFSTÖÐUMYND 1:500 SKRÁNINGARTAFLA	BREYTT: 1.5.1999
	GÚSTAF B. ÓLAFSSON, M.B.F. KT. 200759 - 7619.	NR. 3