


PRASTAHRAUN 5 HAFNARFIRÐI
9700-0050-01

Upphaf. sp. 9/10 '63


Bygging
19.9.1984
BYGGINGARFRÆÐINGUR
Í HAFNARFIRÐI
Erlendur Árnir Hjálmarsson

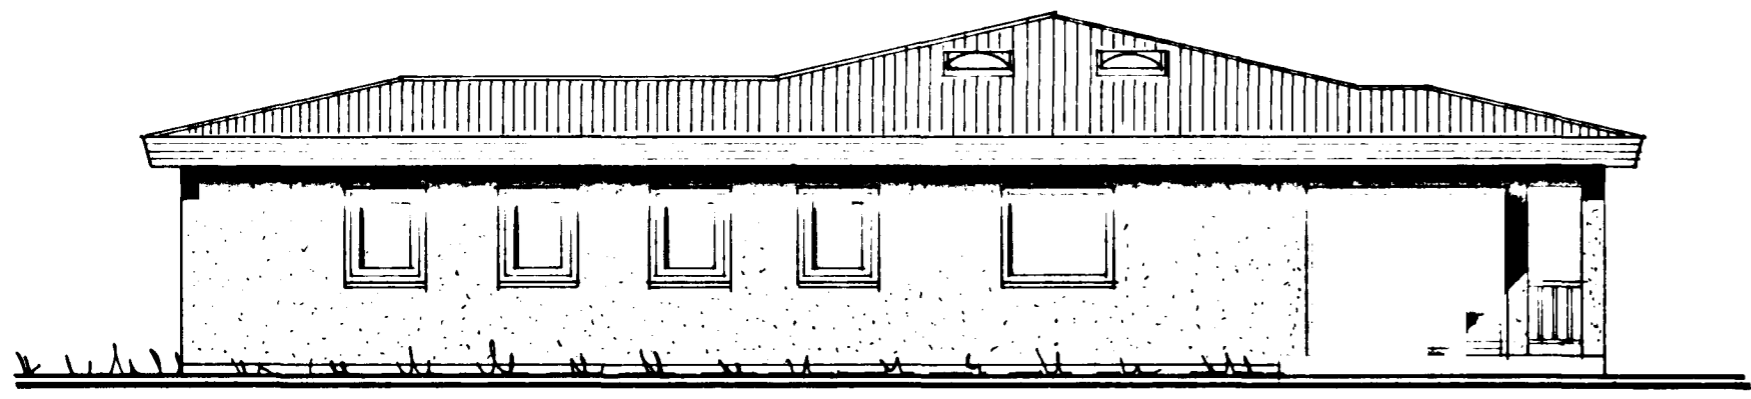


NORÐ-AUSTUR M=1:100



NORD-VESTUR M=1:100

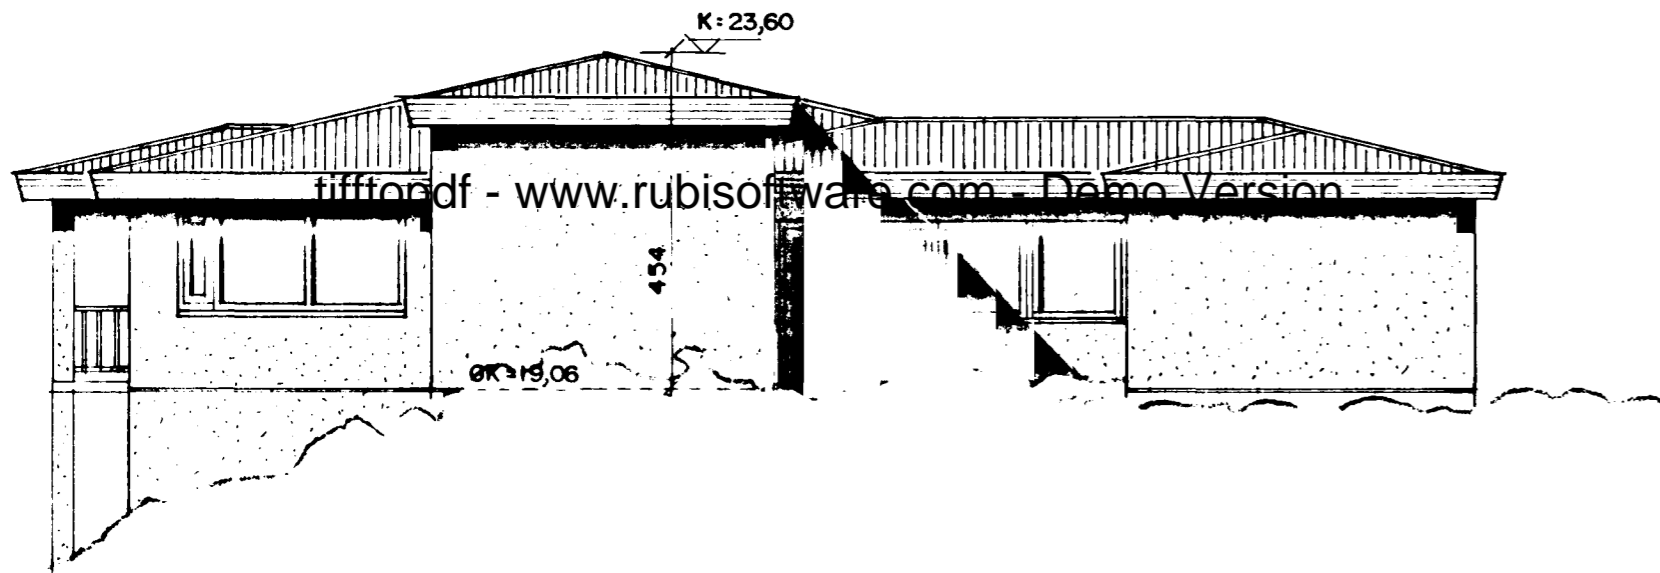


SUÐ-VESTUR M=1:100

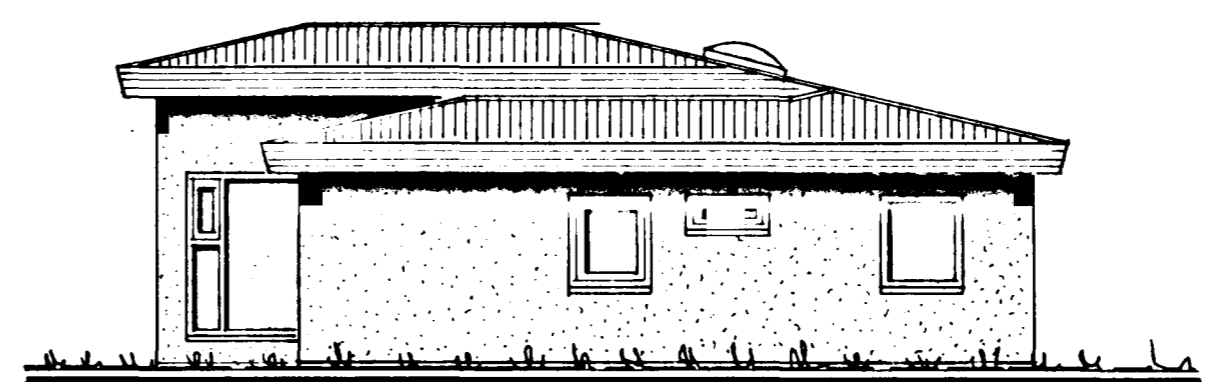


SUD-AUSTUR M=1:100


ST/ERDIR	M ² BR	M ³ BR
I. HÆÐ	150	510
KJALLARI	51,3	138,5
SAMT	201,3	648,5

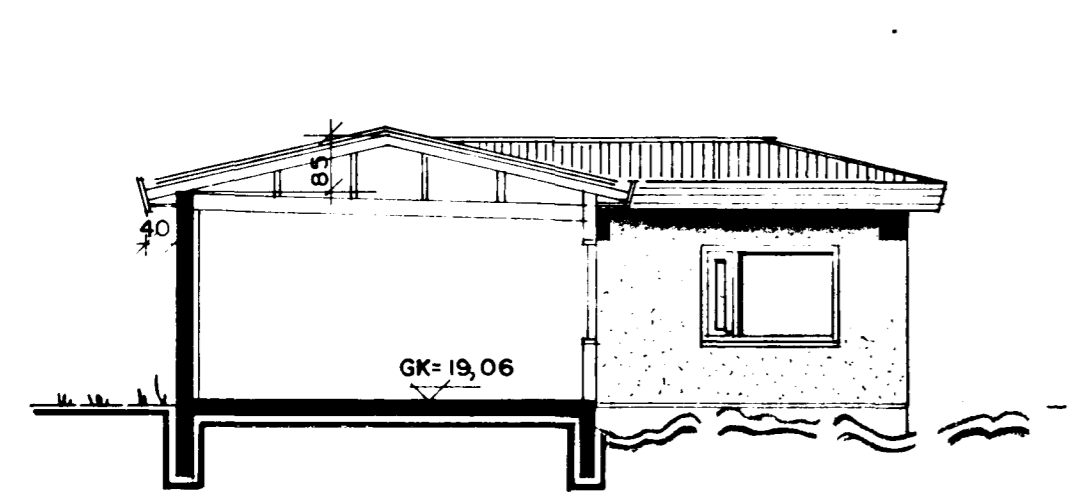

SNEIDING A-A M=1:100

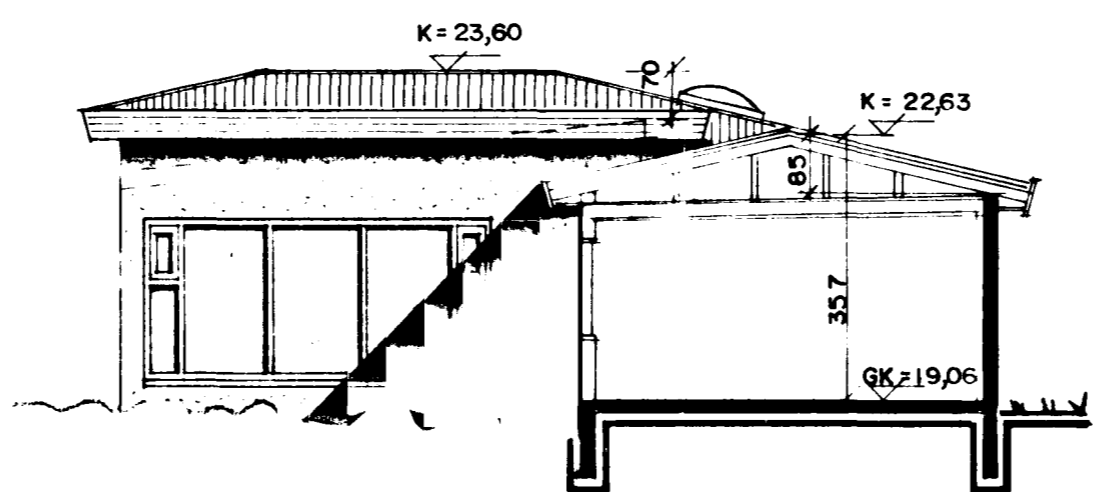

SNEIDING B-B M=1:100

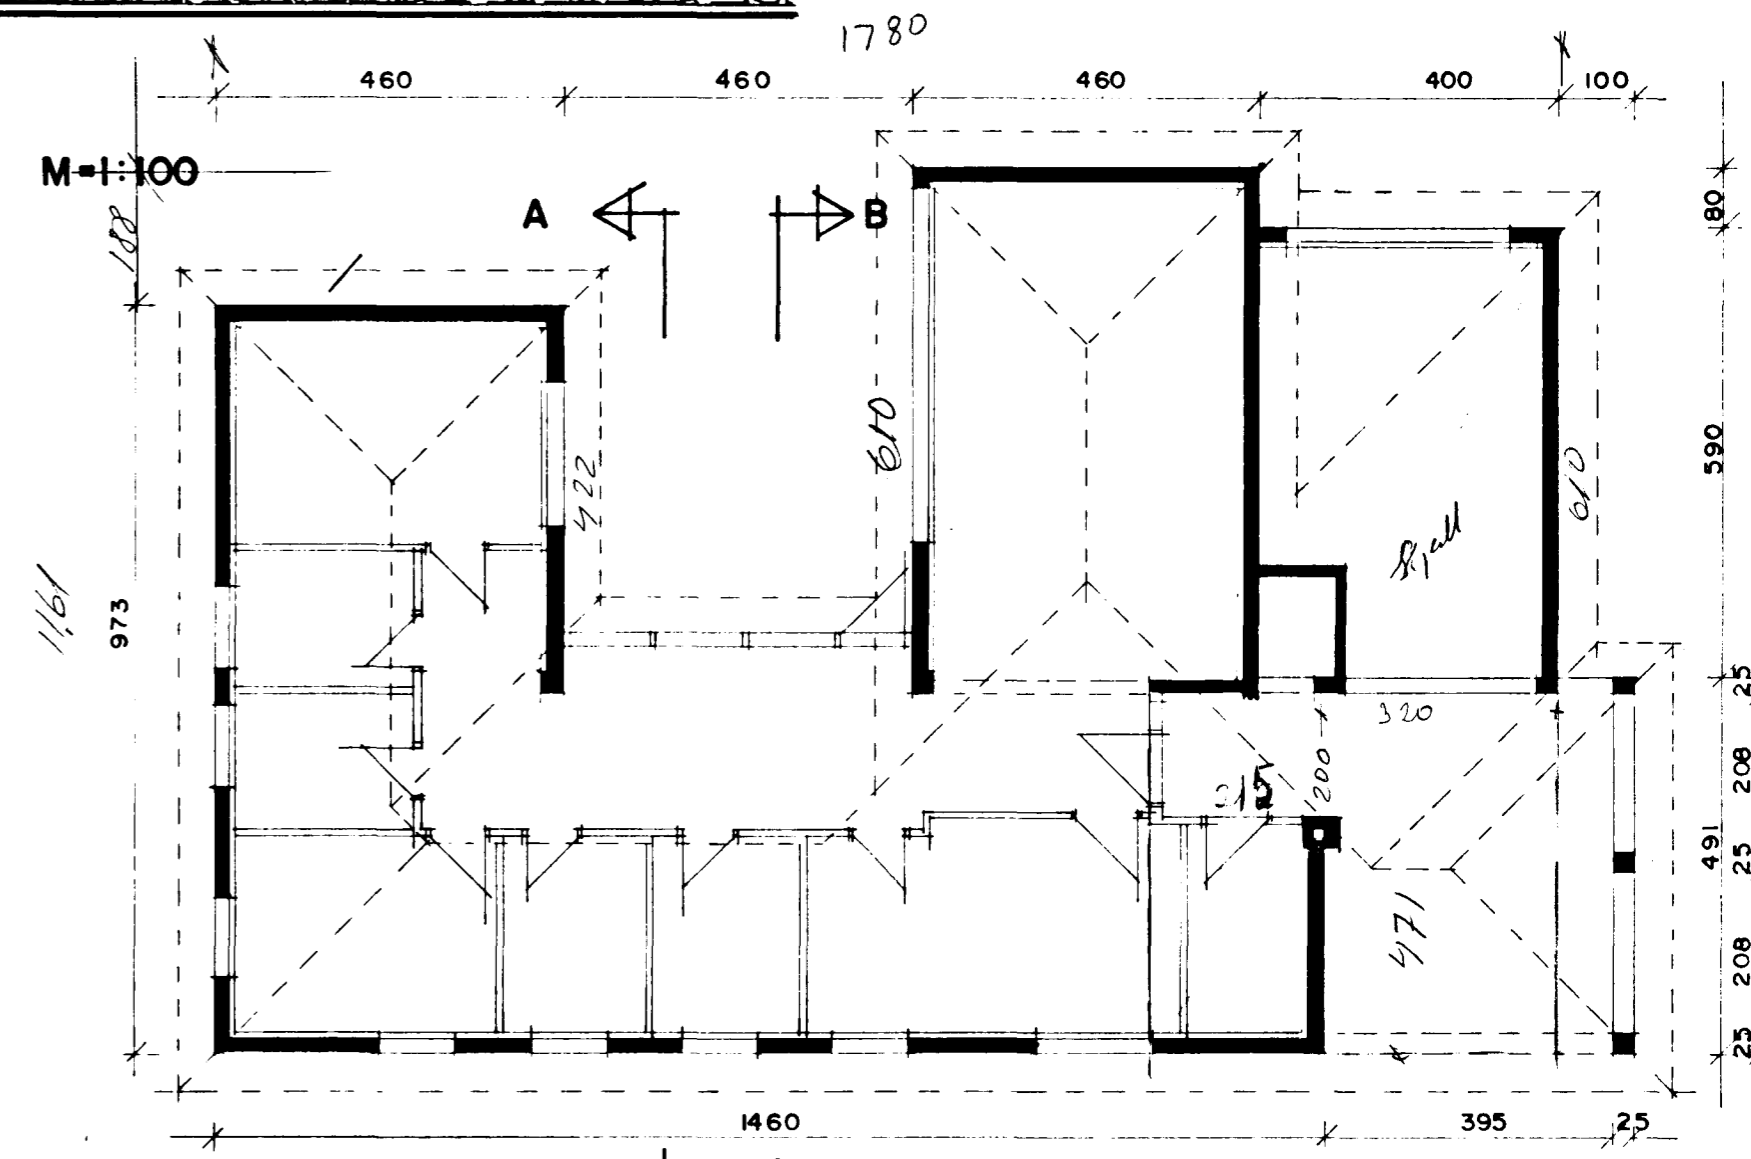

GRUNNMYND M=1:100

Erlendur Árnir Hjálmarsson