

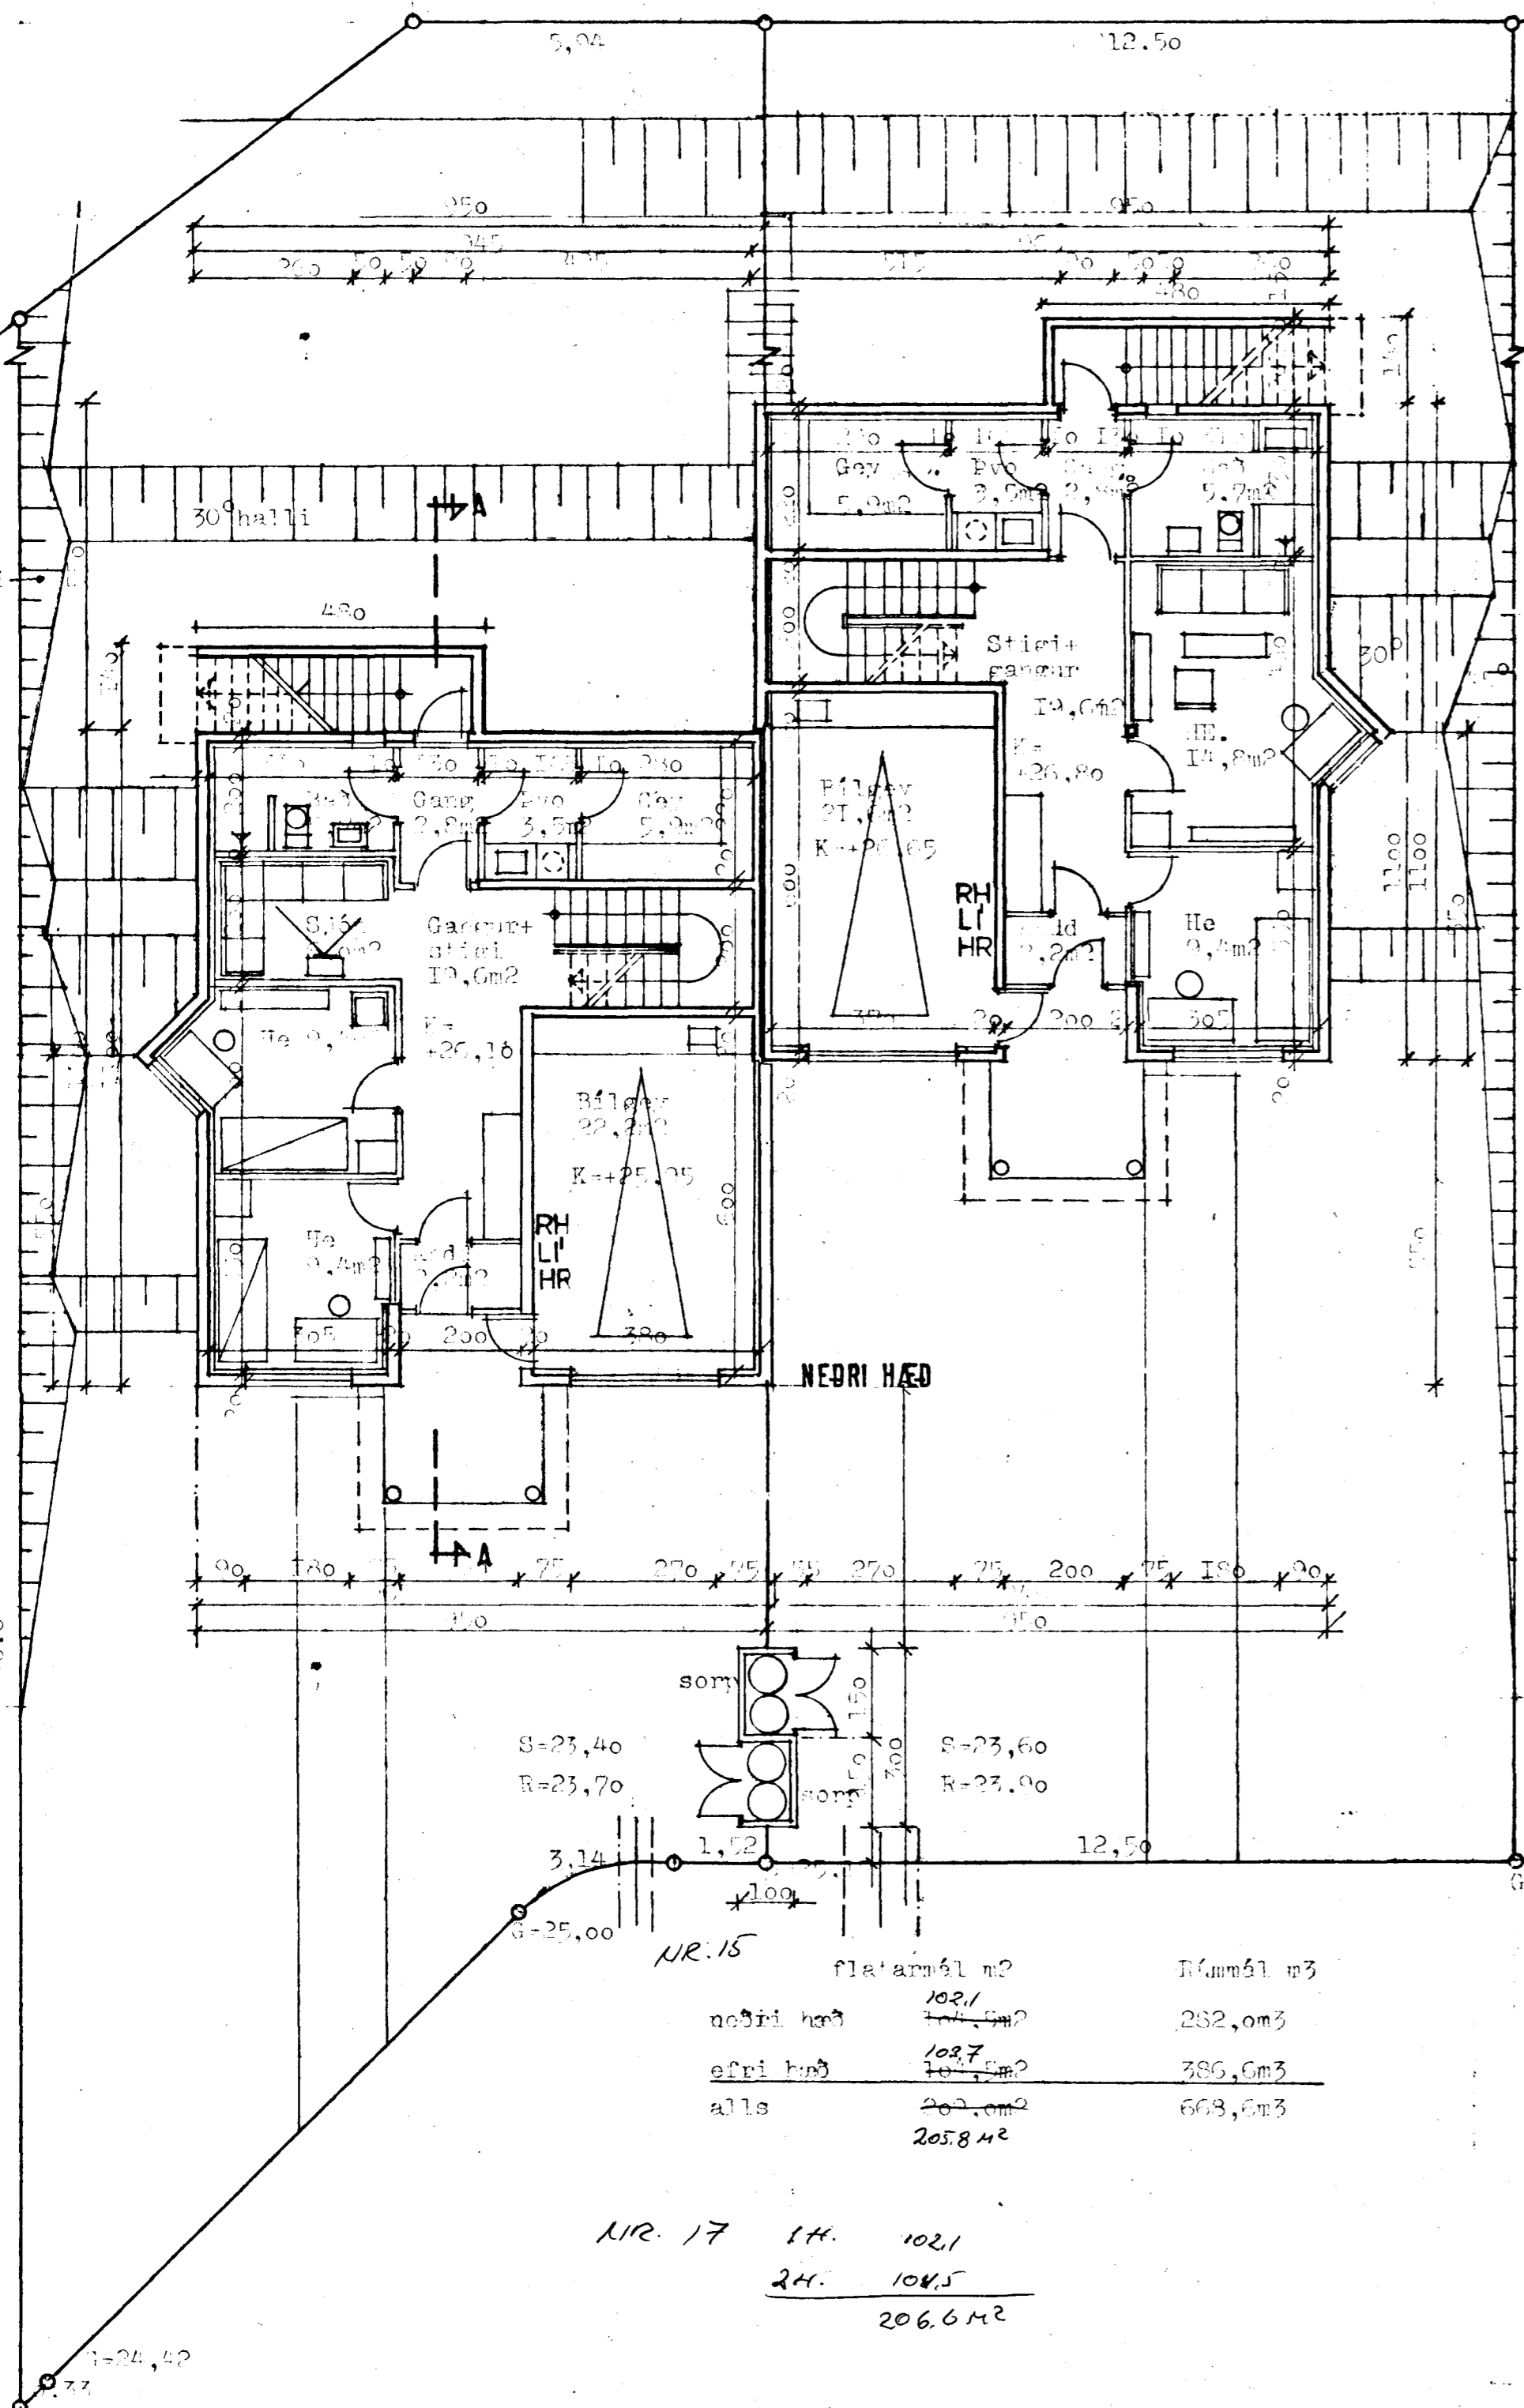


Samþykkt á fundi bygginga-
nefndar þ. 8.16.1989
BYGGINGAFULLTRÚINN
Í HAFNARFIRDI

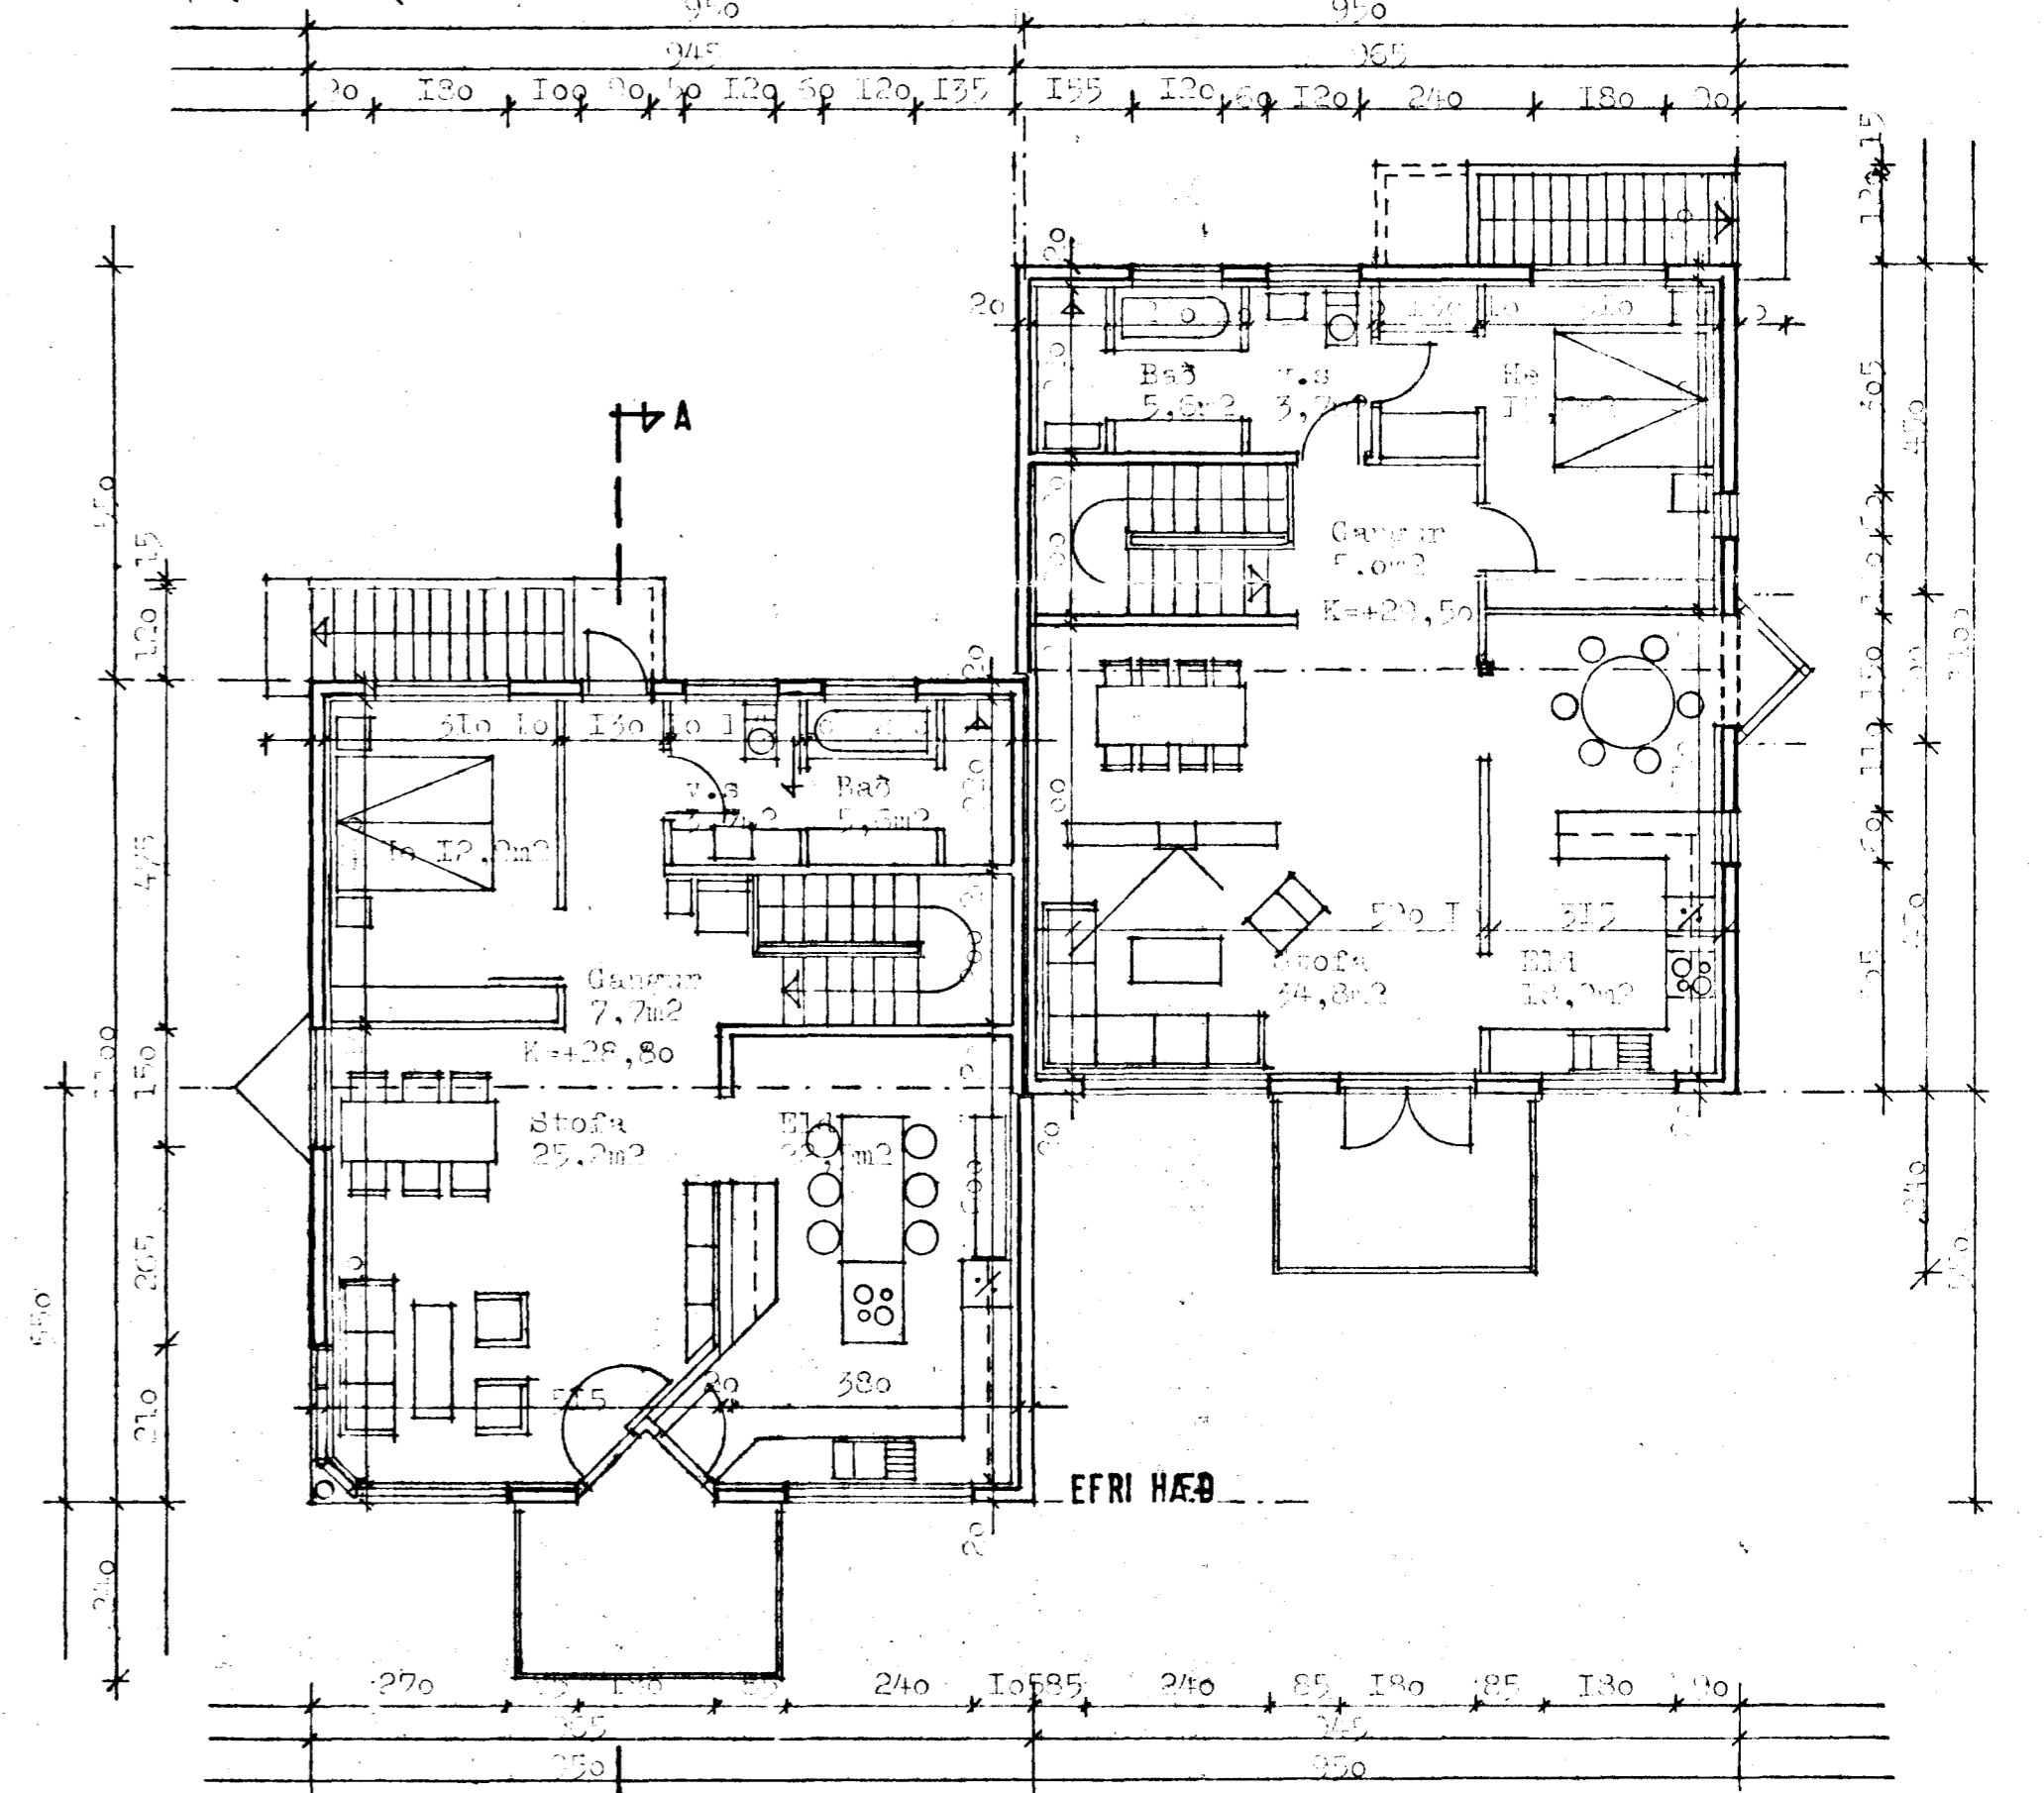

	fláarmál m ²	Rúmmál m ³
neðri hæð	1021	262,0m ³
efri hæð	1027	386,6m ³
alls	2058 m ²	668,6m ³

NR.	1H.	2H.	alls
NR. 17	1021	1045	2066 m ²

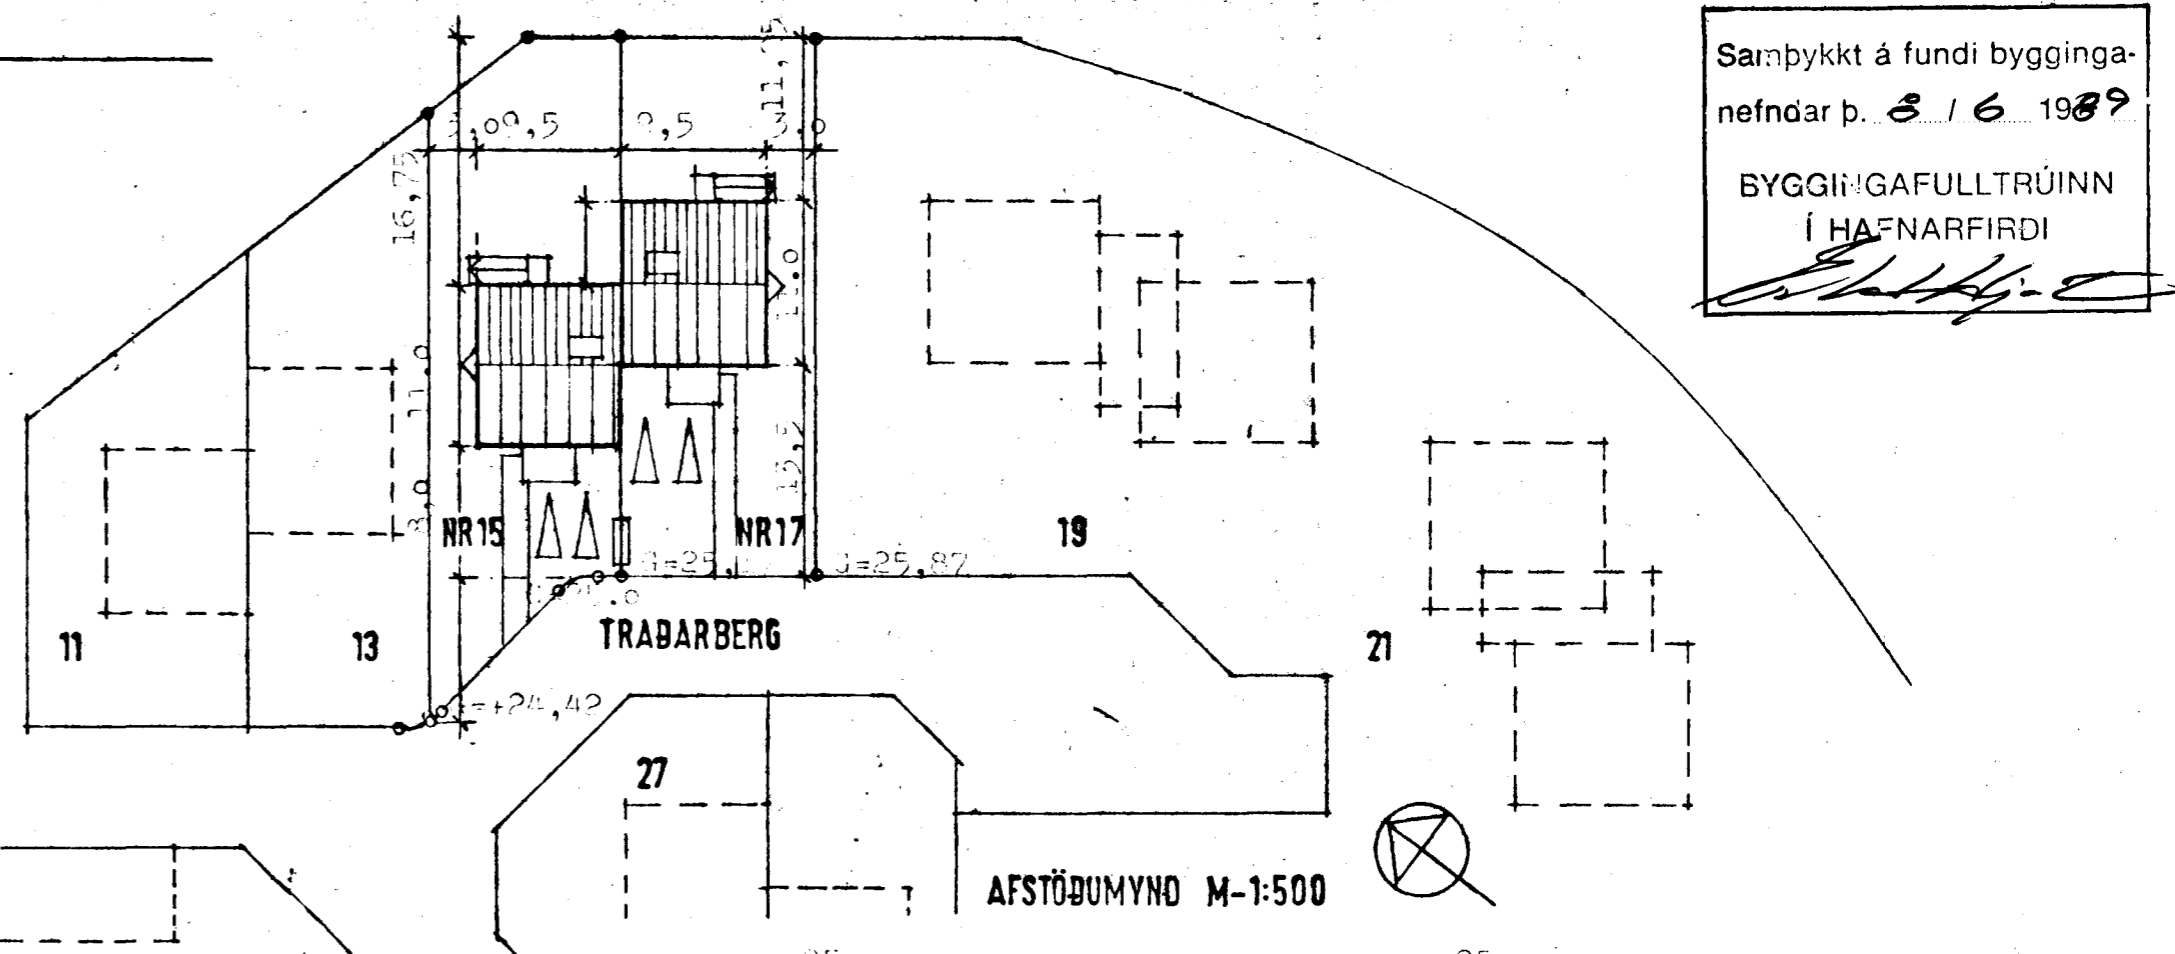

TRABARBERG 15-17 HAFNARFIRDI

Byggingarrit. Afstöðumynd
1:500 20.03.1989
mkv. 1:100 dags: 1989 teikn. bl. 01
SIGURÞÓR ABALSTEINSSON ARKITEKT FAI

Guðrún Atalsteinsdóttir