


GRUNNMÝND 1:50

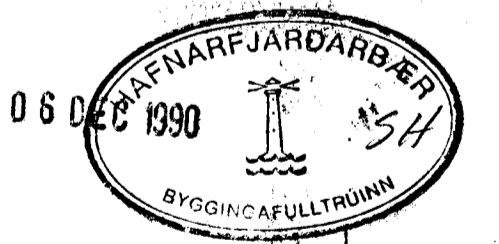

01	3-12-90	BR Á LEGU LAGNA	CH
BR.NR	DAGS	EDLI BREVTINGAR	SIGN.
TRÆÐARBERG 5 HAFNARFIRÐI			DAGS MARS '90
HITA-VATNS OG FRÆNNISLI SLAGNIK.			HAUNAS EY
MELJKV. 1:50			TEKNAÐ EY
SIGURÐUR ÞORLEIFSSON TEKNIFRÆÐINGUR F.M.F.I.			VERK NR 8947
STRANDGÖTU 11 HAFNARFIRÐI SÍMI 54751			BLAÐNR. 2-05