

NR.1-06

NR.1-07

NR.1-08

NR.1-08

NR.1-10

AD. MELAGRIND
Á 1.HÆÐ

NR.1-05

Úr Gildi


NR.1-04

VINNUSALUR

NR.1-11

NR.1-03


NR.1-19
NR.1-17

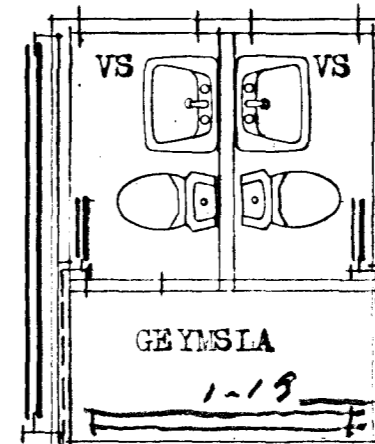

NR.1-18

NR.1-12

Handwritten note: JAGGT 25/11/87

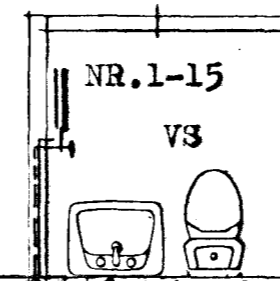

NR.1-16

NR.1-13A

NR.1-02

NR.1-01

NR.1-14

BAKRENNSLI í FRÆRENNSLI
Á 1.HÆÐ

NR.1-13

Official stamp: 7. JUNÍ 1987, BYGGINGARDEIÐI, HAFNARFIRÐI

STEINGRIMUR TH. ÞORLEIFSSON MTFB TEIHNSTOFU - ARMULA 3 - Sími 322 40		
VENJ. TRÖNDRÁUN NR. 10 HAFNARFIRÐI		
MAÞ	1:50	HITALAGNIR -GRUNNMÝND 2.HÆÐAR
DAGS	JUNÍ.-1987	
BLAÐ	2	<i>Handwritten signature: Steingrímur Th. Þorleifsson</i>
SPRITT		