
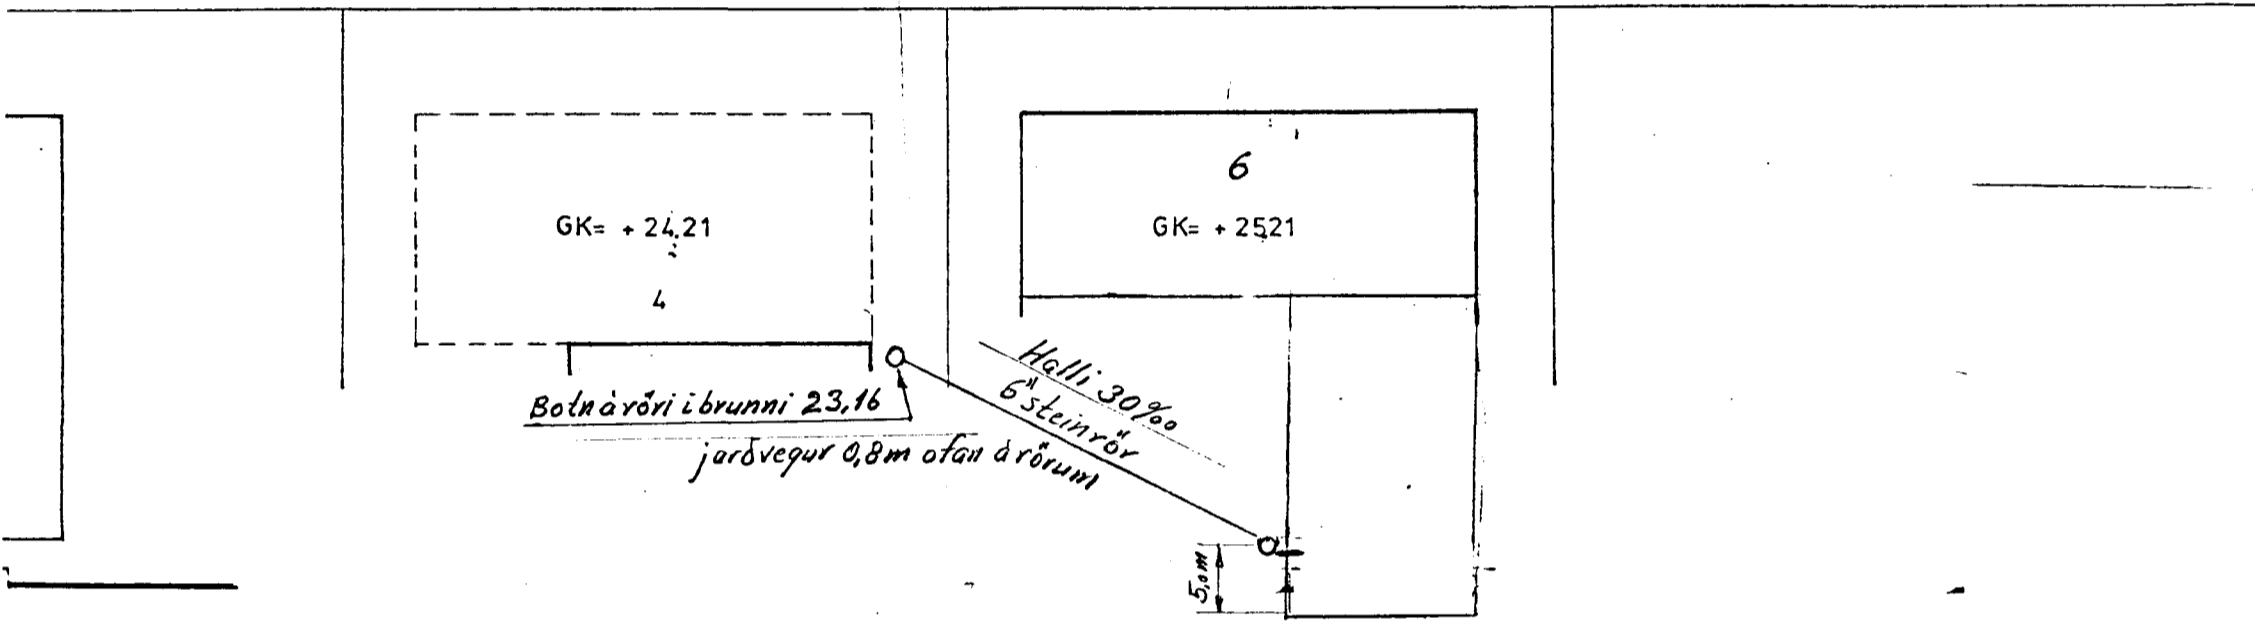



52,50	62,50	128,00	160,00
22,39	22,69	22,92	22,18

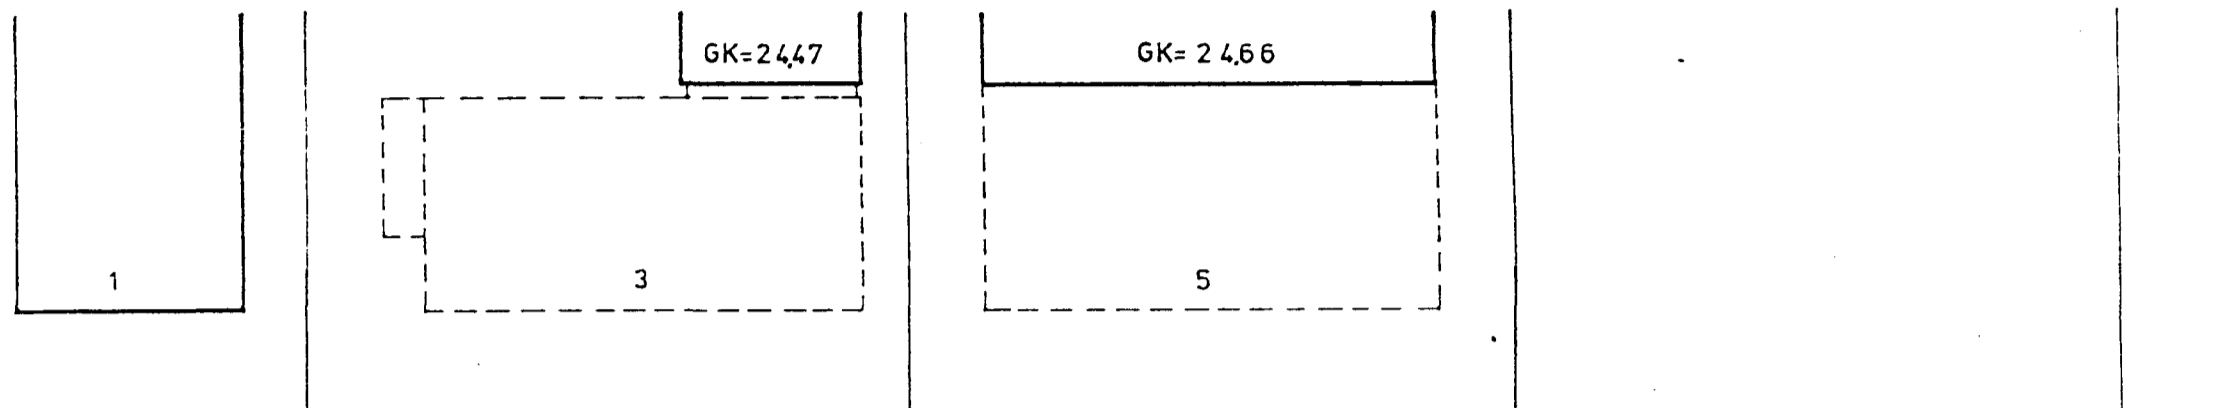

14. NOV. 1985

 Sigríður Smíla M=1:500

TRÖNUHRAUN 6
SKOLPLÖGN FRÁ ÁFANGA IV.
 Agúst G. Sigurðsson
 Teikni
 Hafnarfirdi 11.11.85. Teikn 125-85