
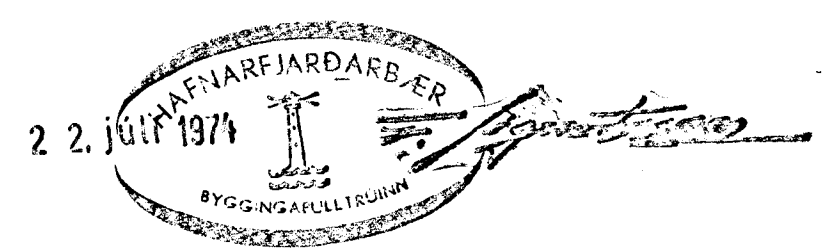


OFNA SEAL HIDA VIÐ HITAVERTU 440°C  
 Hæsta HED OFNA 740mm (M7 440).

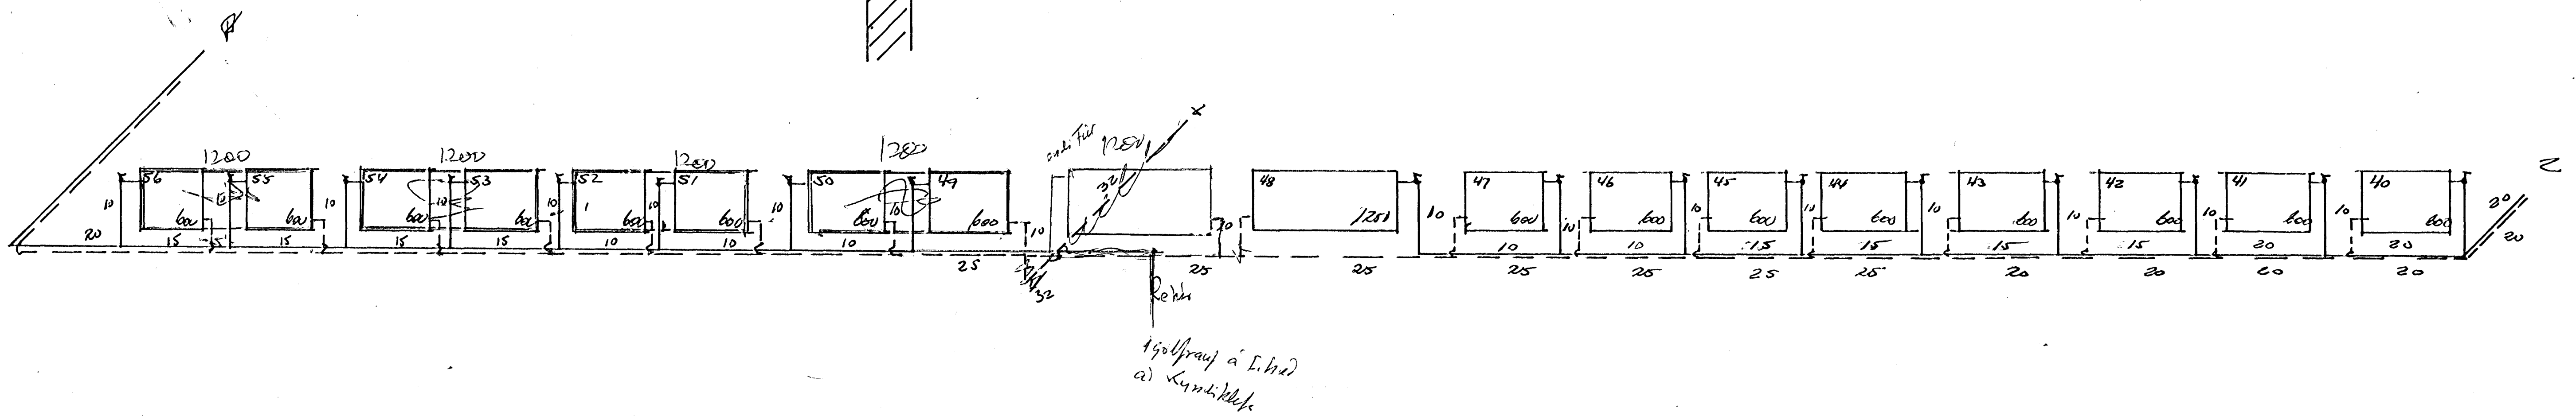

TRÖNDRUN 6 Hita laagnir	Telken.	Laib.
	Þegn.	2.12.72
Kolbeinn K.G. Jónsson Laknir.	Telken. Nr.	7231
	Bl.	6