

OFNASKRÁ $\Delta T 40^\circ C$


RUNTAZ

NR	HITATAP KCAL/T	OFN-PANEL	TENGI
1	1280	P4/740/960	A+B 10
2	490	P2/500/800	A+B 10
3	770	P2/590/1120	A+D 10
4	640	P4/300/1040	A+D 10
5	3700	P3/440/5840	C+B 15
6	1310	P3/590/1440	C+B 10
7	2200	P3/990/1440	A+D 10
8	570	P1590/1360	C+B 10
9	780	P2/590/1120	A+D 10
10	690	P1/590/1680	A+D 10
11	²³⁰ 870 (149)	¹⁶²⁰ P2/590/1280	A+D 10
12	³⁰⁰ 950 (120)	¹⁶⁹⁰ P2/590/1360	A+D 10
13	650	P1/590/1600	A+D 10
14	3100	P1/990/4480	A+D 15

VK77/2 - 2000
 V49/2 - 800
 V60 - 1600
 C14/2 - 2000
 VK35/2 - 5800
 VK60/2 - 1400
 C29/2 - 1400
 V63 - 1600
 V63 - 1400
 V63/2 - 1100
 V63/2 - 1500
 V60 - 1400
 V91 - 4700
 JSB.

570
Kd

2390

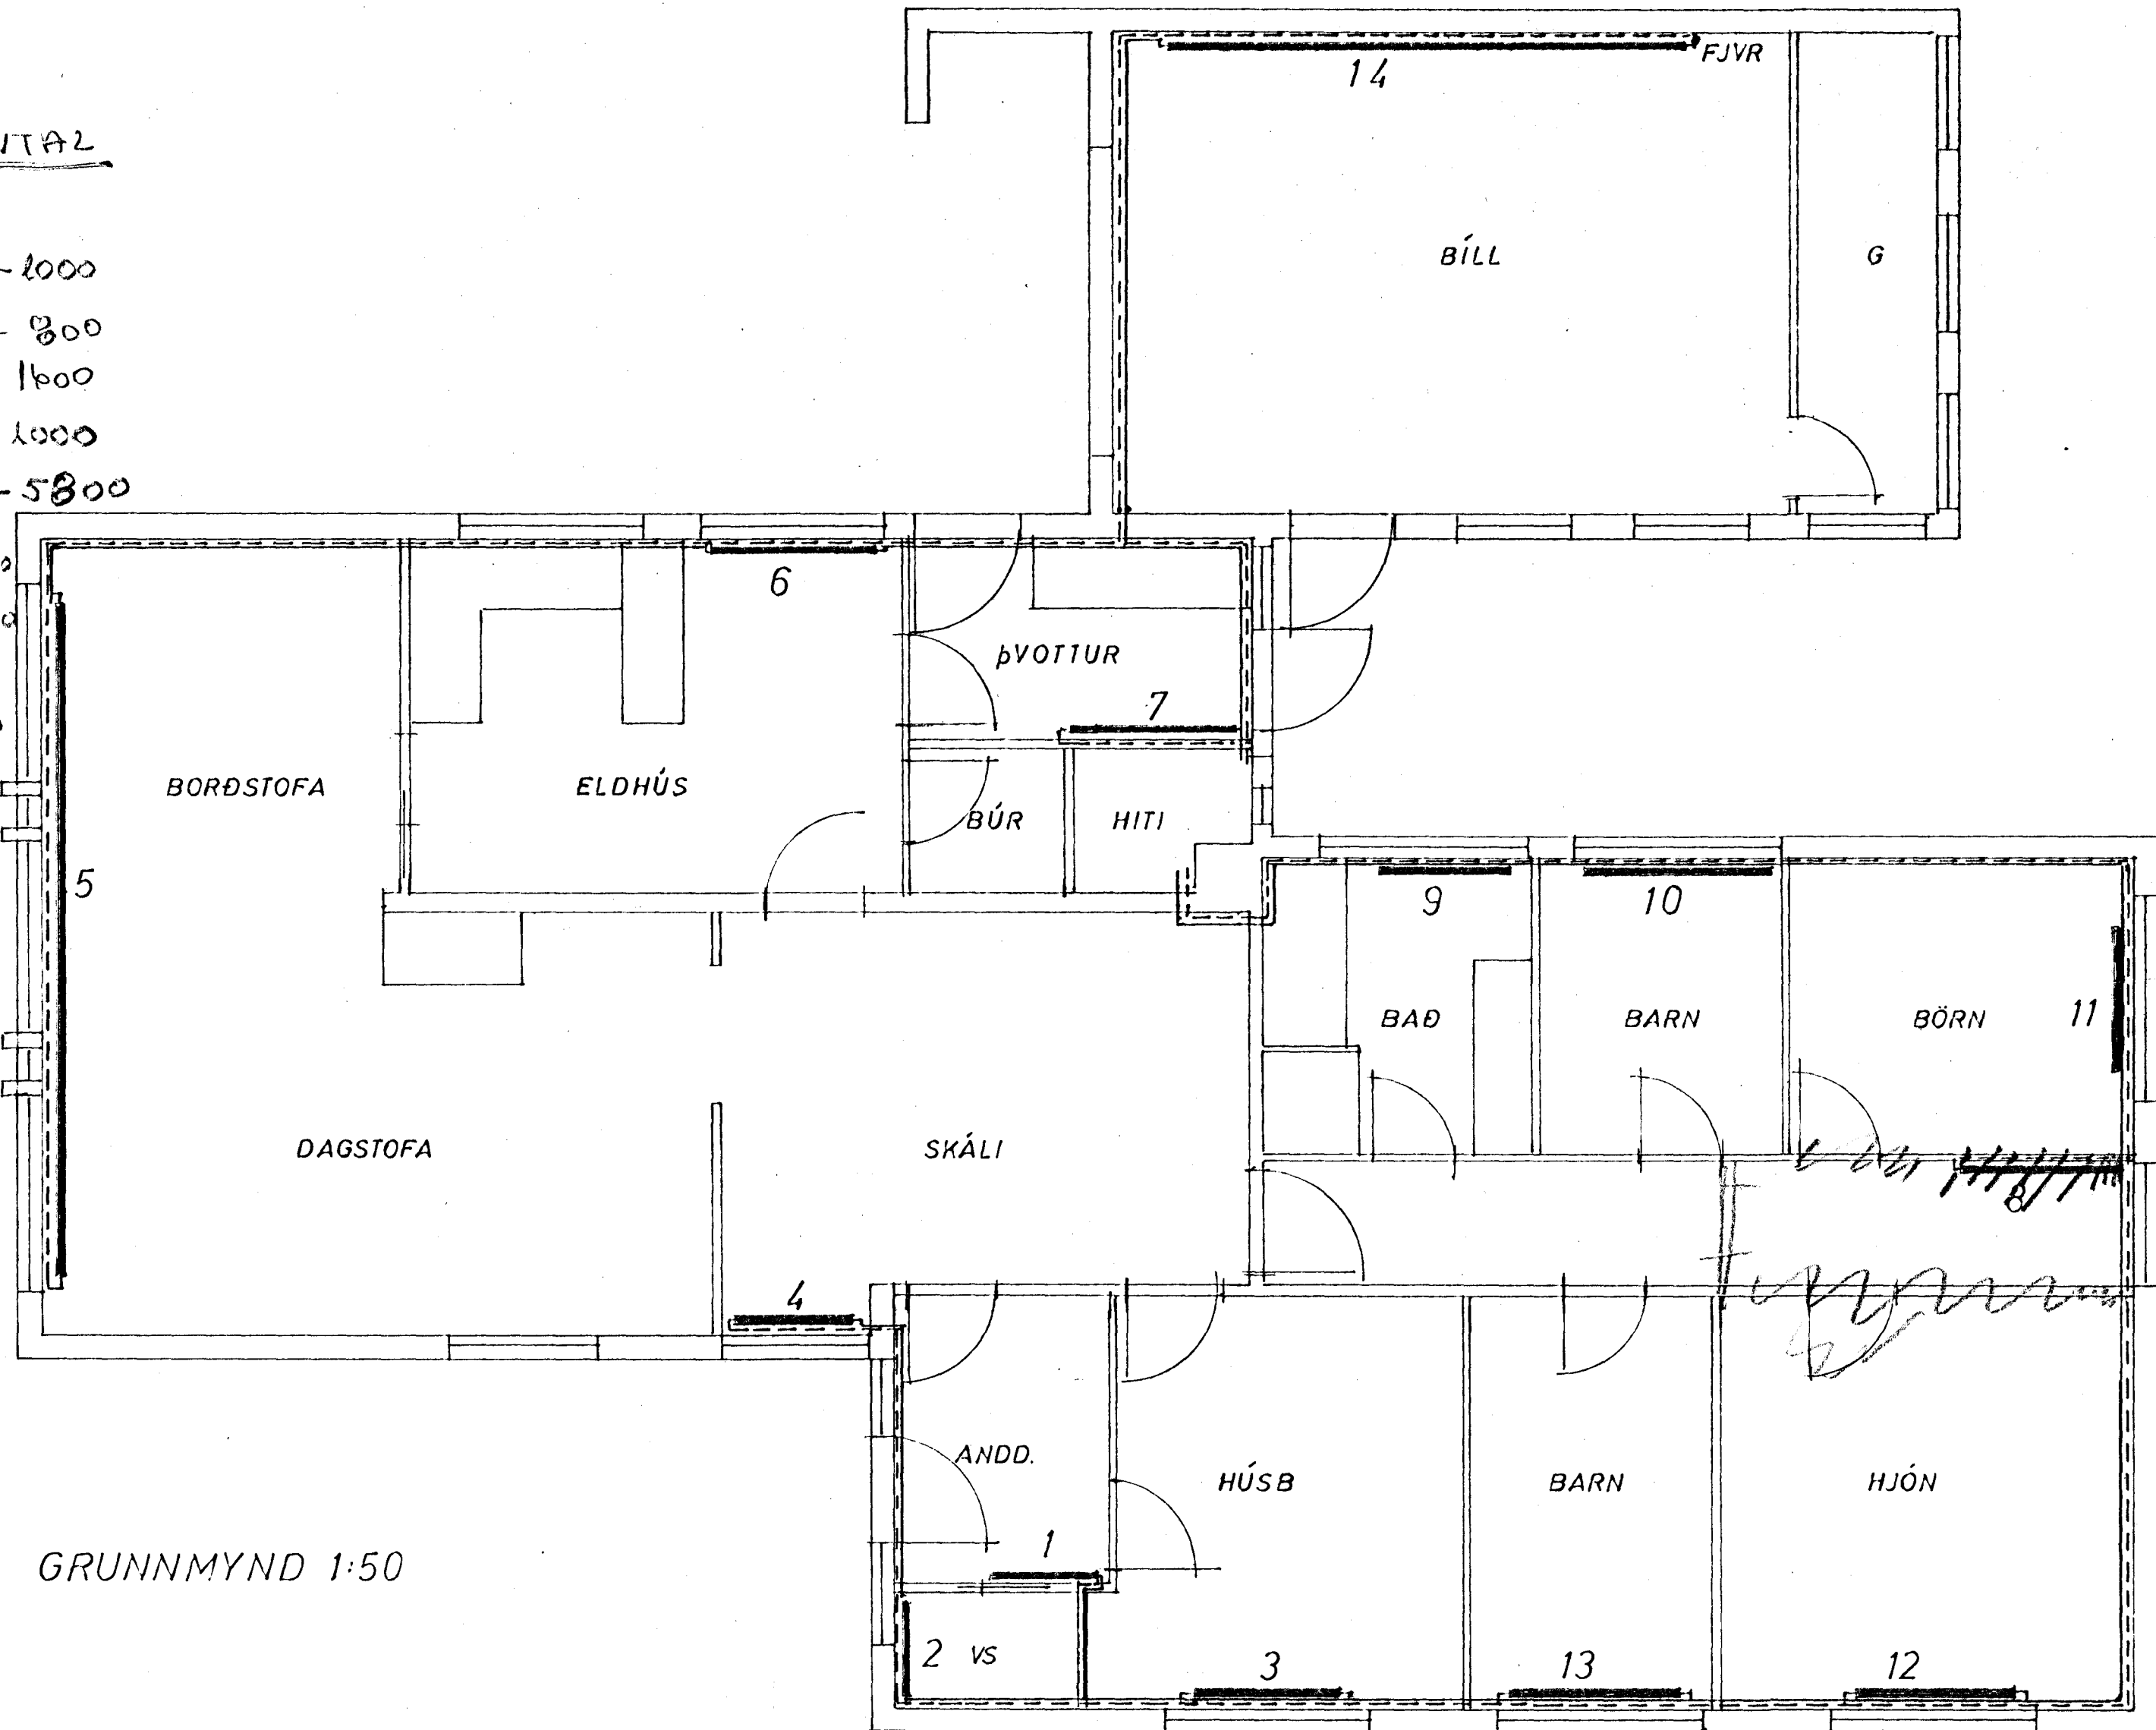

GRUNNMYND 1:50

SJÁ SKÝRINGAR Á TEIKN. NR.9.

ÞRÚÐVANGUR 12 HAFNARFIRÐI	M 1:50	VERK 7111	TEIKN.NR 8
HITALÖGN-GRUNNMYND OG OFNASKRÁ	H: JSB	Y: JSB	DAGS JÚLÍ '71
JÓHANN GUNNAR BERGÞÓRSSON VERKFR MVFI KÖLDUKINN 9	BR.		
SÍMI 52895			