
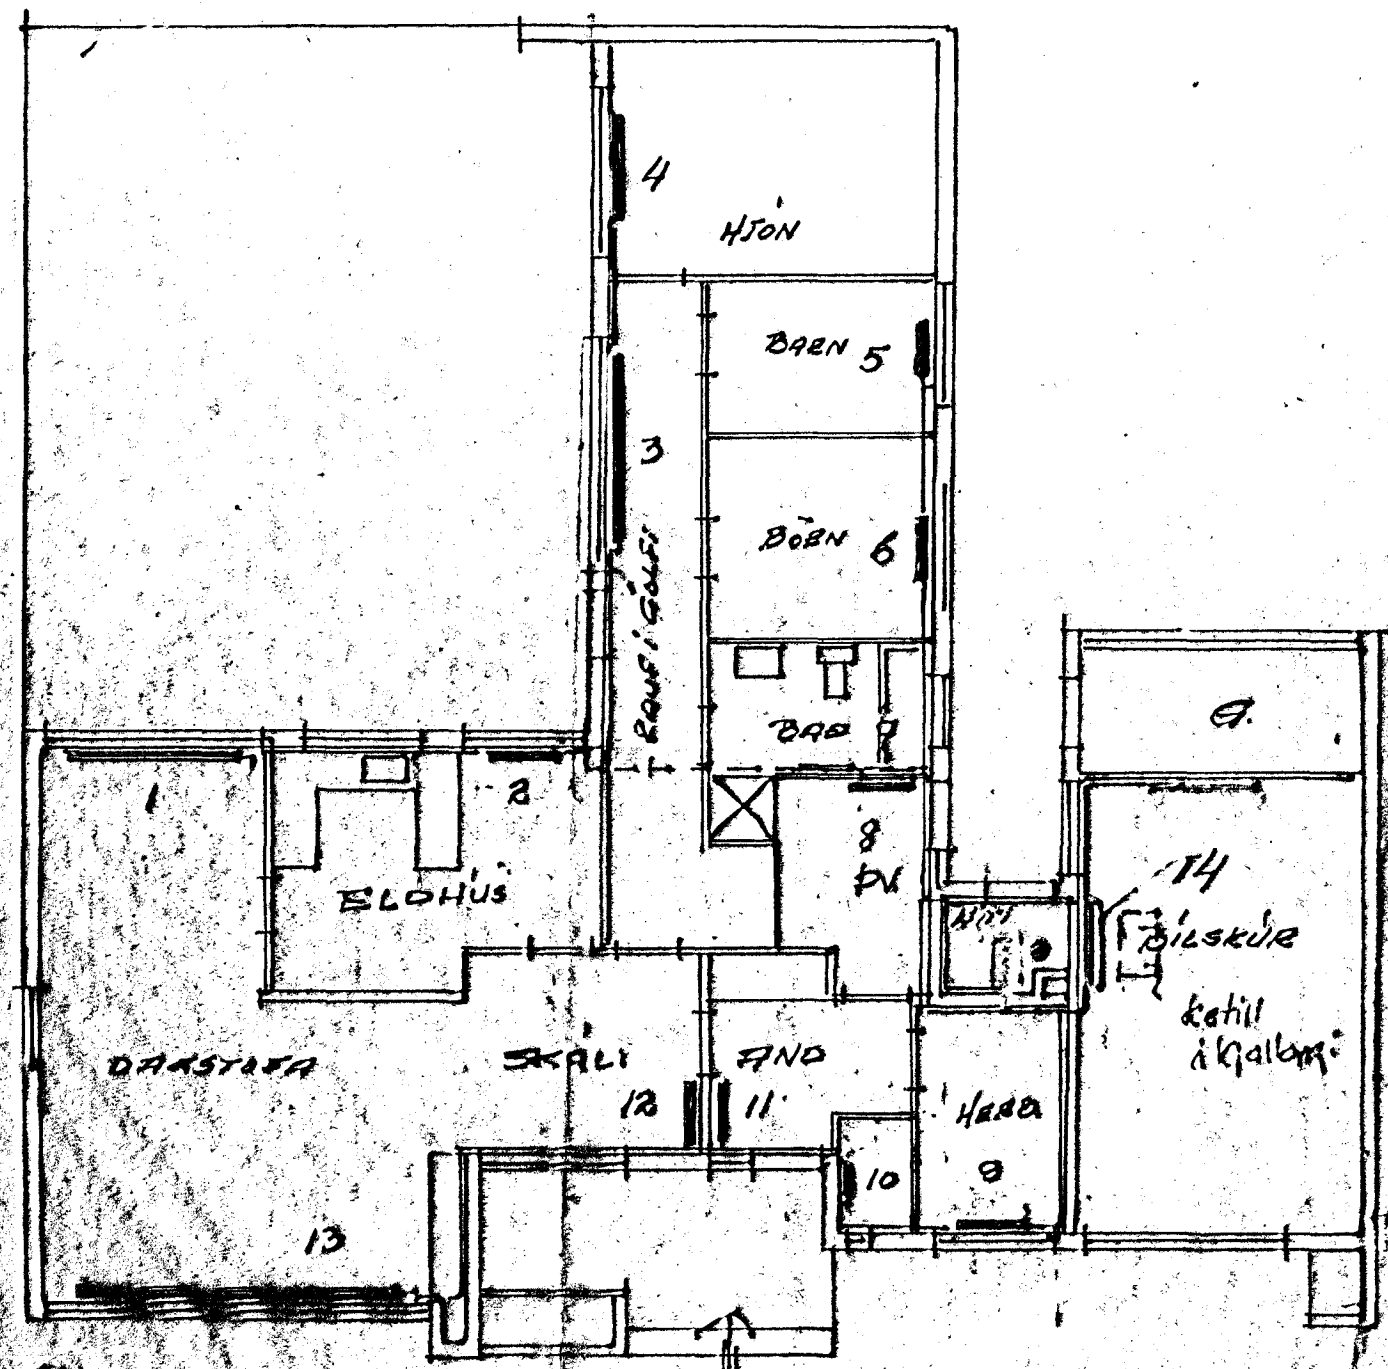


KETILL 4.0m²
 DELA 1.0m³/kg af u. 1.8m u/s.
 PLÖNDUNAR LOKI
 ÖRG Öryggisloki
 N EINSTEFNULOKAR.
 ÖFNAR HP STALÖFNAR
 HALLI TÖNNUM HITAEI í júl.
 ÖFNKRANAR SJALEFVIRKI
 T.D. DANFOSS TÜR & BETÜR.
 Þrygli semit á 64/30

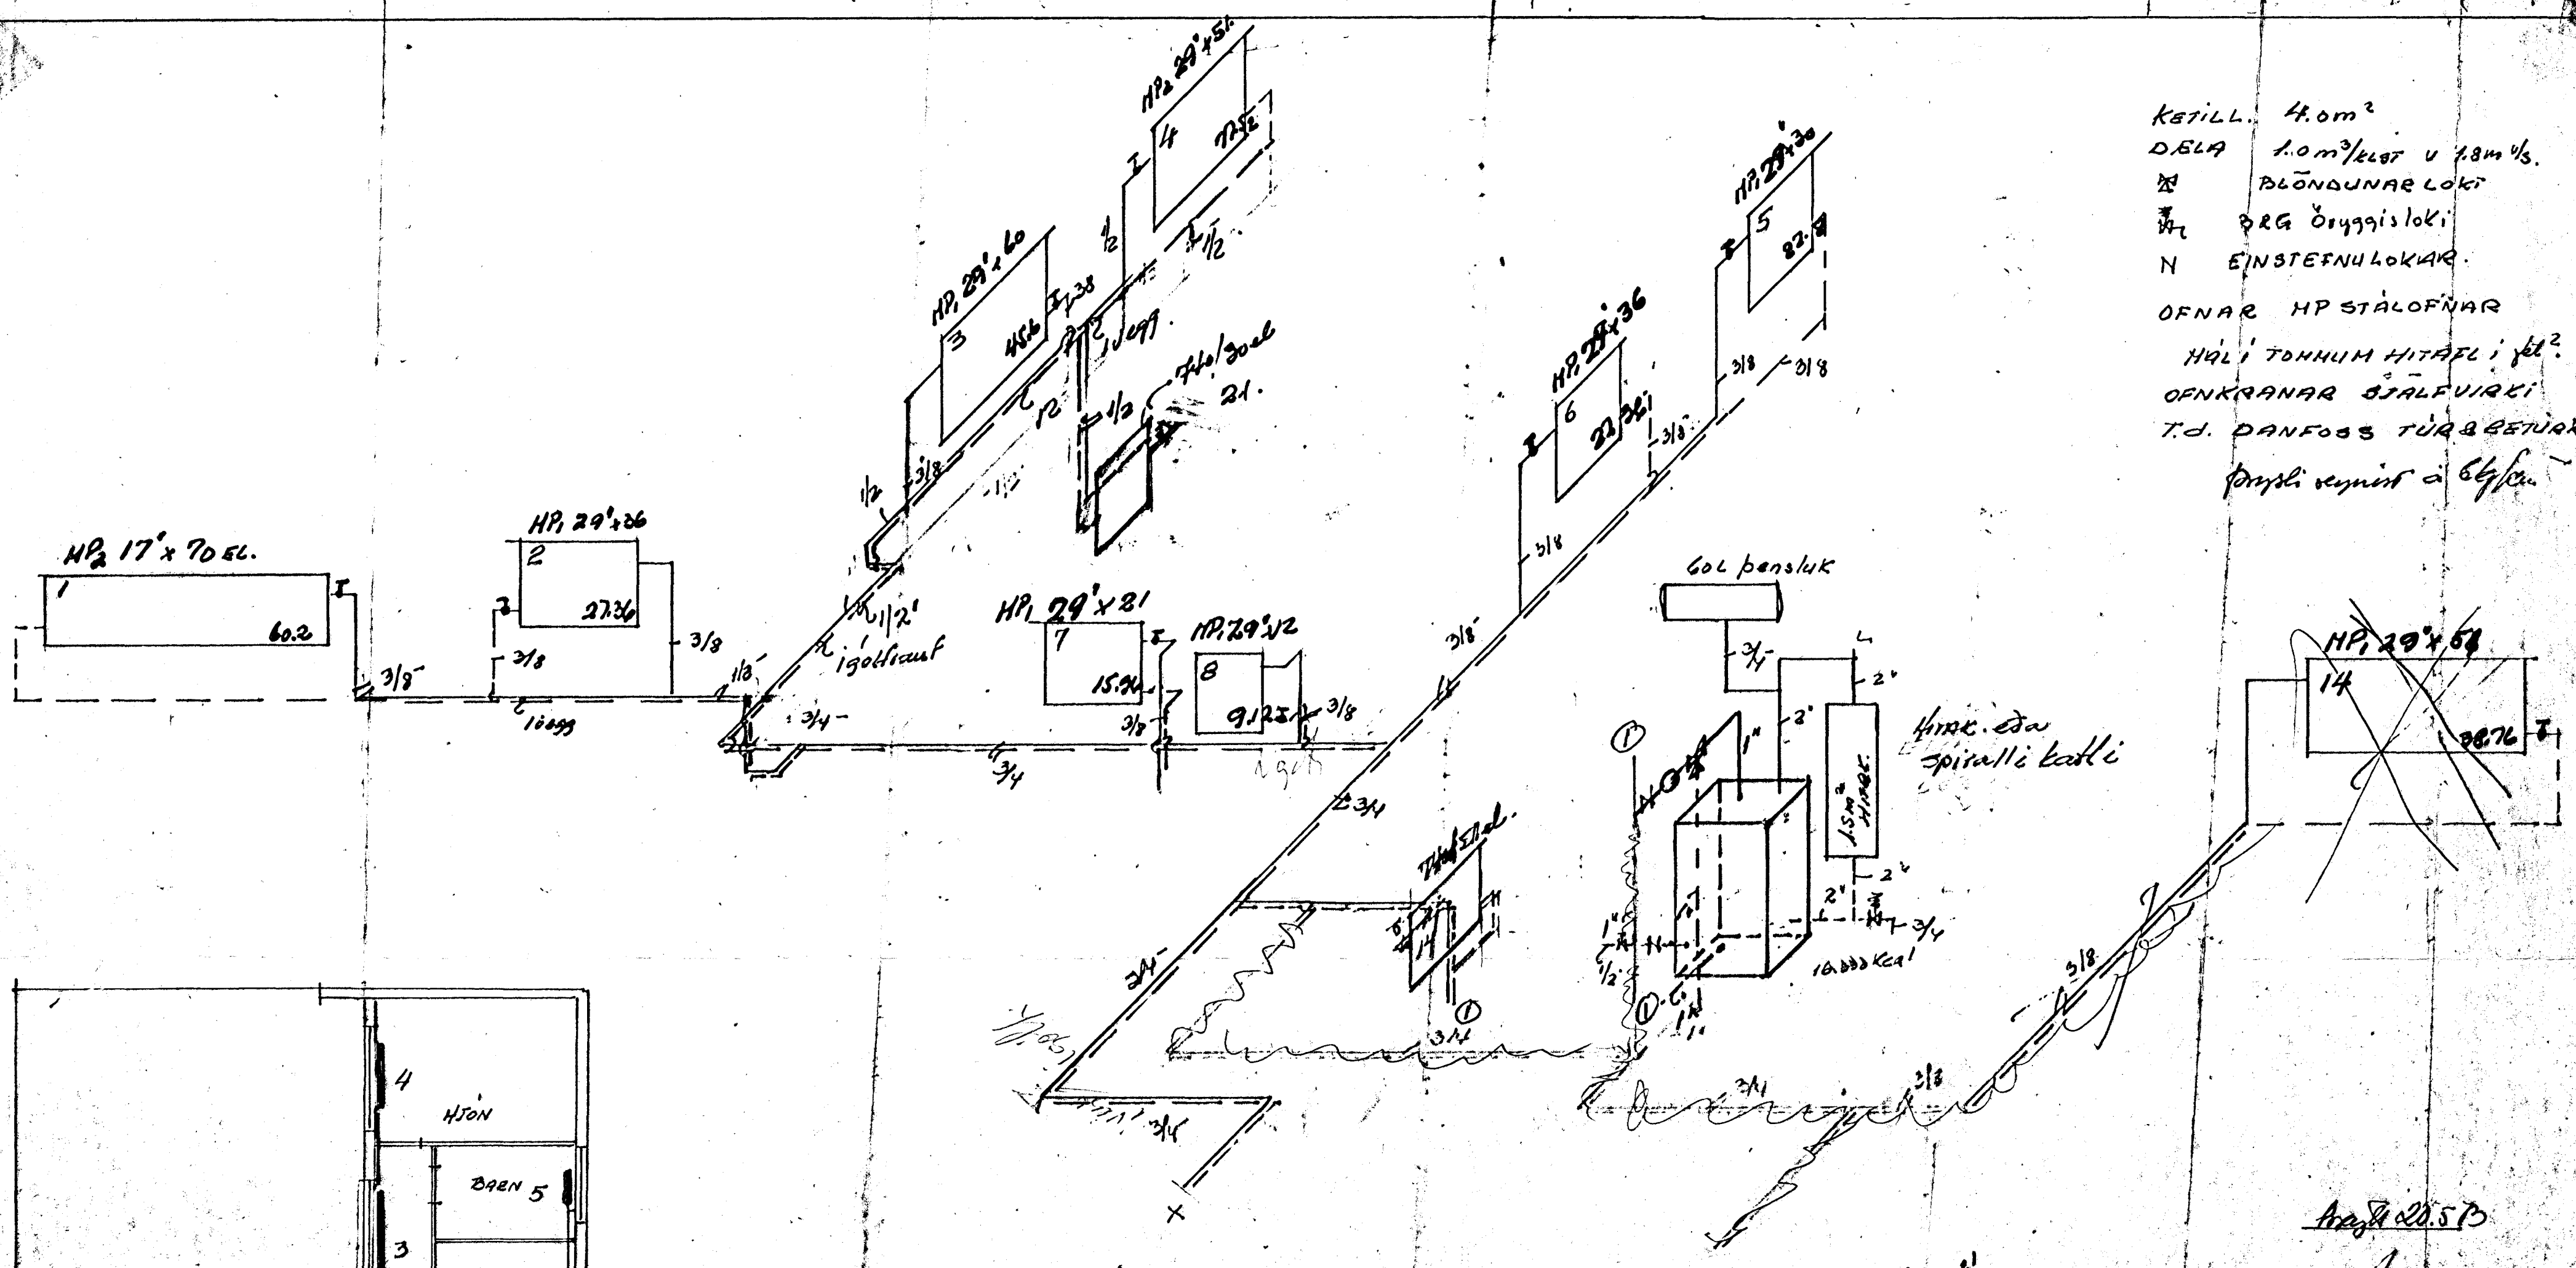

HITALÖGN Í BRÚD- VANG NO 13 HF.	GRAS. 13/569 YÖK CT.
	TEIGN NR. 6905 BLI.

Auglýsing
 20.5.13
 Skóki