


KERFI ~ 1:50

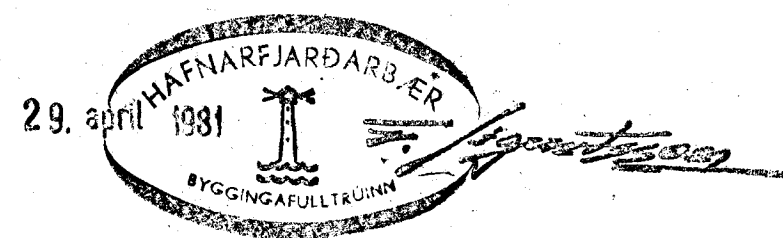

SKÝRINGAR SJÁ TEIKN. NR. 20.

HÚS D.

TÚNHVAMMUR 15	MÆLIKVARÐI ~1:50	VERK 8001	TEIKN NR 24.
VATNSLÖGN — KERFI	Hannað: <i>JB</i> Teiknað: <i>JB</i>	Yfirfarið: <i>JB</i> Samb: <i>SB</i>	DAGS MAÍ '80
JÓHANN GUNNAR BERGPÓRSSON VERKFR MVFI STRANDGÓTU 11 — HAFNARFIRÐI — SÍMI 53315	BREYTT APRÍL '81.		