



HÆÐ. BR.: 60,63 M²

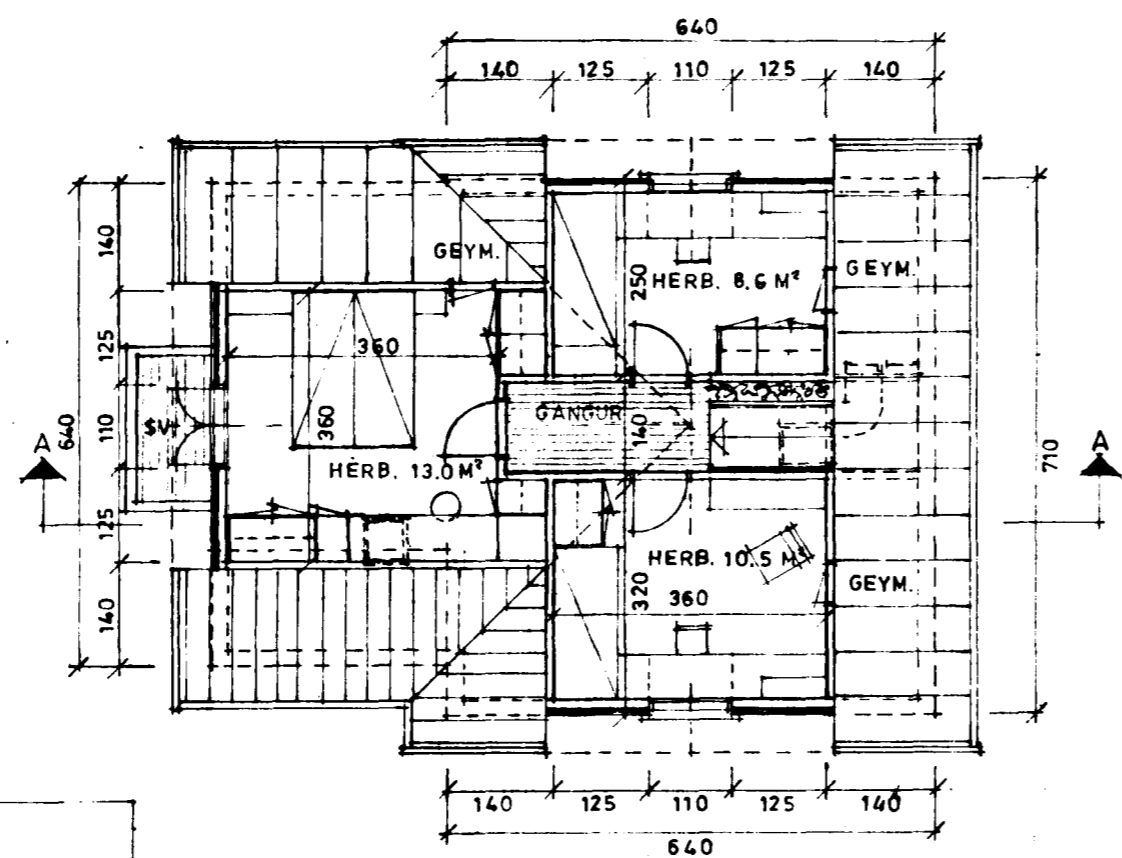

RÍS. BR.: 43,70 M²

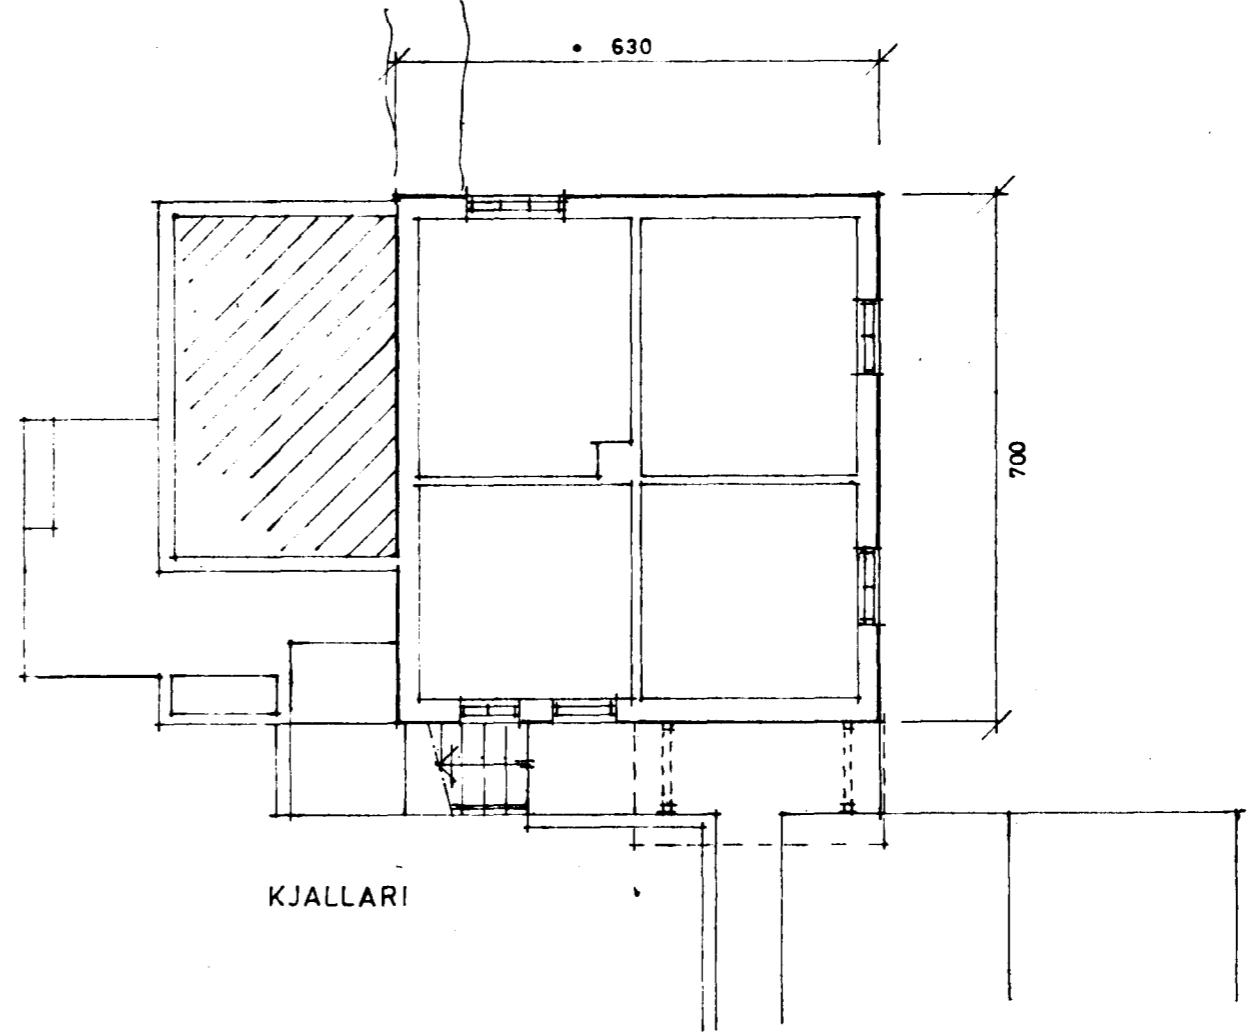

KJALLARI

Sambýkt á fundi bygginga-
nefndar þ. 18.12.1986
BYGGINGAFULLTRÚINN
Í HAFNARFIRÐI
Einar Jónsson

UNNARSTIGUR 2 * HAFNARFIRÐI

EFTIR BREYTINGU.
SAMBYKK BREYTINGU:

Jón Þorlákur Þórnannsson
9693 6044

Unnarstigur 2
Jón Þorlákur 5205-0863
Vesturbraut 3.

RÚMMÁL: HÆÐ + RÍS = 257,7 M³

Sigríður Lágmót
7630-9264
Vesturbraut 7

Sonur Guðmundsson
5253-4747
Krossseyrarveg 1.

Þija Mathiasd.
Krossseyrarveg 3
6108-6242.

Þómas Fránsason
Krossseyrarveg 3
2738-2711

Björn Björnsson
Unnarstigi 3
1322-6431


Guðrún Þorvaldsson
2284-2009
Vesturbraut 3.

Þómas Manfrédsson
8309-4907
Krossseyrarveg 3b


Þómas M. Guðmundsson
Unnarstigi 1.
AFST. MYND 1292-5581.
M.KV.: 1/500



SUÐVESTUR

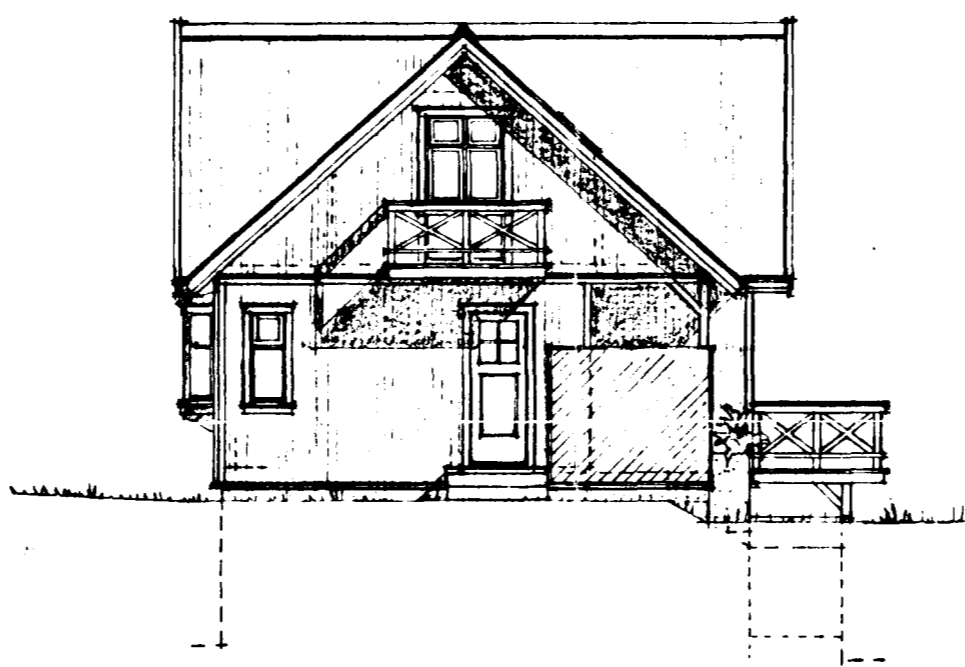


NORÐVESTUR

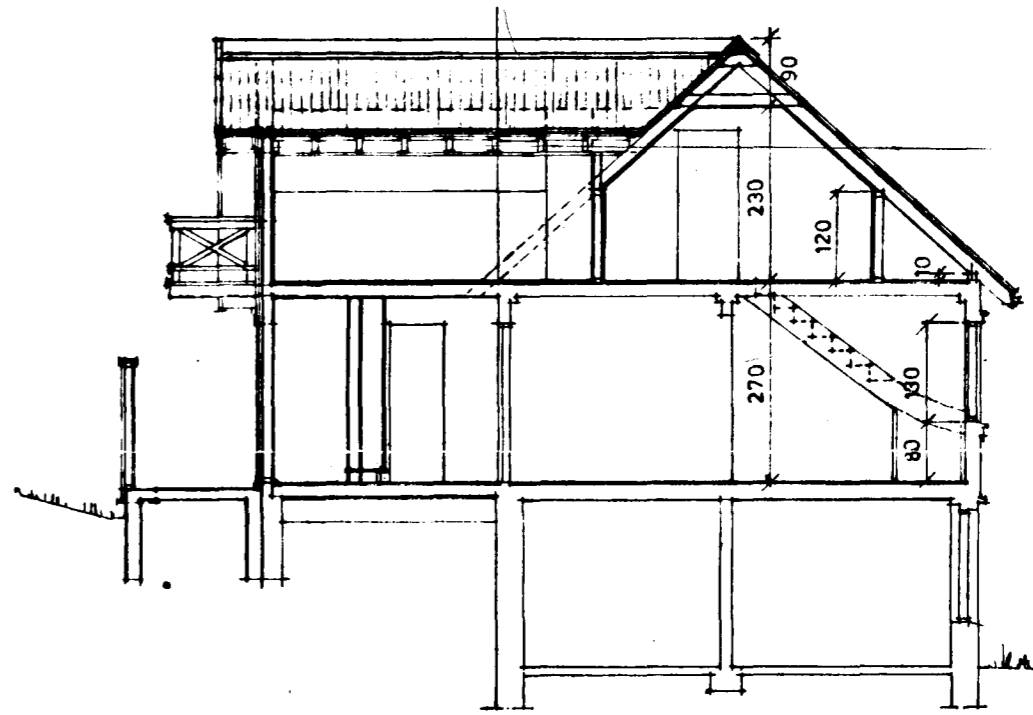


SNID A-A

FLATARN: 14 = 60 m² RÍS = 35,7 - SAMT = 95,7 m²


RÚMMÁL 14 + RÍS = 254 m³

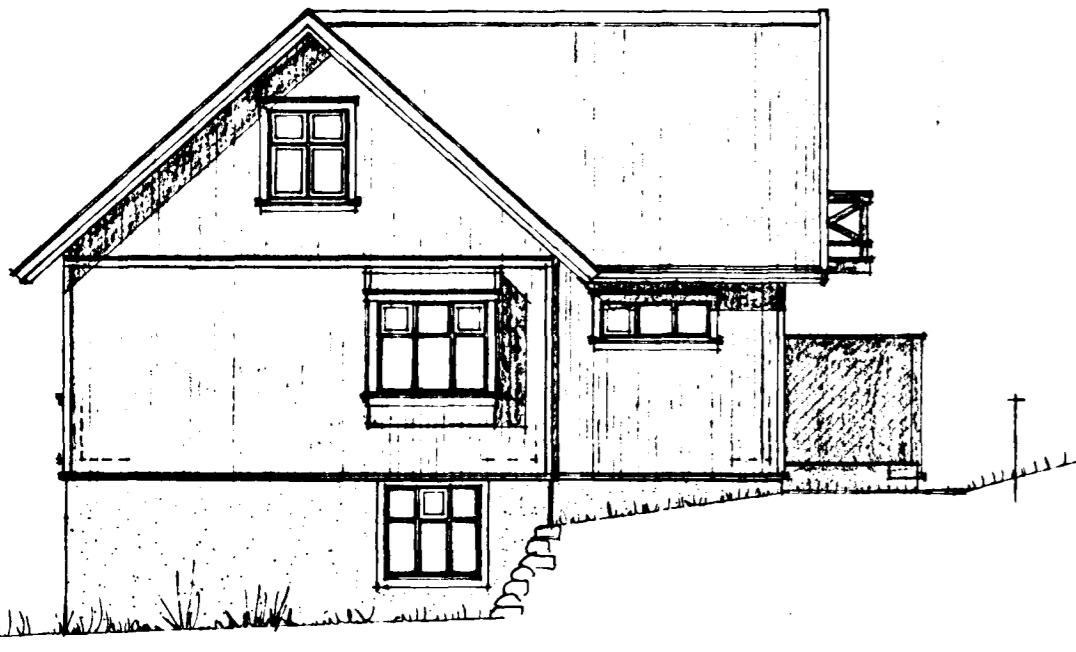

NORÐAUSTUR

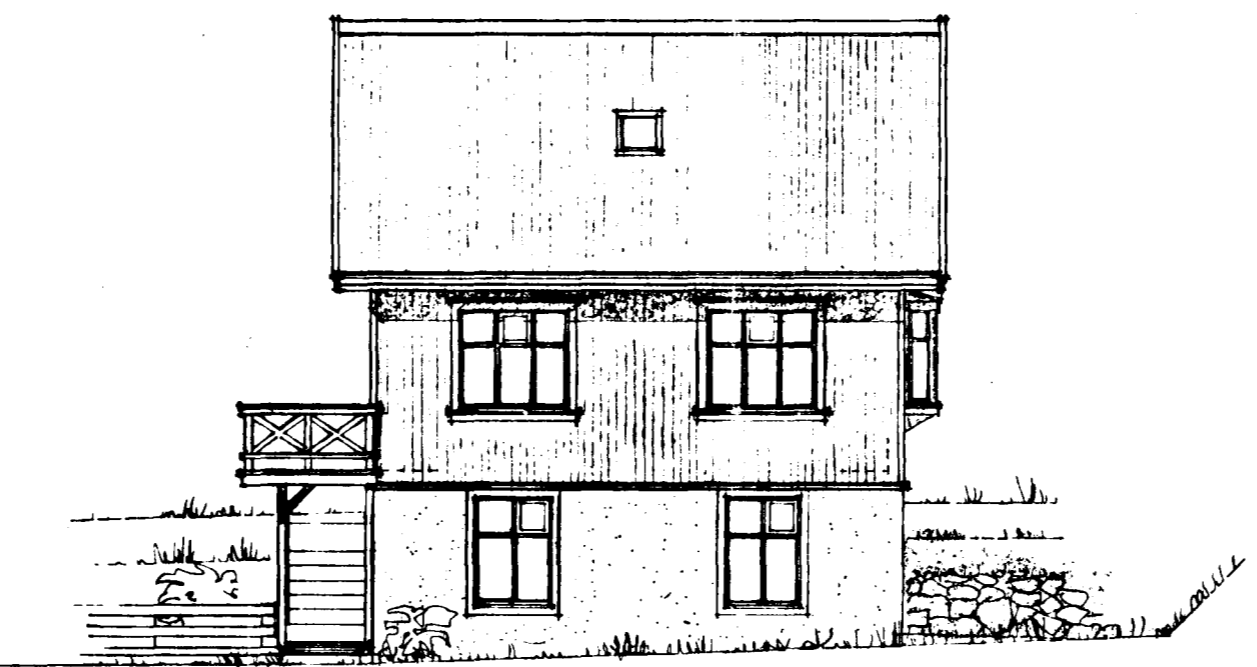

SUÐAUSTUR

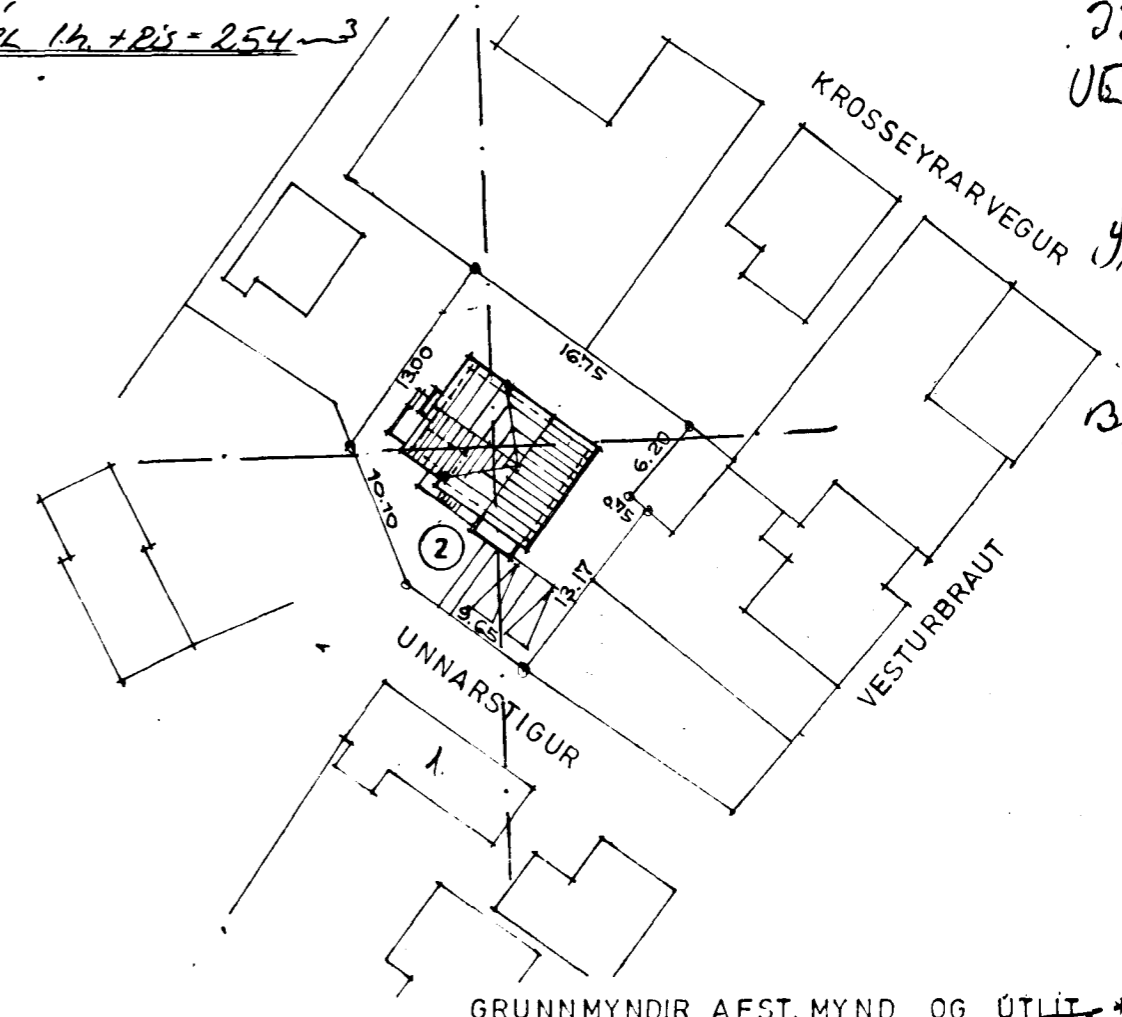

GRUNNMYNDIR AFST. MYND OG ÚTLIT * M.KV.: 1/100, 1/500

11/86/Ói Þórnannsson