



BREYTING A HUSINU ÚRÐARST. G 1. - FYRIRSPURN.
 MÆSKI 1:100 OG 1:500

FIRIR BREYTINGU


ÆTIR BREYTINGU

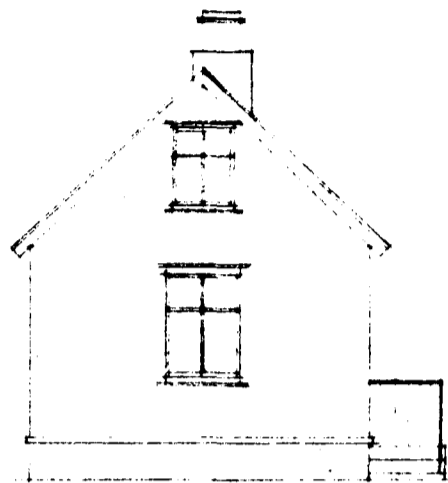


AUSTURLÆG

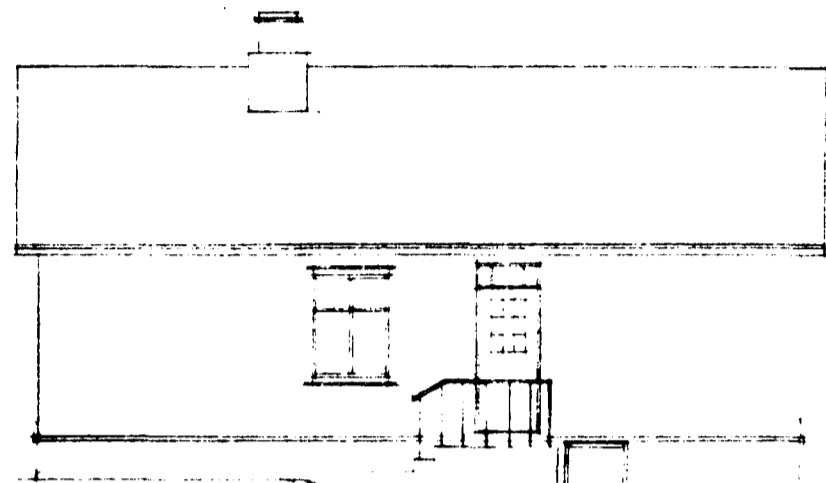


NORÐURLÆG

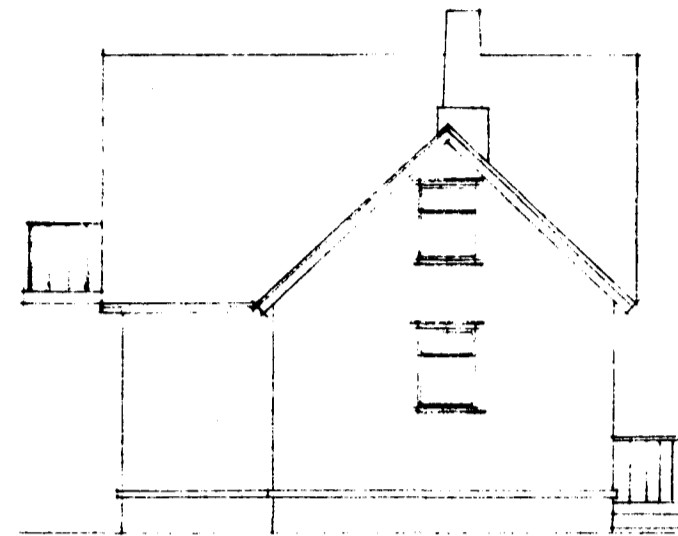


AUSTURLÆG

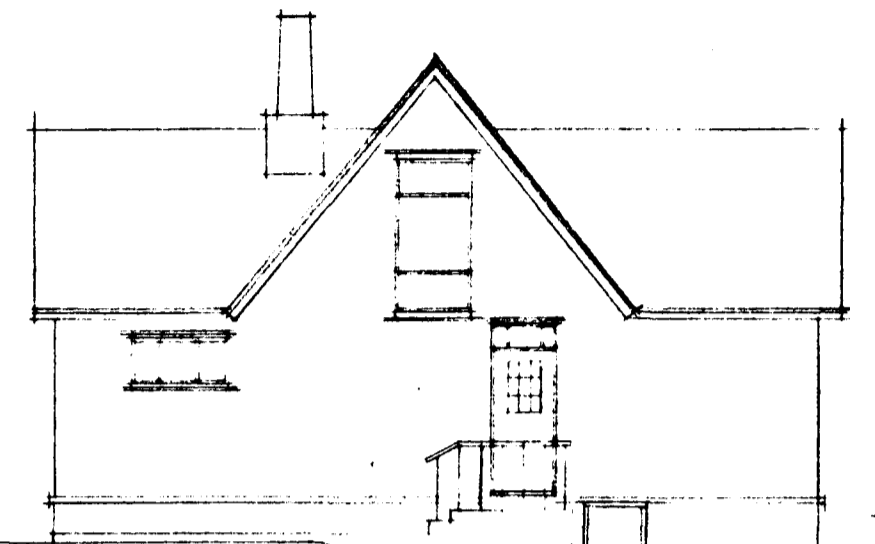


NORÐURLÆG

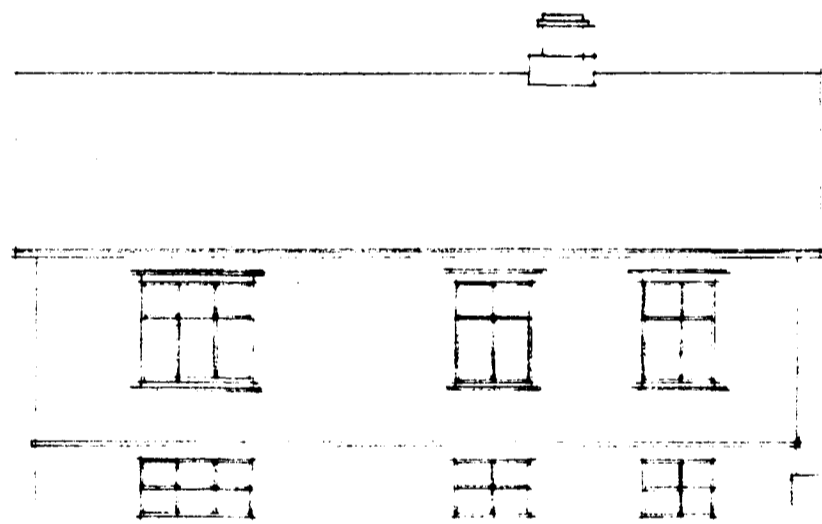


ÖSTURLÆG

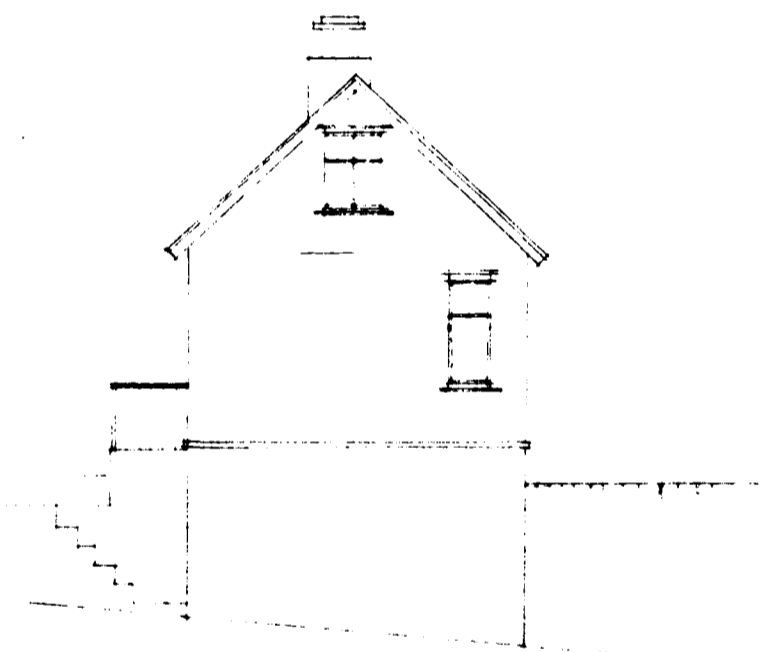


VÆSTURLÆG

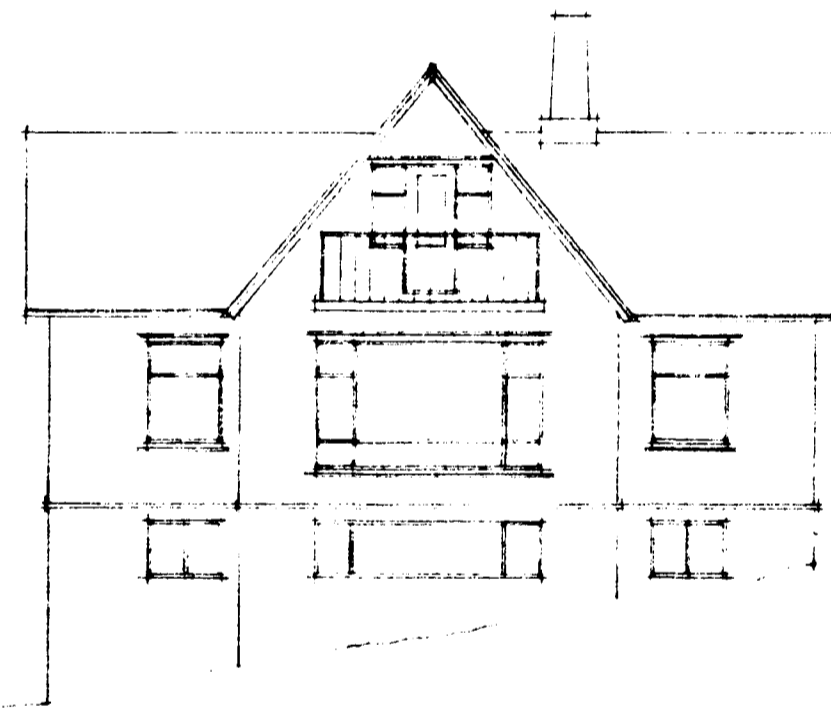


SUÐURLÆG

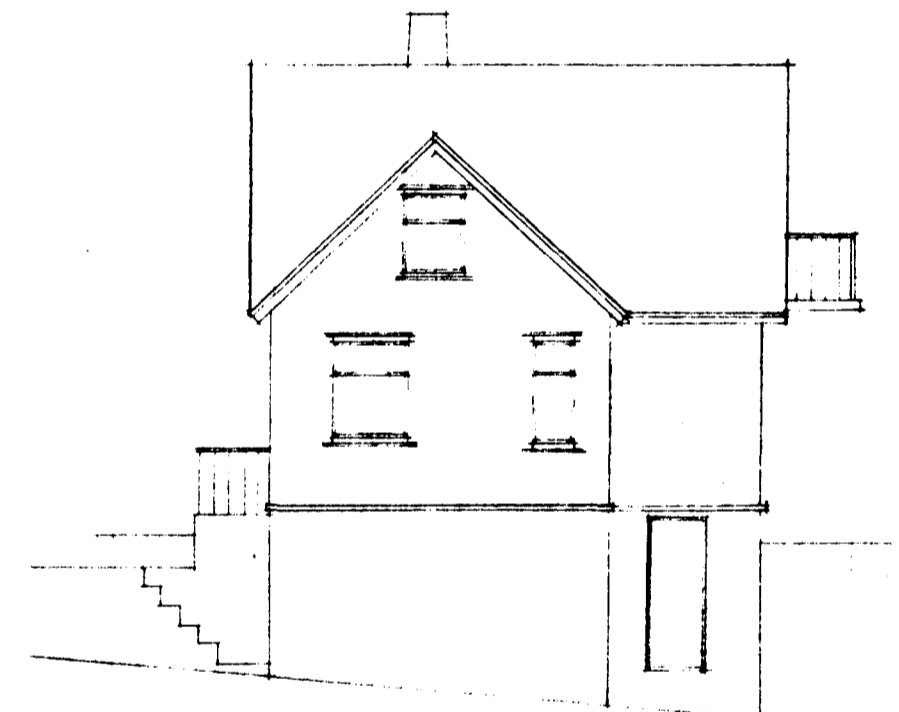


VÆSTURLÆG

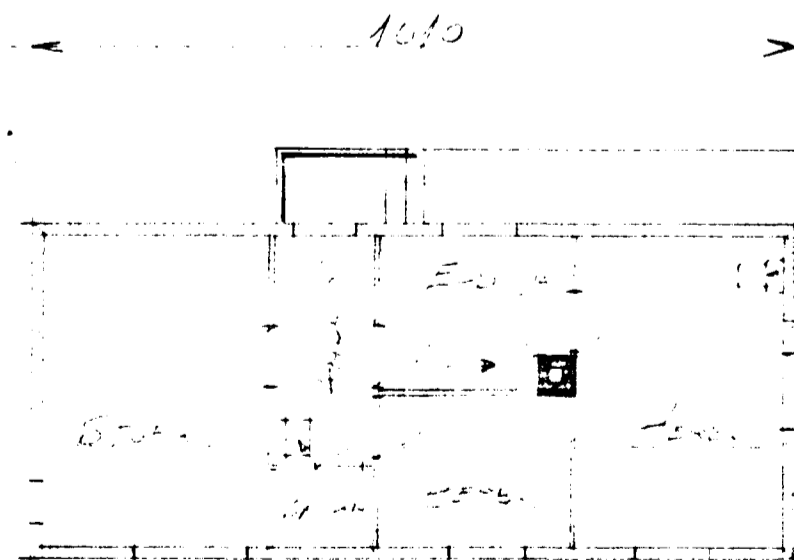

GRUNNMYND

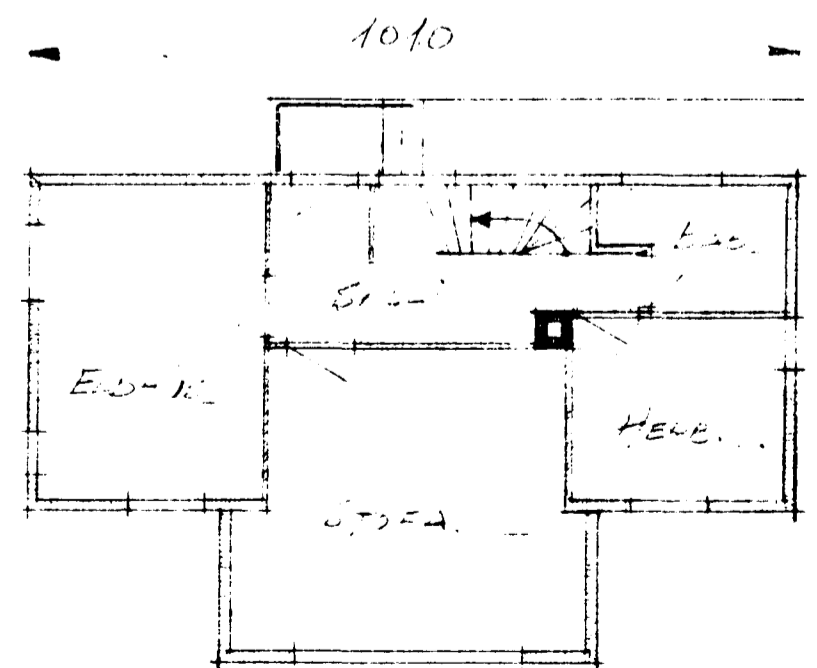

GRUNNMYND

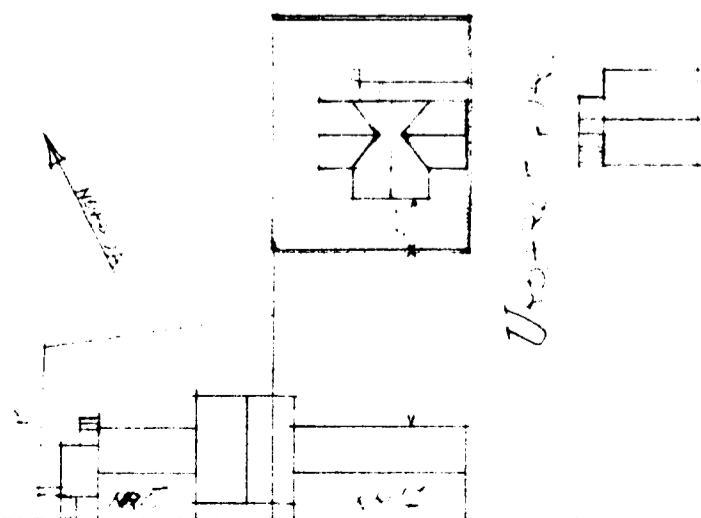

ÚTSKERT

AFTÖL MYND
1:500

ÆTIR MYND

Í POKKA

Myndir og útskirt 1964
 Einarinnsson
 TERNIFRÆÐINGUR