


RÚMMYND - VATNSLAGNA \* 1 : 50

ÁSKILIÐ, ELDRI  
TEIKNING ÓGILD

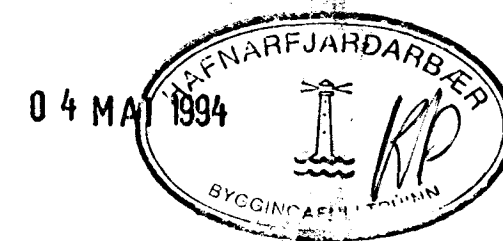

DI	28.04	LEGU LAGNA DRISHTI	...
BR.	DAGS.	EDLI BR	SIGN

ÚTHLÍÐ 33 HAFNARFÍREI

RÚMMYND - VATNSLAGNA

MKV	1:50
DAGS	SEPT 92
VERK NR.	9305
TEIKN NR.	2-05
HANNAD	
TEIKNAD	GH
YFIRFARIÐ	

**T/EKNIÞJÓNUSTA**  
**SIGURDAR ÞORLEIFSSONAR HF**

STRANDGÖTU 11 - 220 HAFNARFJÖRÐUR - SÍMI 54255 - FAX 652875