


GRUNNMÝND ~ 1:50

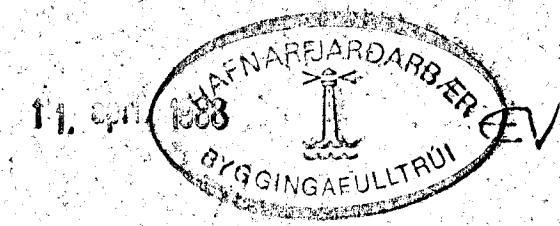

BR. NR.	DAGS	SKV. ÖSK. EIGANDA	SIGN.
01	22.04.87	SKV. ÖSK. EIGANDA	
BR. NR.	DAGS	EDLI	BREYTINGAR
		VALLARBARD II	HAFNARFIRESI
		HITA VATNS- OG FRÆKENNISLAGNIR.	
MELKV. + 150			
SIGURDUR ÞORLEIFSSON	TEKNIKREIÐINGUR R.T.F.I.		
STRANDGÖTU II	HAFNARFIRESI	SÍMI 84731	
			DAGS
			APRÍL 87
			FRUMMAS
			TEIKNADUR
			VERK NR.
			8414
			BLAÐNR.
			2-03