




Samþykkt bann


30 MAI 1996

Byggingatulltrúinn / Hafnarfirði
Erlendur Hjálmarsson

Áður sama 23/2 89

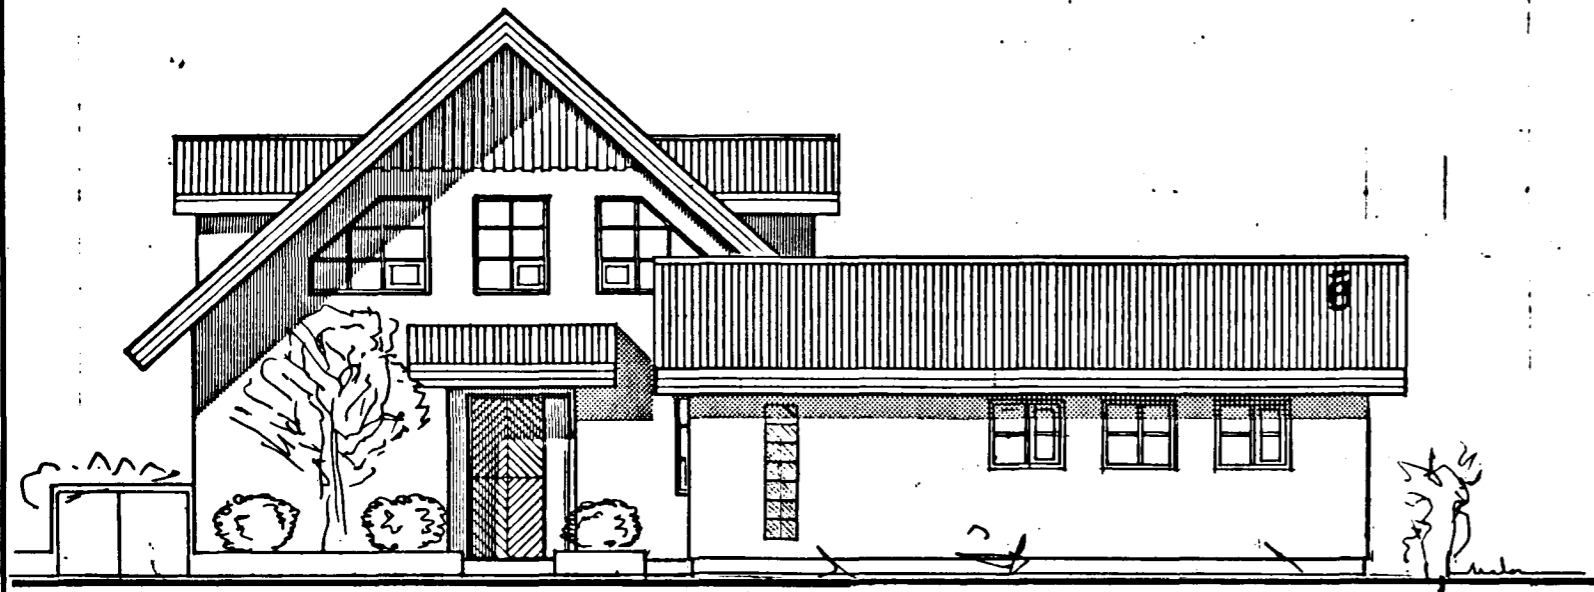

NORÐ-AUSTUR

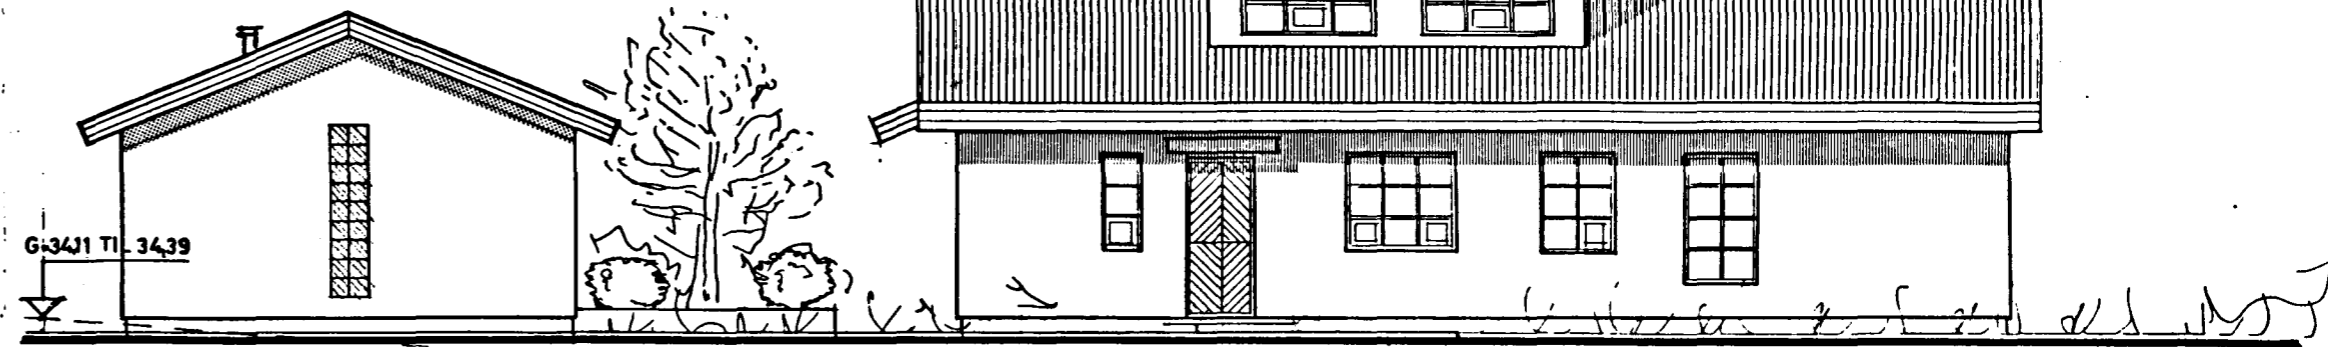


SUÐ-AUSTUR


LK-CA 3200

CA. LEGA LANDS

tifftopdf - www.rubissoftware.com - Demo Version

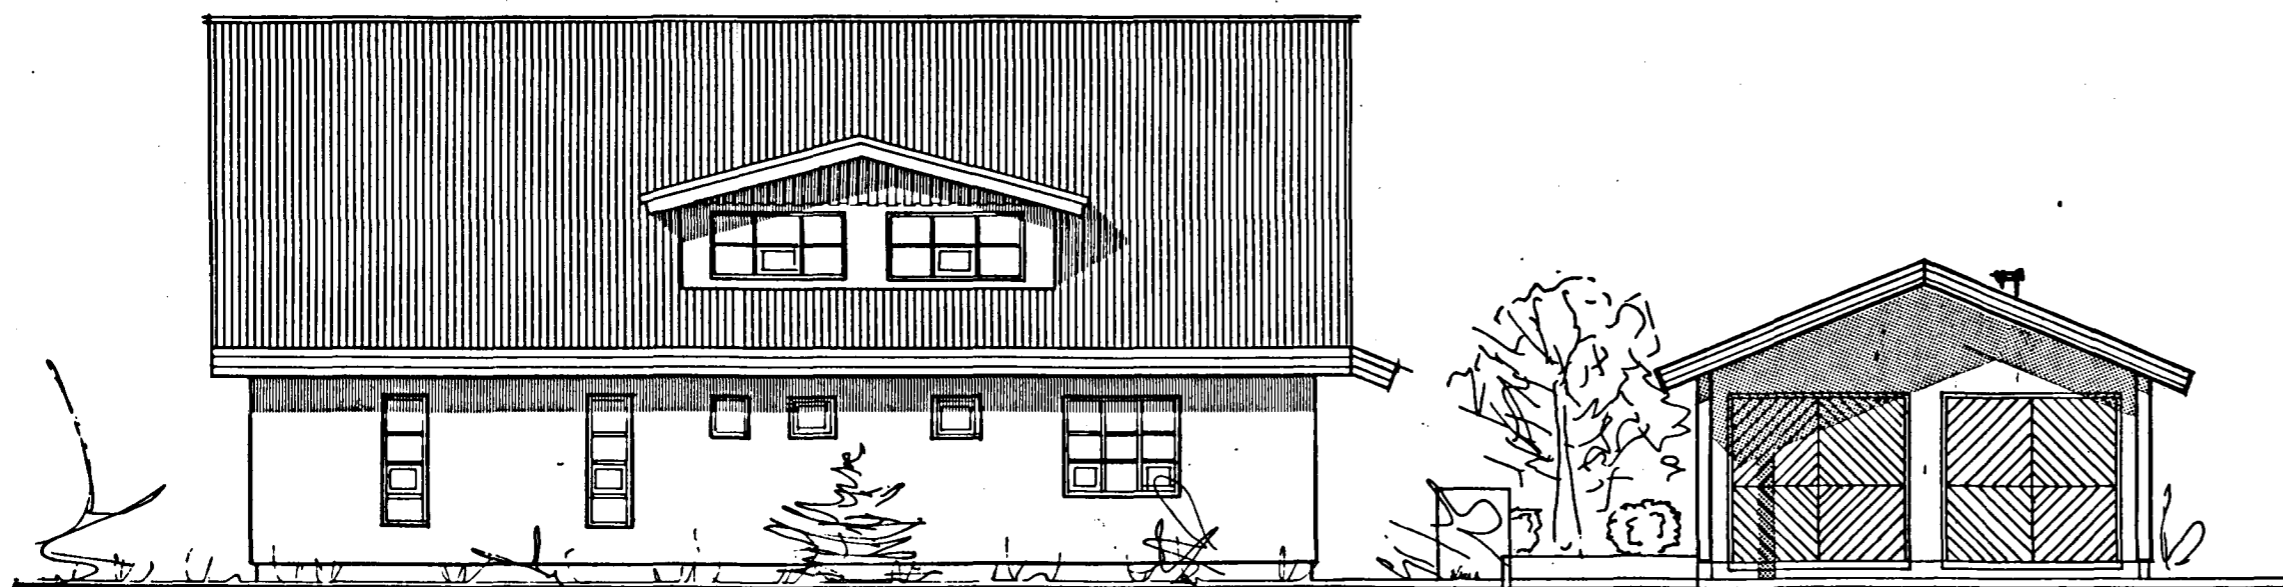

NORÐ-VESTUR

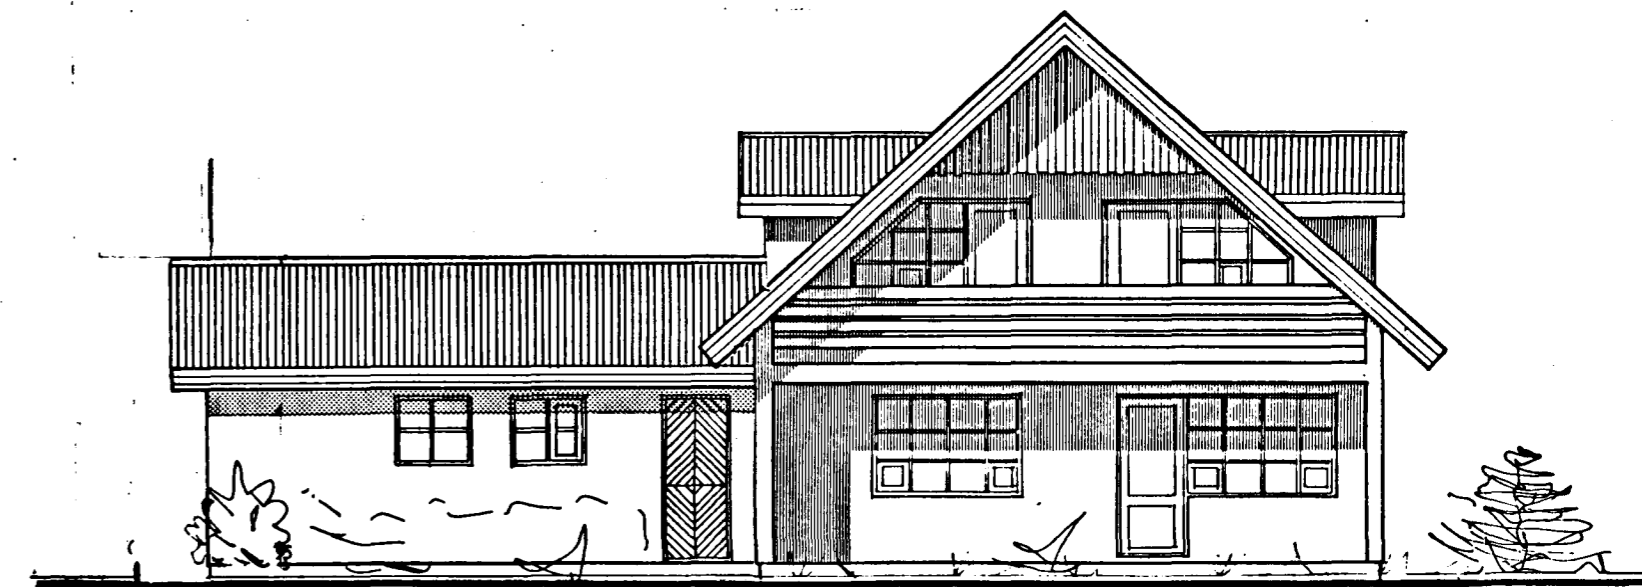

SUÐ-VESTUR

BREYTT Í MAÍ 1996

LOFTRÆSTING FRÁ GRIFJU
BÍLG. FÆRD 100 CM FRÁ LÖDARMÖRKUM
HÚSS NR. 719

Erlendur Hjálmarsson

BREYTT ÁGÚST '88. F.H.
Bilageymsla teiknuð

KVARDI Teiknistofa Bolholti 6, 3.h. Reykjavík Sími (91) 82414

VERKEFNI	VALLARBARD 2 17 99.	KVARDI	1:100	VERK NR.	83 23-4
HEITI	ÚTLITSTEIKNINGAR	DAGS.	APRIL '83	TÝPA NR.	
		HÖNNUN	GG	TEIKN. NR.	A-1
		TEIKN.	REIKN.		

Erlendur Hjálmarsson

Gísli G. Gunnarsson, s.r.l.