

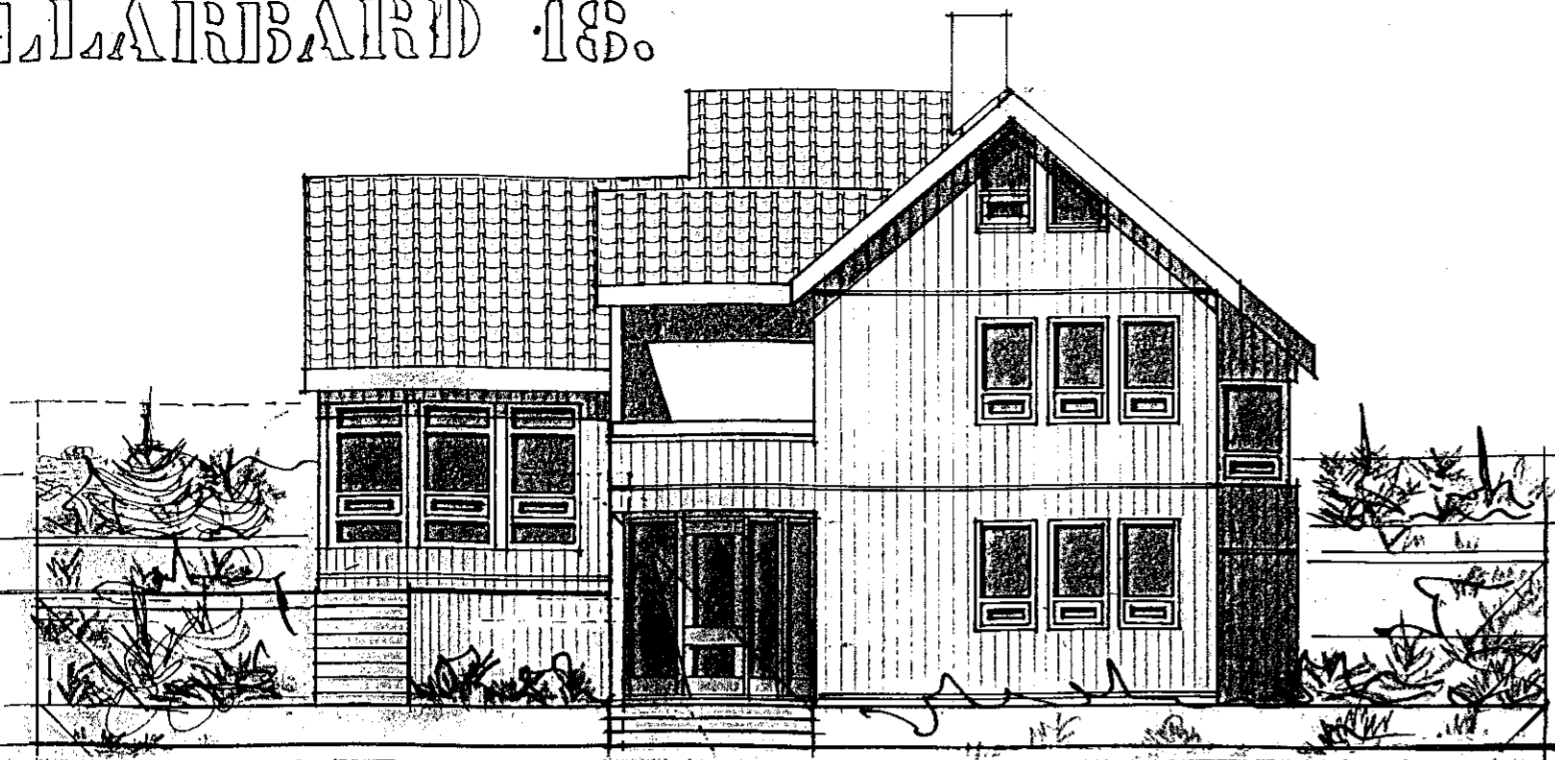


VALLARBAED 18.

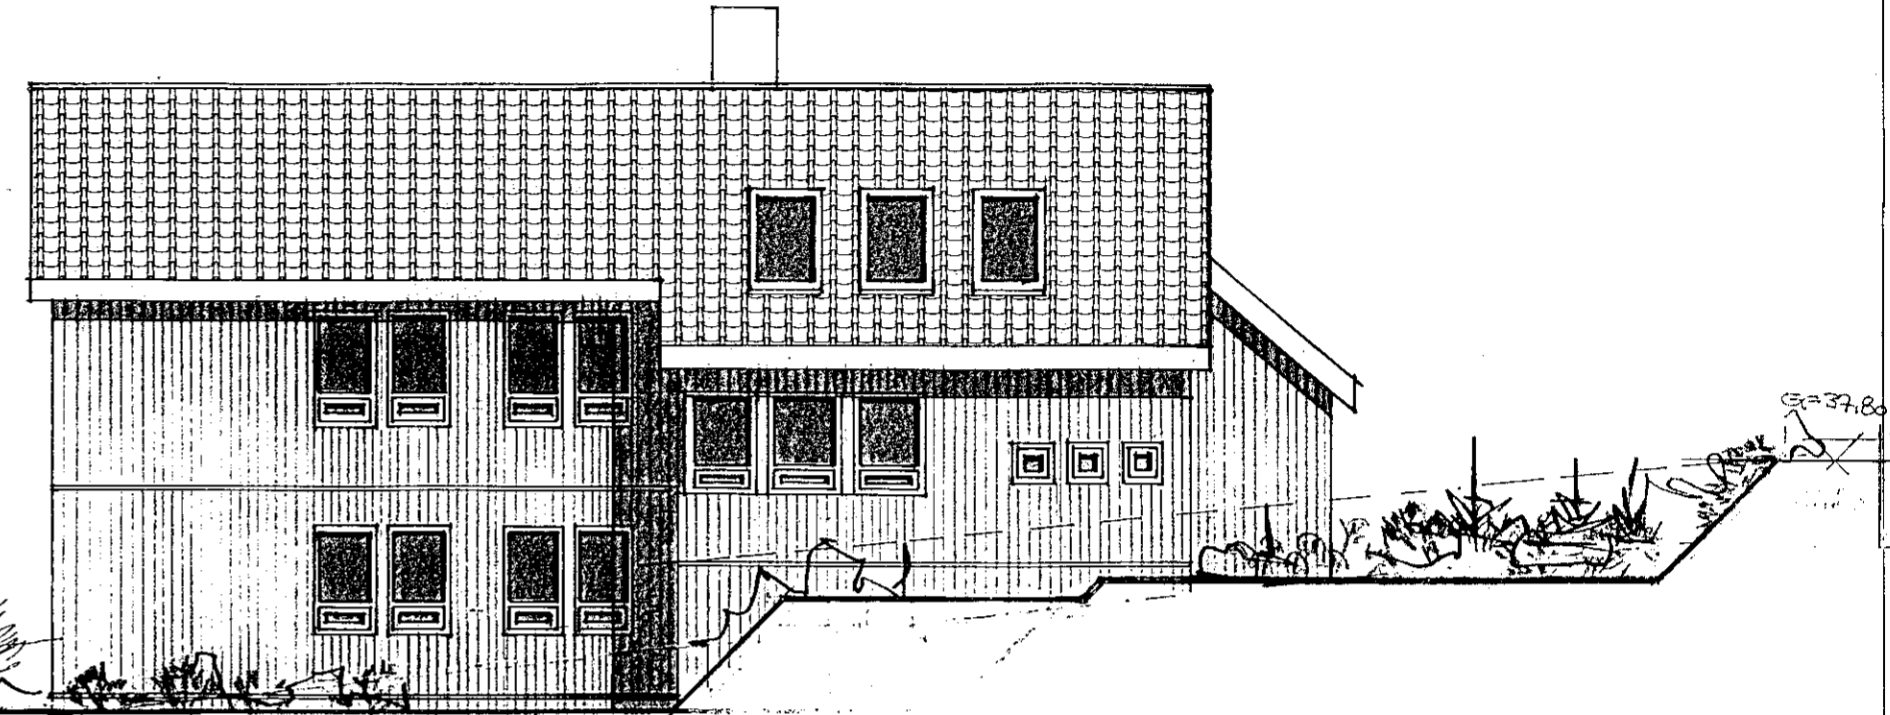


Samþykkt þann
18 SEPT. 2001
Byggingarfulltrúinn í Hafnartröi
s.h. Kristján Þórarinnsson


SUÐ-AUSTUR M. 1:100.

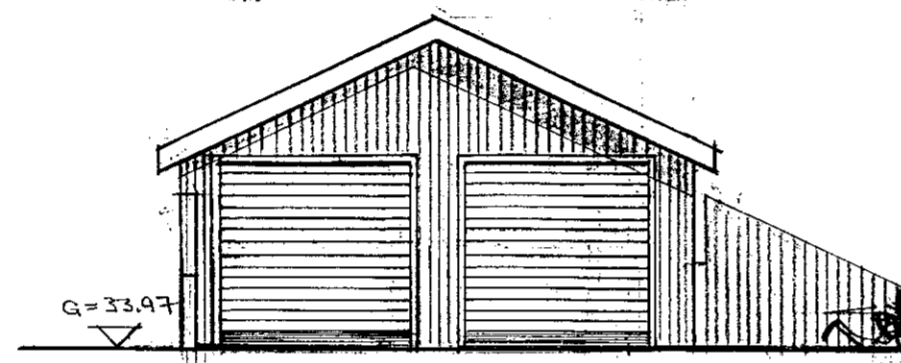


NORÐ-AUSTUR M. 1:100

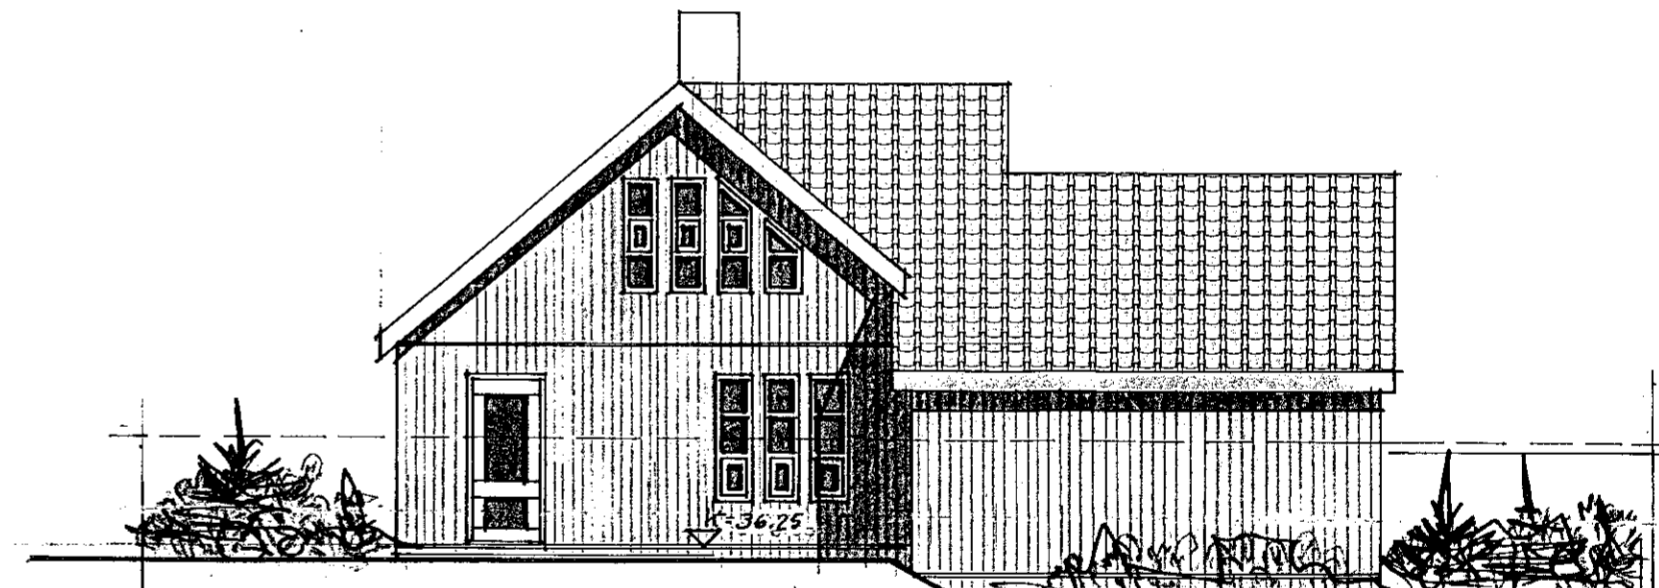

NORÐ-VESTUR M. 1:100

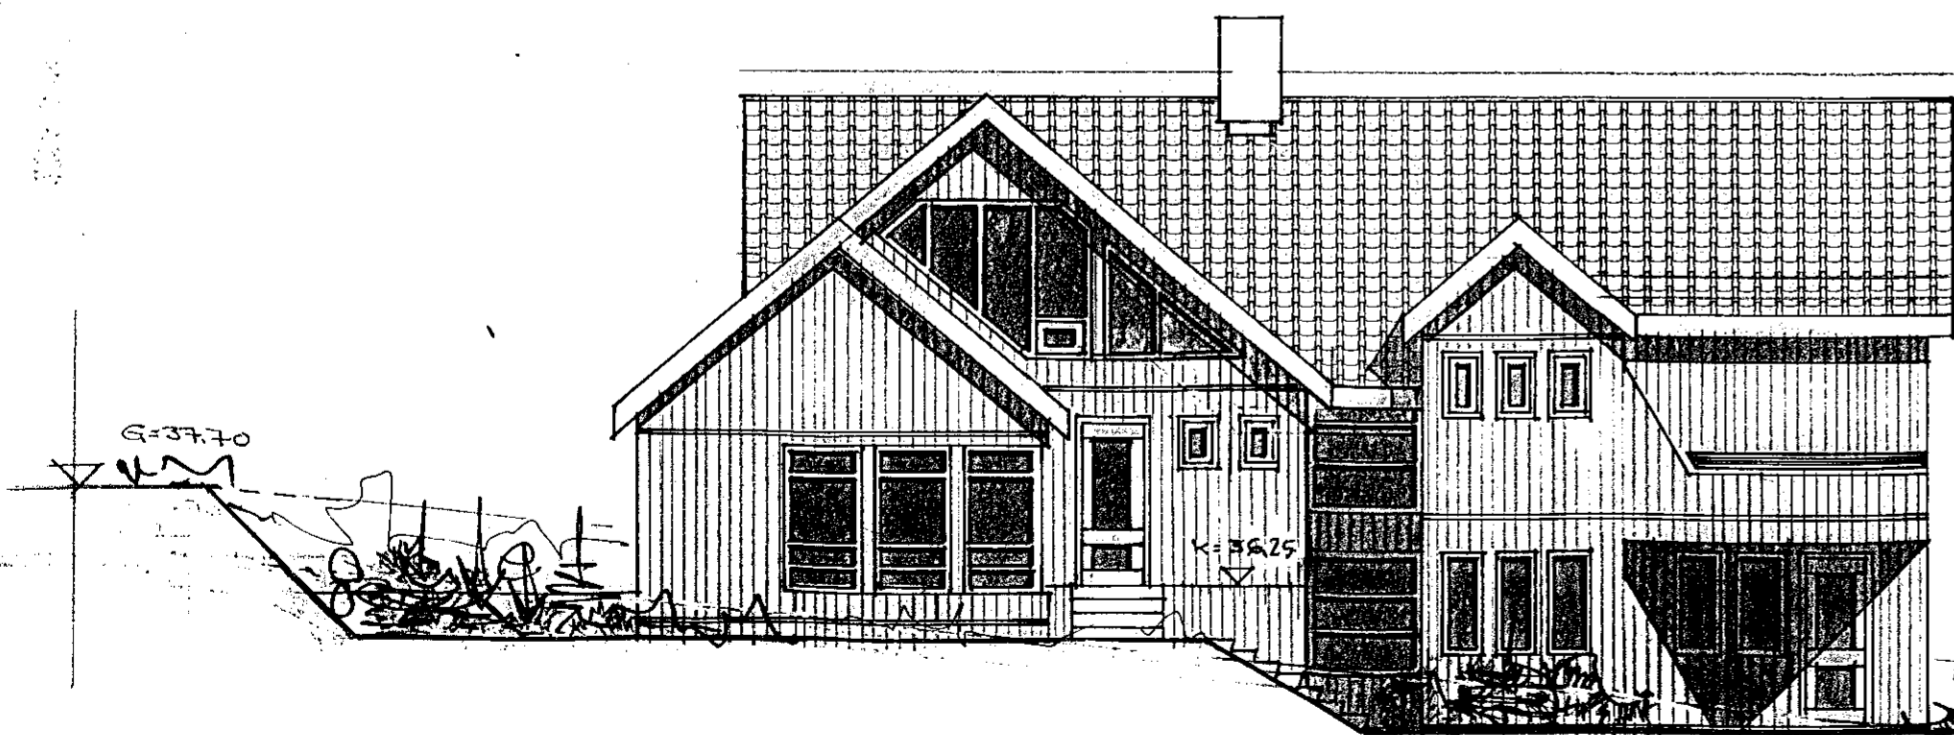

SUÐ-VESTUR M. 1:100.

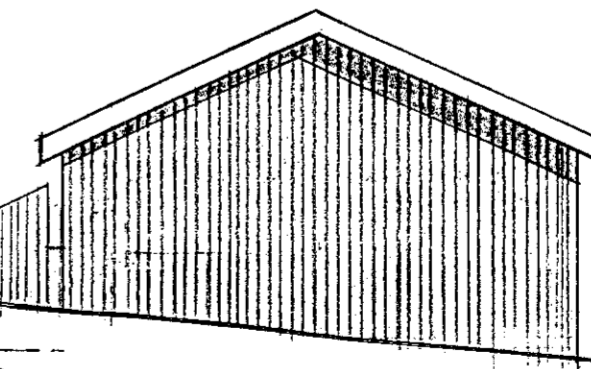

2 STK GLUGGAR SETTIR A GEYMSLULOFT 13.09.2001.

14/9 01
LÖB BREYTT OG HÆÐARKÓSTAR LAGFERDIR 1 SEPT 97. *Qsp.*

BILGEYMSLU BREYTT 17 JUNI 1991 BREYTT SEPT 82 <i>Qsp.</i>	VALLARBAED 18. EINBYLIÐSHUS OFTIT.	TEIKNAD 9 JULI 82 MKV. 1:100
VITTI BREYTT 1 AGUST 82 <i>Qsp.</i>	SIGURDUR ÞORVARÐARSSON BYGGINGARFRÉÐINGUR BREIÐVANGI 28 HF. SIMI 54092	NR. 2 AF 3 <i>Sigurður Þorvarðarsson</i>