


gangstétt í segr!
3/5 85
RÁ

BRÚTTÓSTÆRÐIR:

VALLARBARÐ 1			
01 01	70,5 m ²		2
01 02	66,8		
01 SAMEIGN	66,0		
01 GEYMSLUR	43,4		
01 SAMT	246,7 M² 246,3		
02 01	83,6		3
02 02	80,1		
02 03	66,8		
02 SAMEIGN	24,8		
02	255,3 M² 252,1		
03 01	83,6		3
03 02	80,1		
03 03	66,8		
03 SAMEIGN	24,8		
03	255,3 M² 258,1		
	757,3 M²	762,5	
	2410,0 M ³		
VALLARBARÐ 3			
01 01	66,0		2
01 02	70,5		
01 SAMEIGN	52,6		
01 GEYMSLUR	27,0		
01	216,1 M² 215,5		
02 01	117,8		2
02 02	83,6		
02 SAMEIGN	22,5		
02	223,9 M² 226,5		
03 01	117,8		2
03 02	83,6		
03 SAMEIGN	22,5		
03	223,9 M² 226,5		
	663,9 M²	668,5	
	2108,0 M ³		
BÍLSKÚRAR			
	205 M² 206,1 m ²		
	687 M ³		

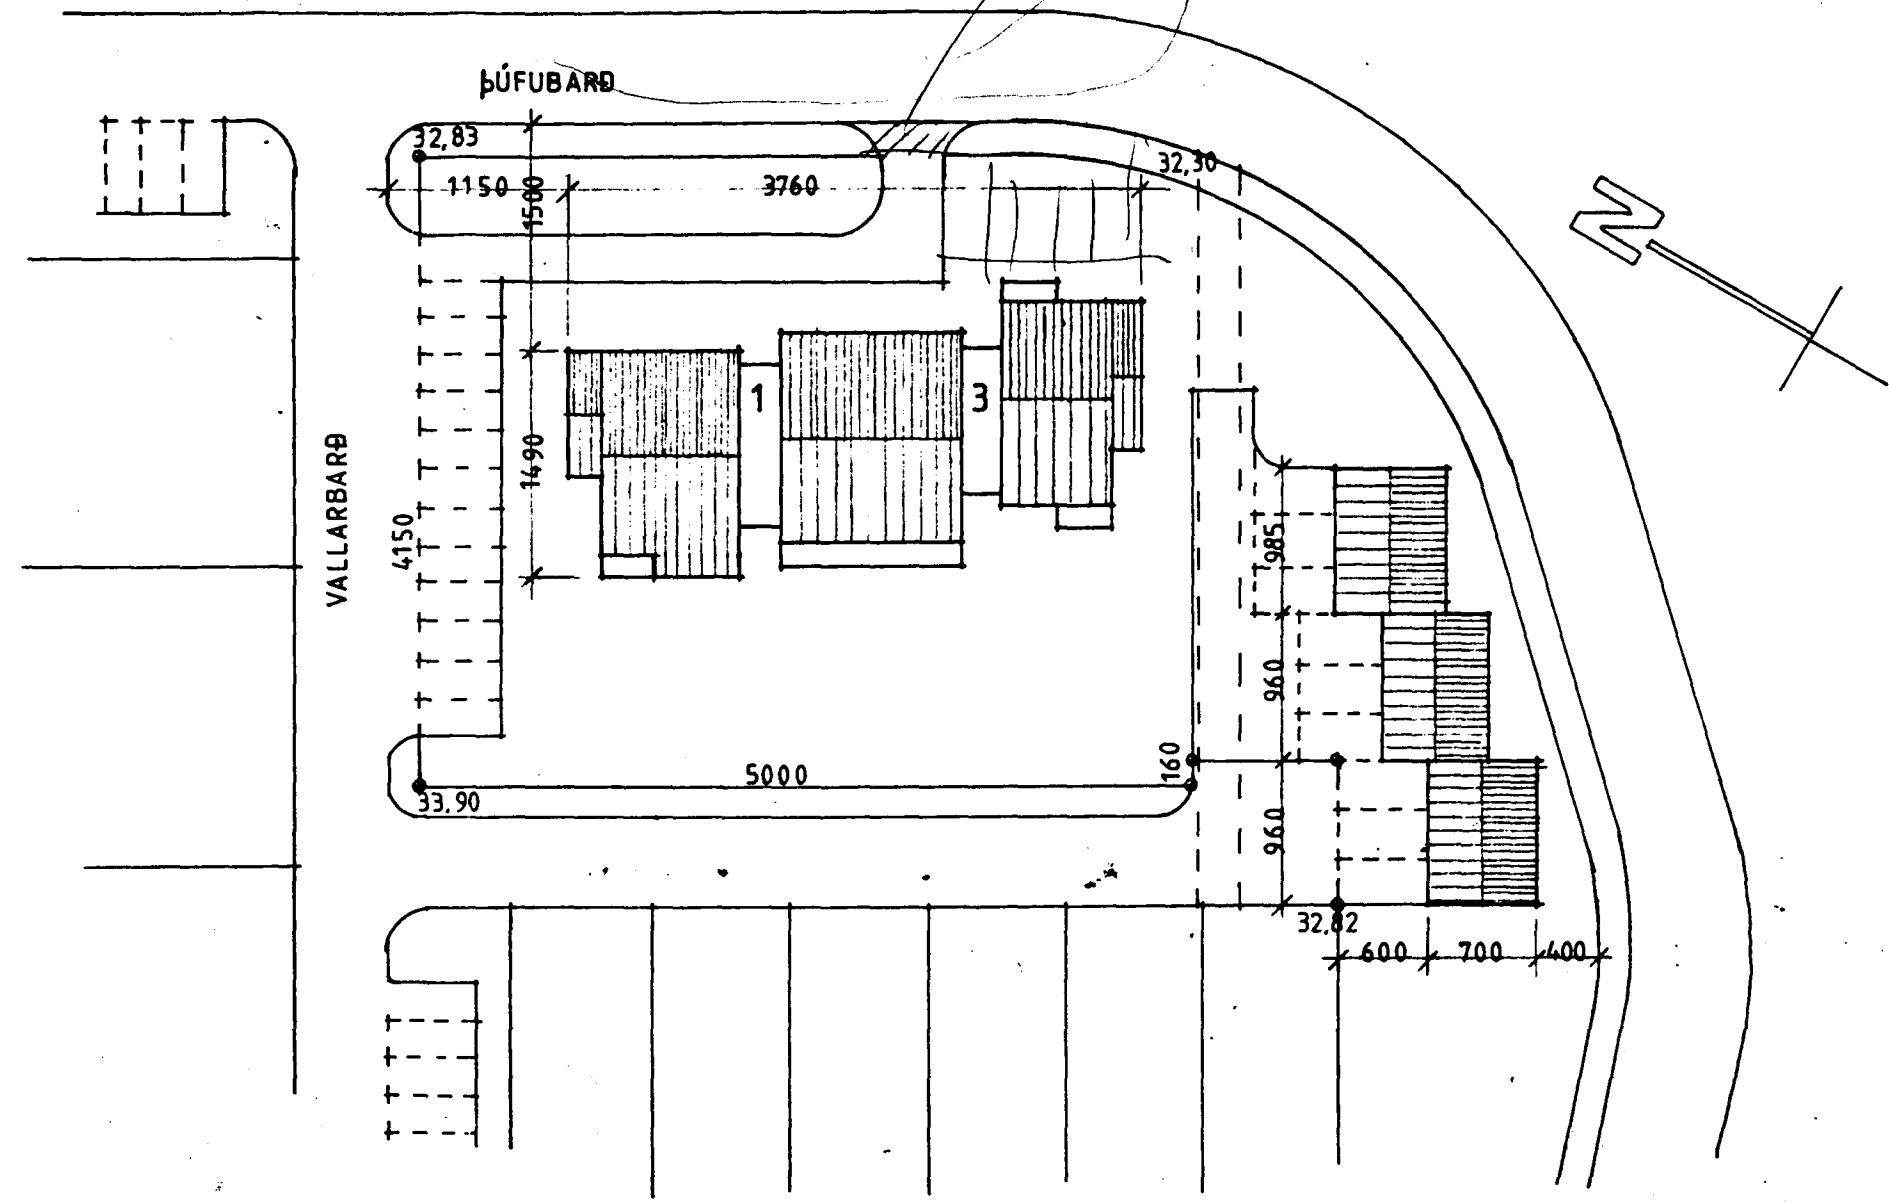

9030-0010 . 01
02
03

VERKEFNI VALLARBARÐ 1-3 HAFNARFIRÐI
HEITI AFSTÖÐUMYND

M. 1 500
T.
DAGS. NÓV. 1983

NR. 408-1-