




tiffpdf - www.rubissoftware.com - Demo Version

*Handwritten notes:*  
17/1  
17/1

*Handwritten note:*  
gangstétt í segun!  
2/5 85 RA

**BRÚTTÓSTARÐIR:**

<b>VALLARBARÐ 1</b>	
01 01	70,5 m <sup>2</sup>
01 02	66,8
01 SAMEIGN	66,0
01 GEYMSLUR	43,4
01 SAMT	246,7 m <sup>2</sup> 246,3
<b>02</b>	
02 01	83,6
02 02	80,1
02 03	66,8
02 SAMEIGN	24,8
02	255,3 m <sup>2</sup> 252,1
<b>03</b>	
03 01	83,6
03 02	80,1
03 03	66,8
03 SAMEIGN	24,8
03	255,3 m <sup>2</sup> 252,1
	<del>757,3 m<sup>2</sup></del> 762,5
	2410,0 m <sup>3</sup>
<b>VALLARBARÐ 3</b>	
01 01	66,0
01 02	70,5
01 SAMEIGN	52,6
01 GEYMSLUR	27,0
01	216,1 m <sup>2</sup> 215,5
<b>02</b>	
02 01	117,8
02 02	83,6
02 SAMEIGN	22,5
02	223,9 m <sup>2</sup> 226,5
<b>03</b>	
03 01	117,8
03 02	83,6
03 SAMEIGN	22,5
03	223,9 m <sup>2</sup> 226,5
	<del>643,9 m<sup>2</sup></del> 648,5
	2108,0 m <sup>3</sup>
<b>BÍLSKÚRAR</b>	
	205 m <sup>2</sup> 206,1 m <sup>2</sup>
	687 m <sup>3</sup>

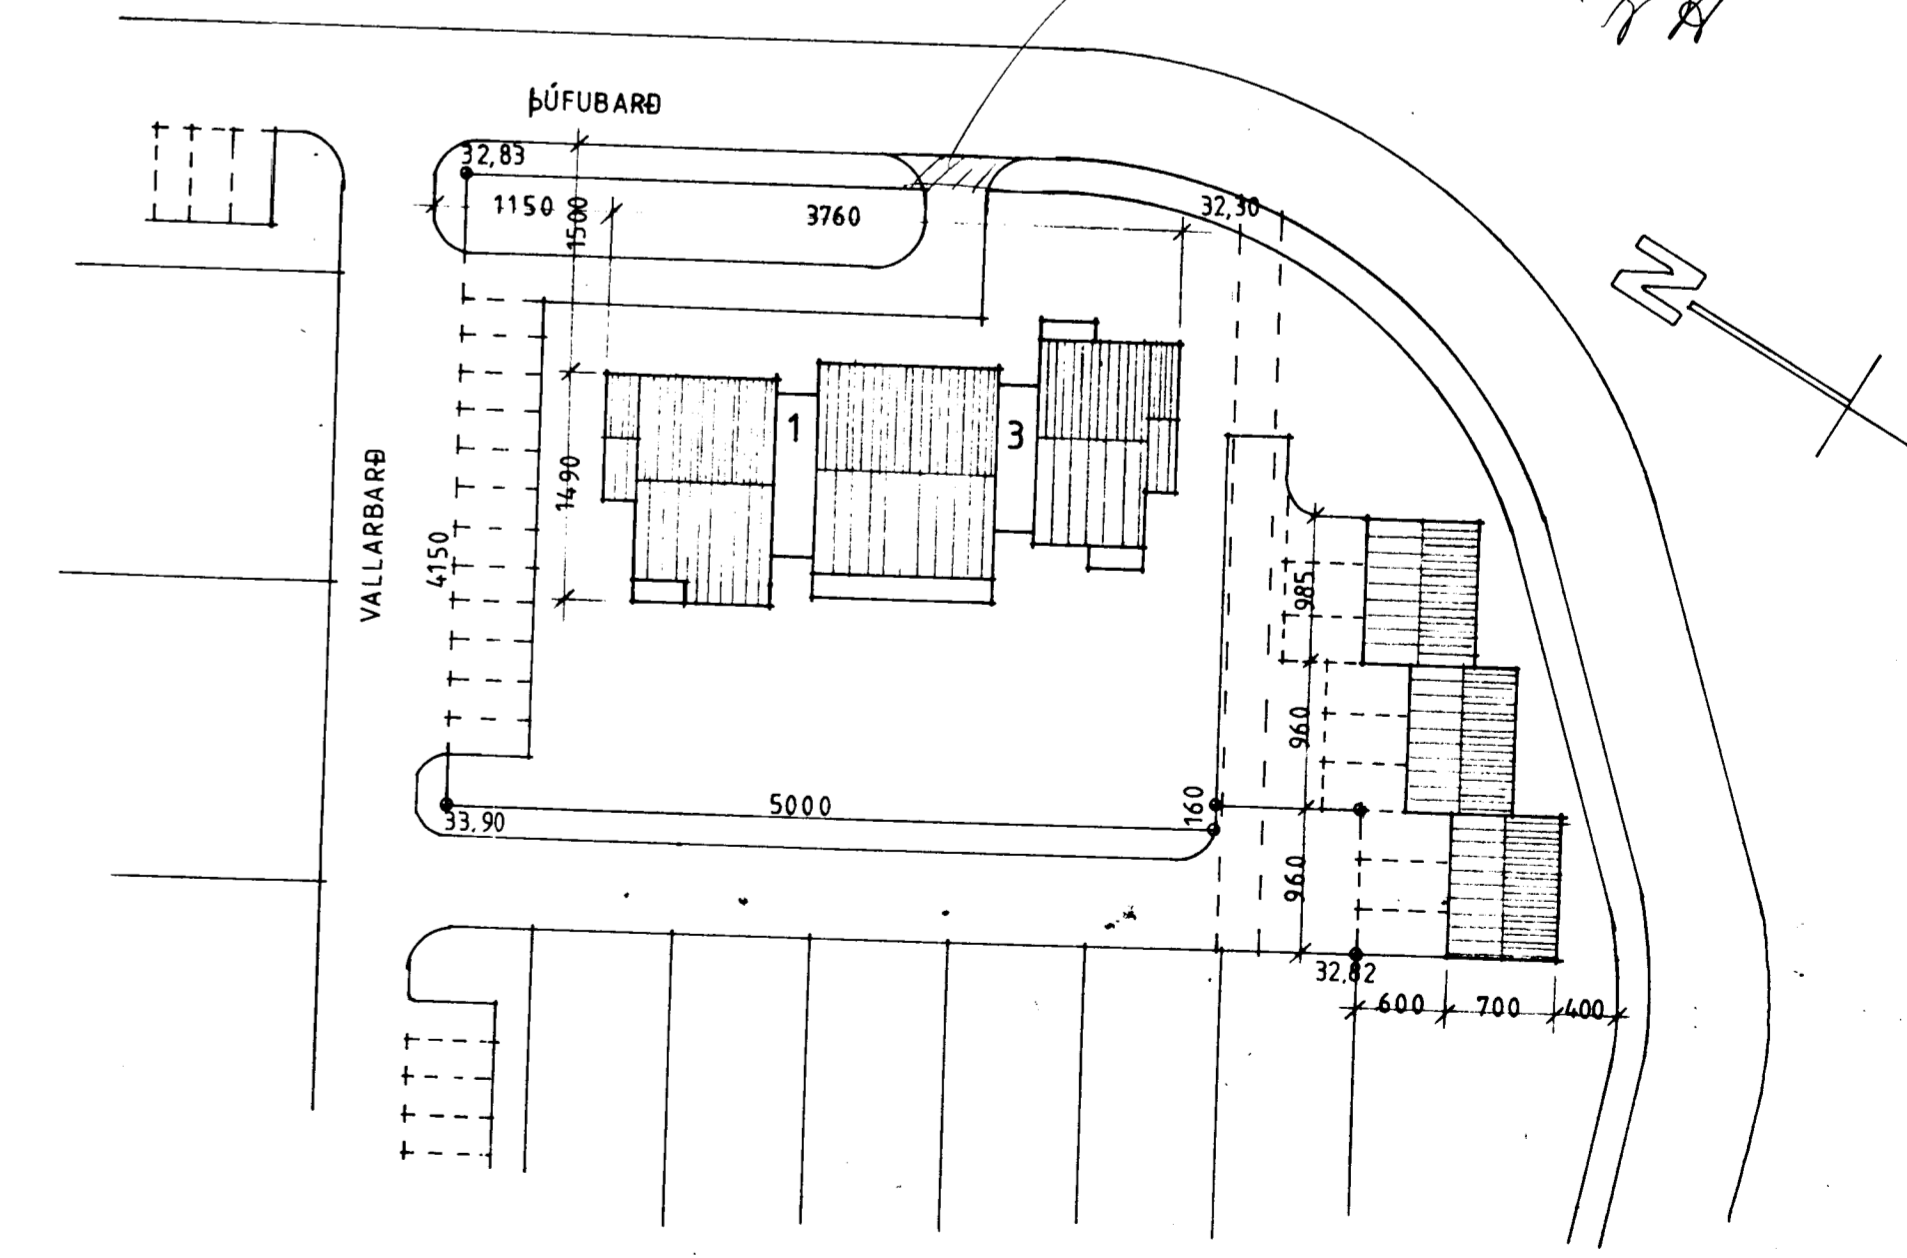

ARKITEKT FAI  
ARKITEKT FAI  
*[Signature]*