




Vallarbaró 19. Hafnarfirði.

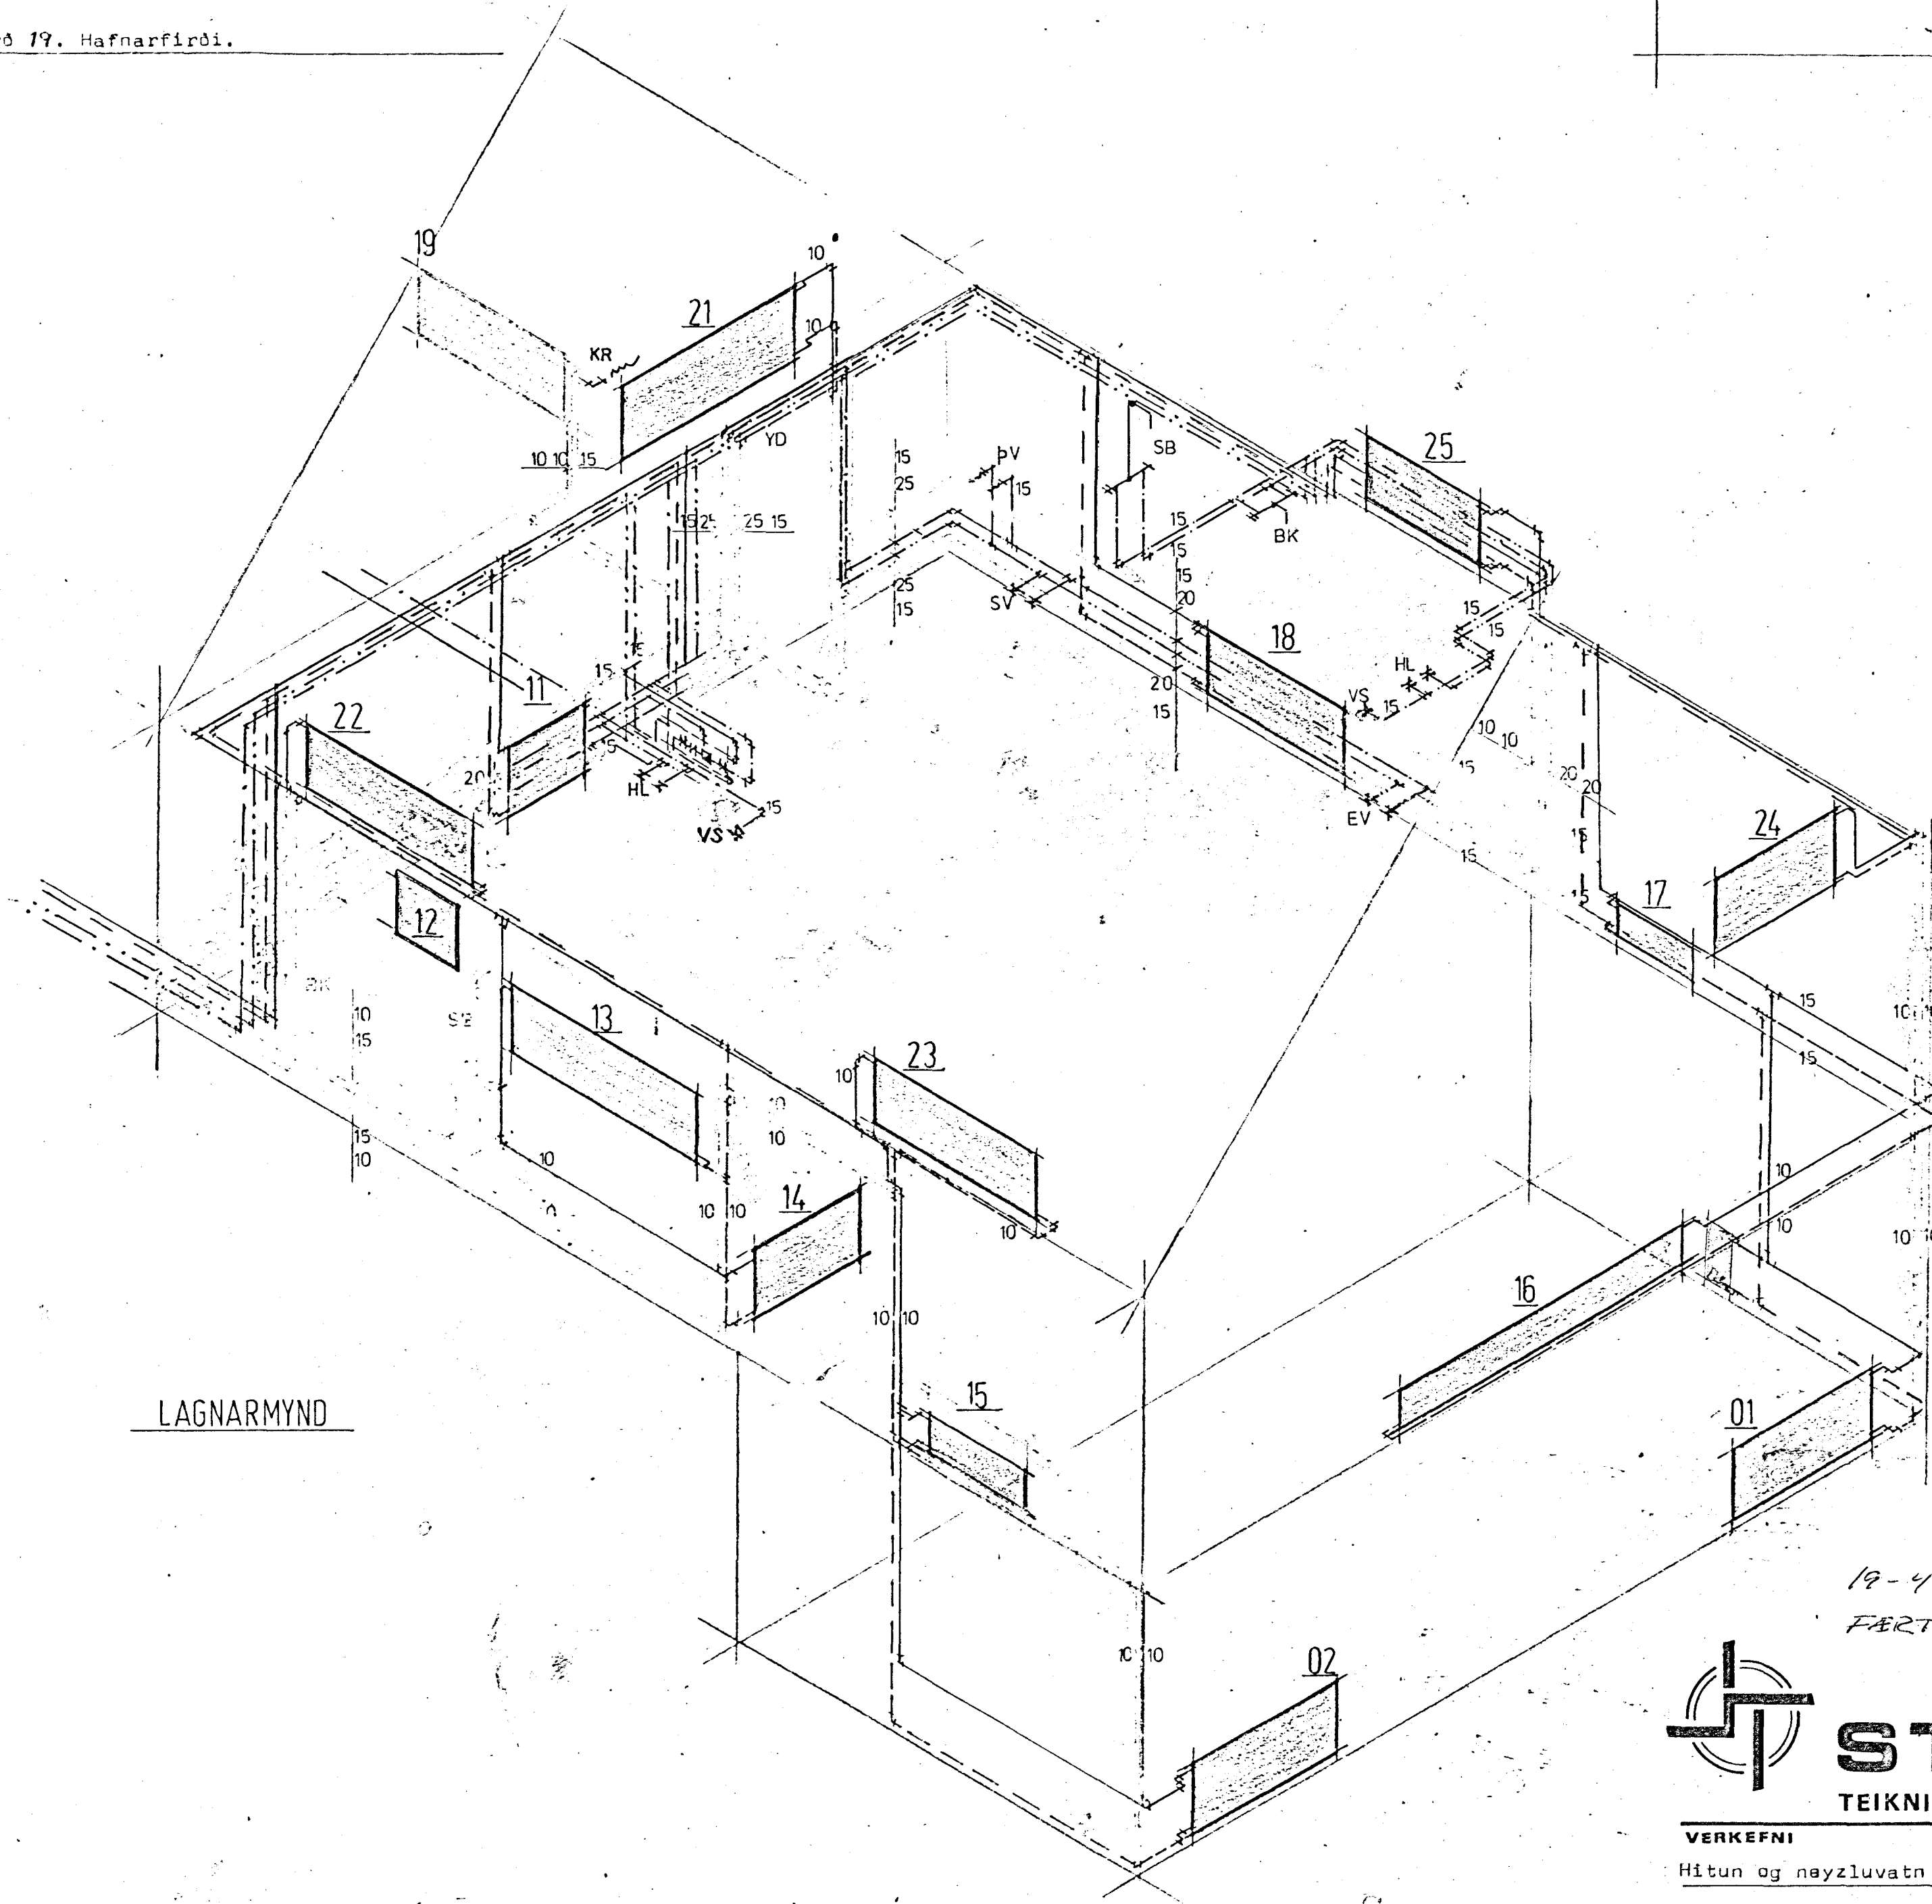

LAGNARMYND

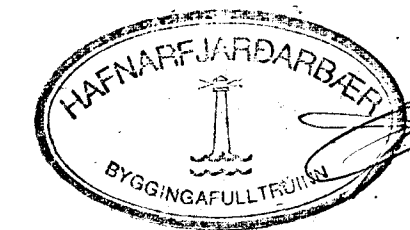

19-4-88 G.H. S.U.J.
FÆRT EINS OG LAGNARERU

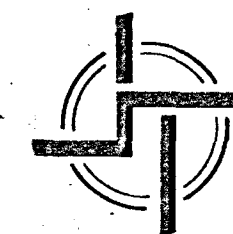

STÖÐALHÚS

TEIKNISTOFA SIÐUMÚLA 31 SÍMI 83141

VERKEFNI	DAGS.	1984.	VERK NR
Hitun og nøyzluvatn Lagnarmynd.	MKV.		
Vallarbaró 26. Hafnarfirði.	BR.		
	BLAD NR	3.07.	ST 160.

SIGURÐUR GUDMUNDSSON SIGURÐUR P. KRISTJÁNSSON FTFÍ