


RÚMMYND VATNSLAGNA A 1:50

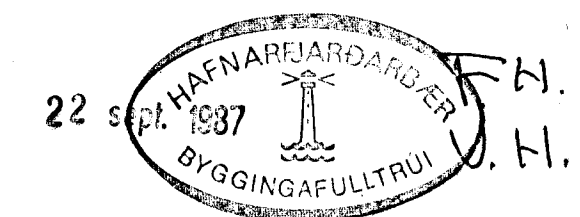

01	8.10.87	BR. SKV. ÖSK. EIGANDA	
BR. NR.	DAGS	EDLI BREVINGAR	SIGN.
VALLARBARE	5	HAFNARFIRDI	DAGS MARS'87
RÚMMYND HITLAGNA.			HANNA
MELIKV. A 1:50			TEKNAÐ
SIGURÐUR ÞORLEIFSSON	TEKNIFRÆÐINGUR F.T.F.I.		VERK NR. 8111
STRANDGÖTU 11	HAFNARFIRDI	SÍMI 54751	BLAD NR. 2-04