


GRUNNMÝND ~ 1:50

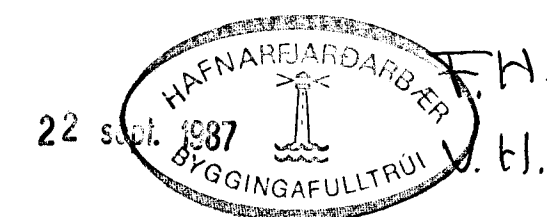

BR. NR.	DAGS	EBLI	BREYTINGAR	SIGN.
01	8.10.87	ÖFN	112 OG 113 FERDIR, 104 STEK, 103 UT ÖV FERDIR SUÞILS	
VALLARÐARD 5 HAFNARFIRÐI				DAGS. MÆS. 87
HITA VATNS- OG FRÁKENNISLAGNIR.				HANNAÐ
MÆLIKV. 1:50				TEKNAÐ
SIGURÐUR ÞORLEIFSSON TEKNIFRÉÐINGUR F.T.F.I.				VERK NR. 8411
STRANDGÖTU 11 HAFNARFIRÐI SÍMI 54751				BLAD NR. 2-03