


4

3




Gætt af fundi byggingar-
 nefndar 28.9.83
 Breytt
 Daniel Friðriksson

'Akvörðun um bilg. festu'
 F. Sig.

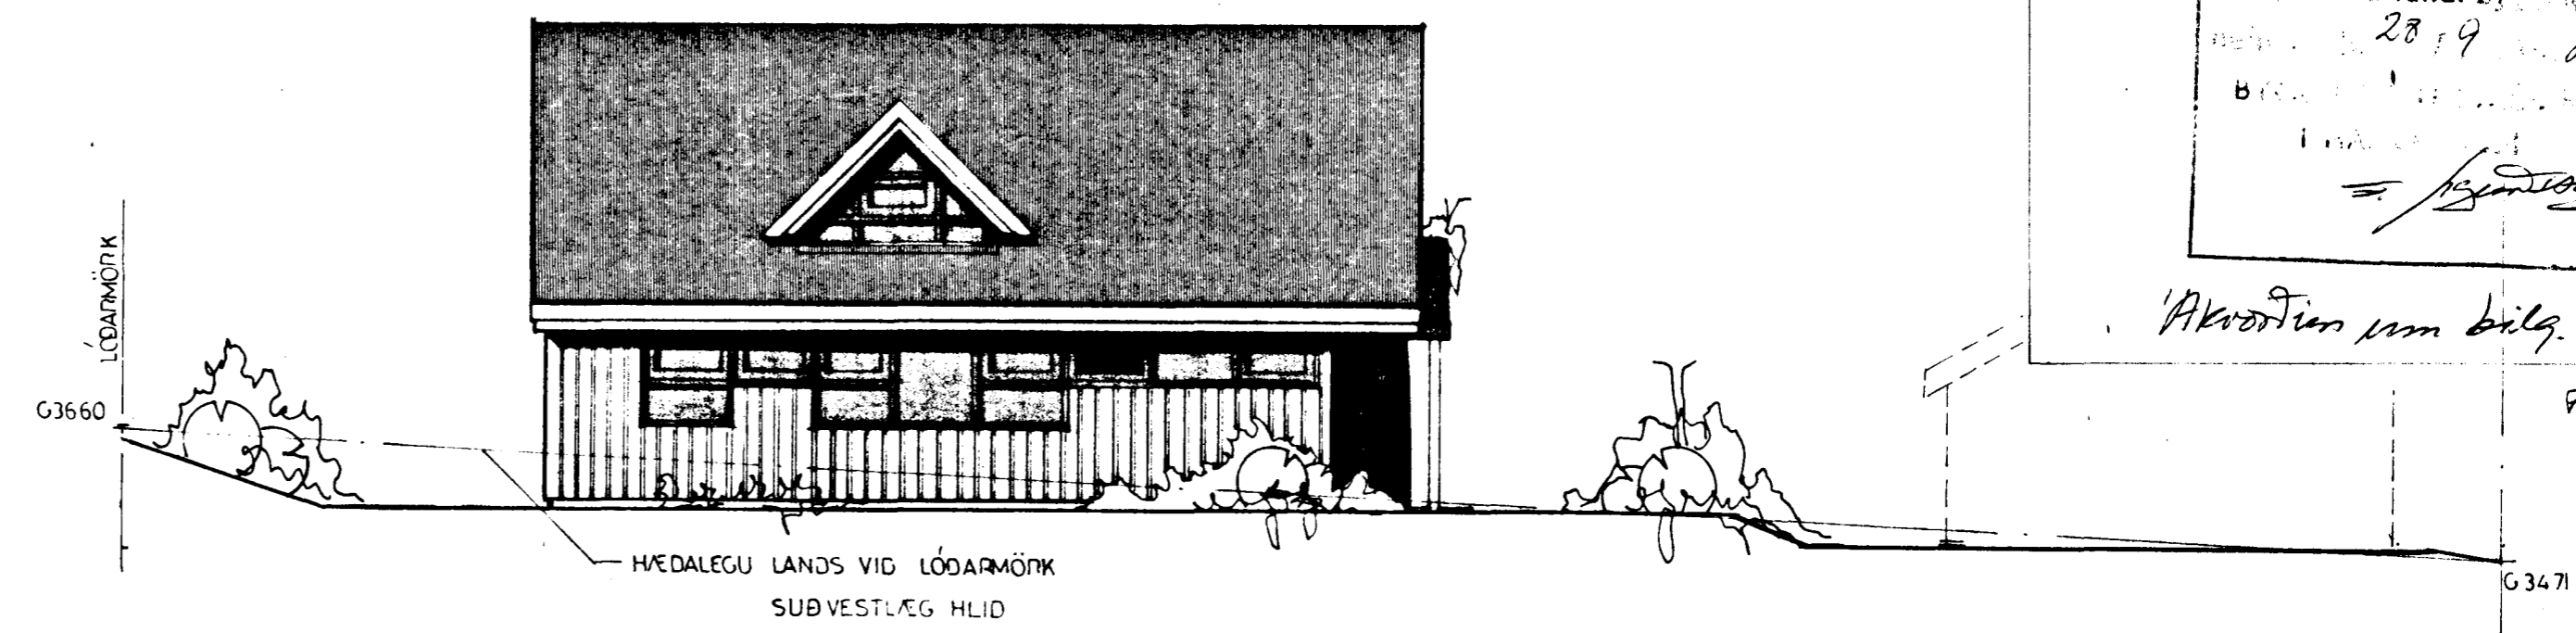

1
2


2

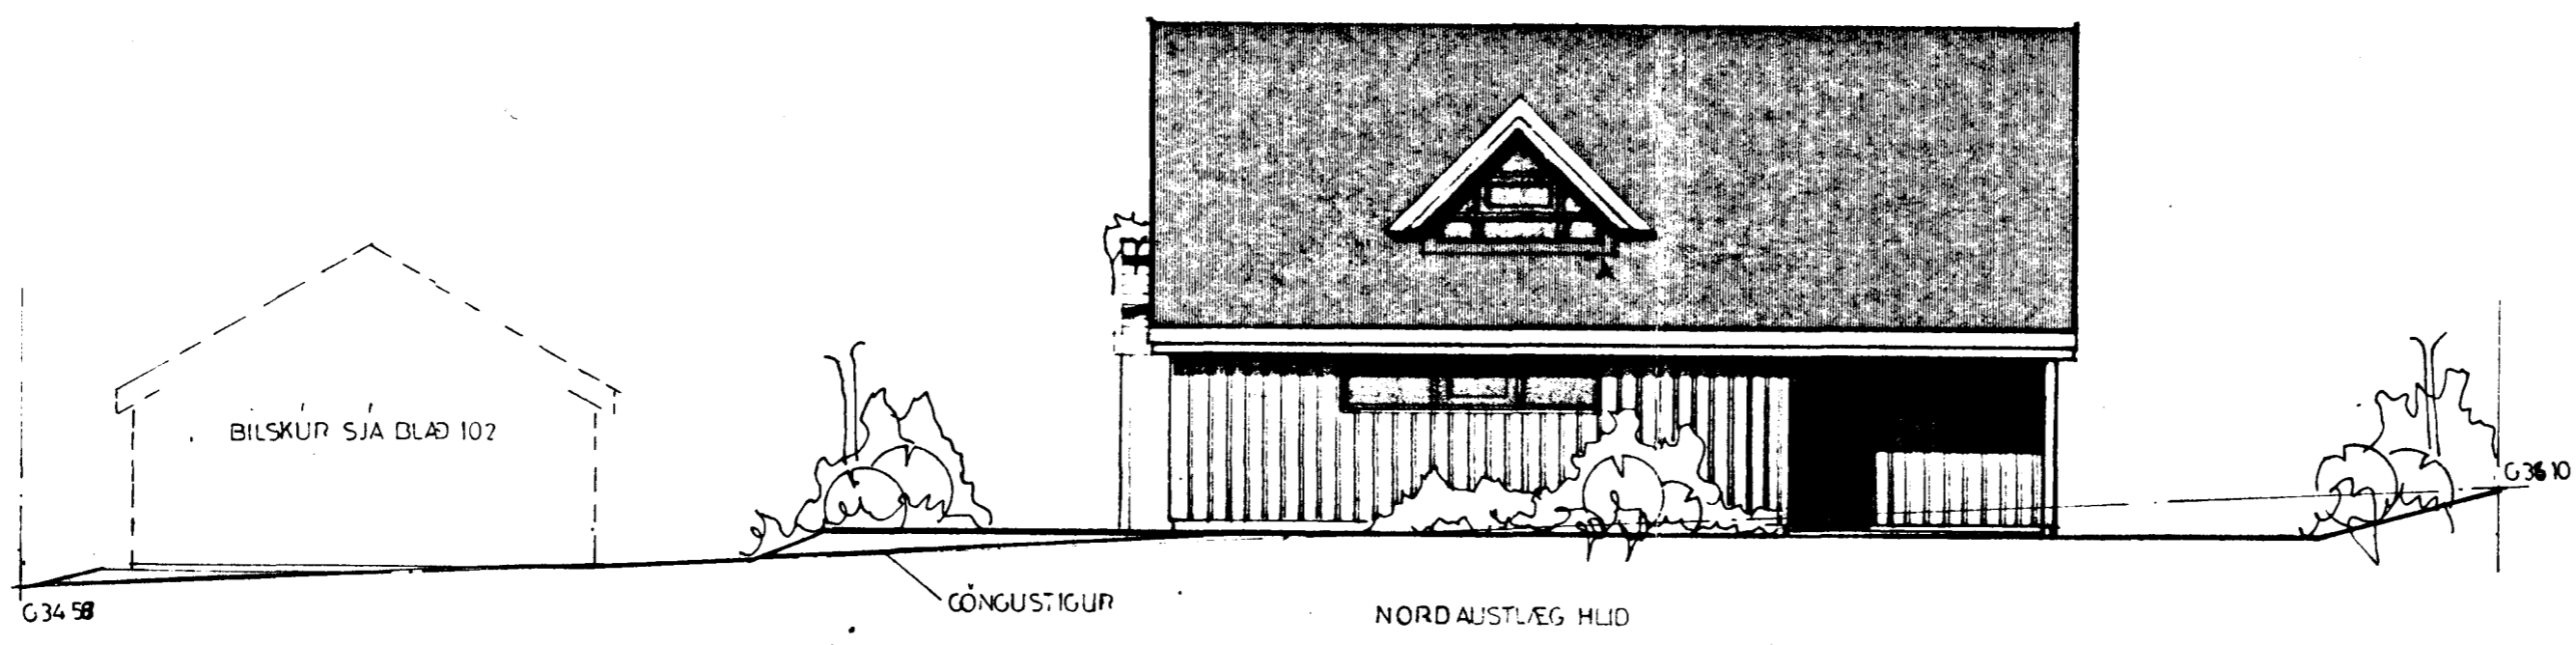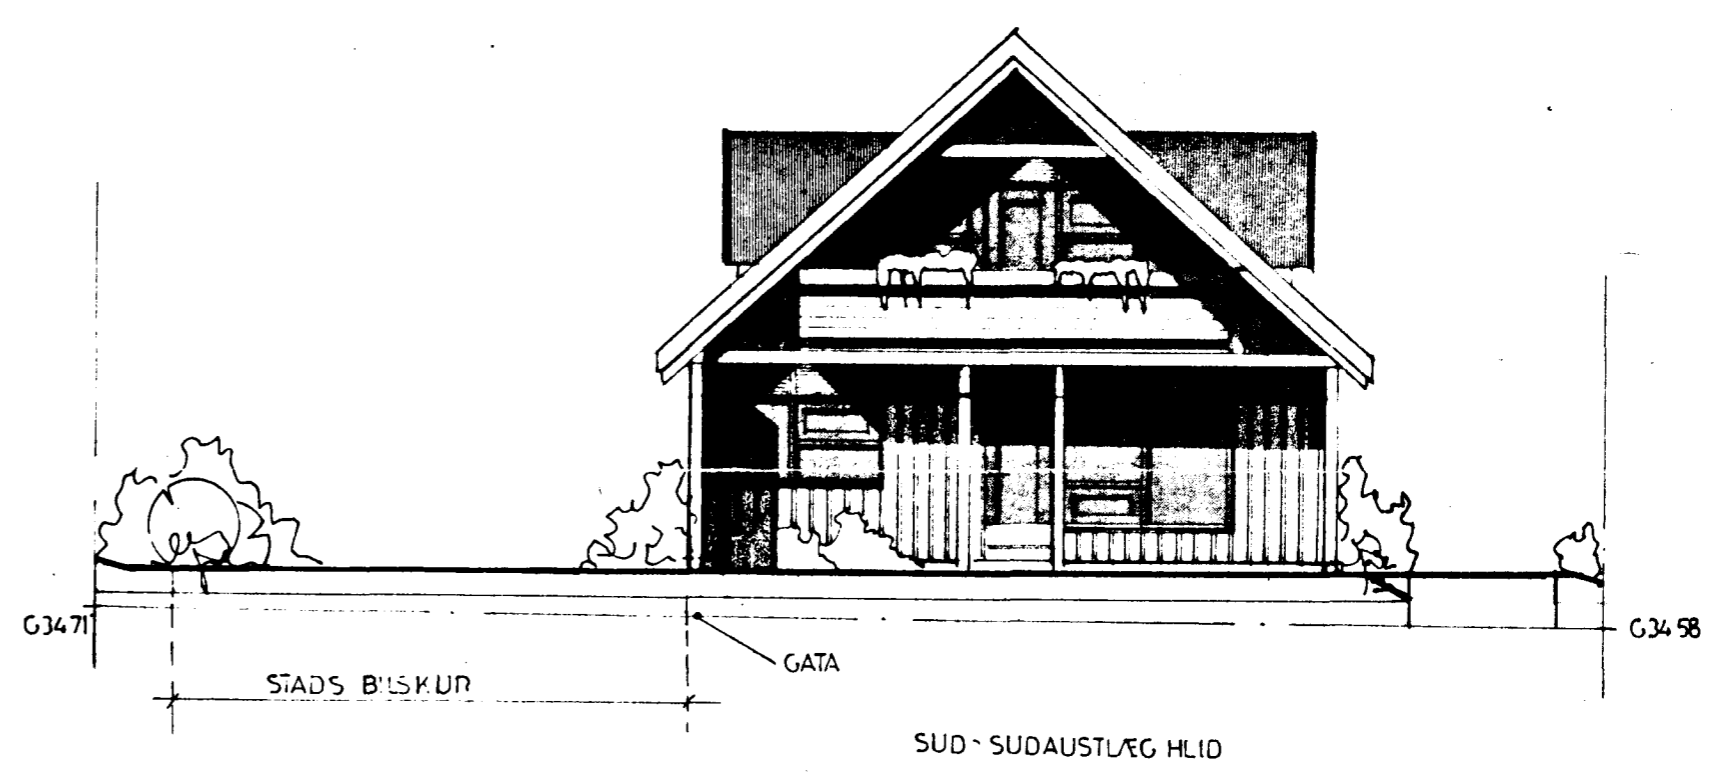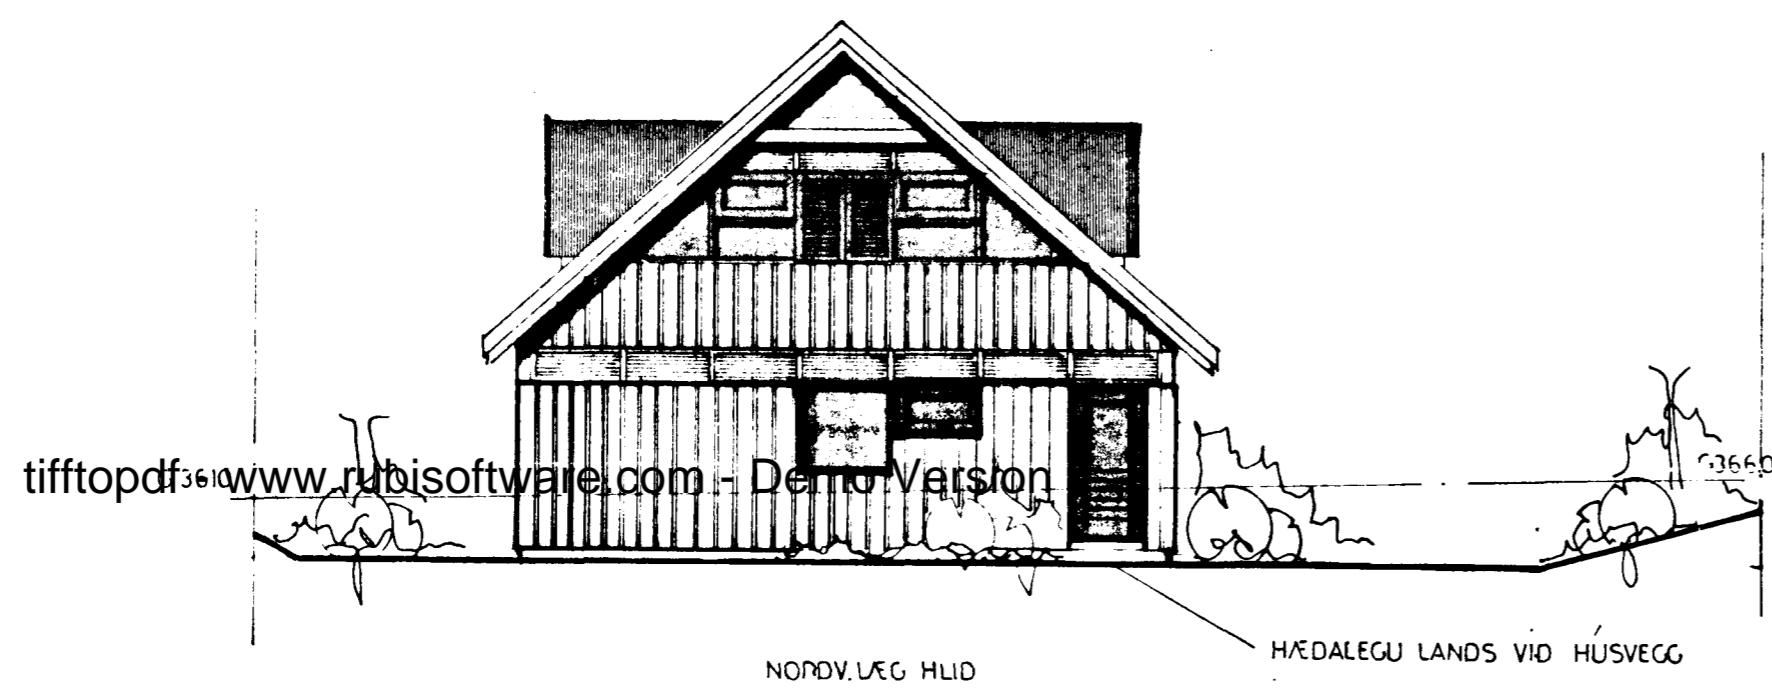

9030-0080-01

4

3

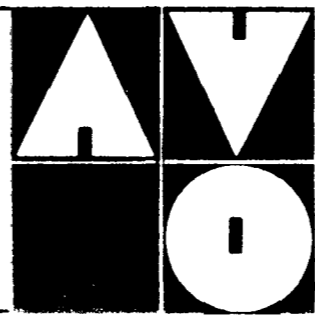

MÆLIKV
 1:100
 DAGS-TEIKNAD
 Ö.K.T. 82 AVG
 HÖNNUN

BREYTT
 SEPT 83 AVG
 SIGN
 Vidar Olsen

VERKEFNI
 DANIEL FRÍÐRIKSSON
 VALLABARD 8
 HAENABRANDI
 TEIKNING
 UTLIT

VERK NR
 293
 TEIKN NR
 101

TEIKNISTOFAN AVO
 A VIDAR OLSEN TFR
 BORGARTUNI 18 RVK
 S 11860