


NR 8

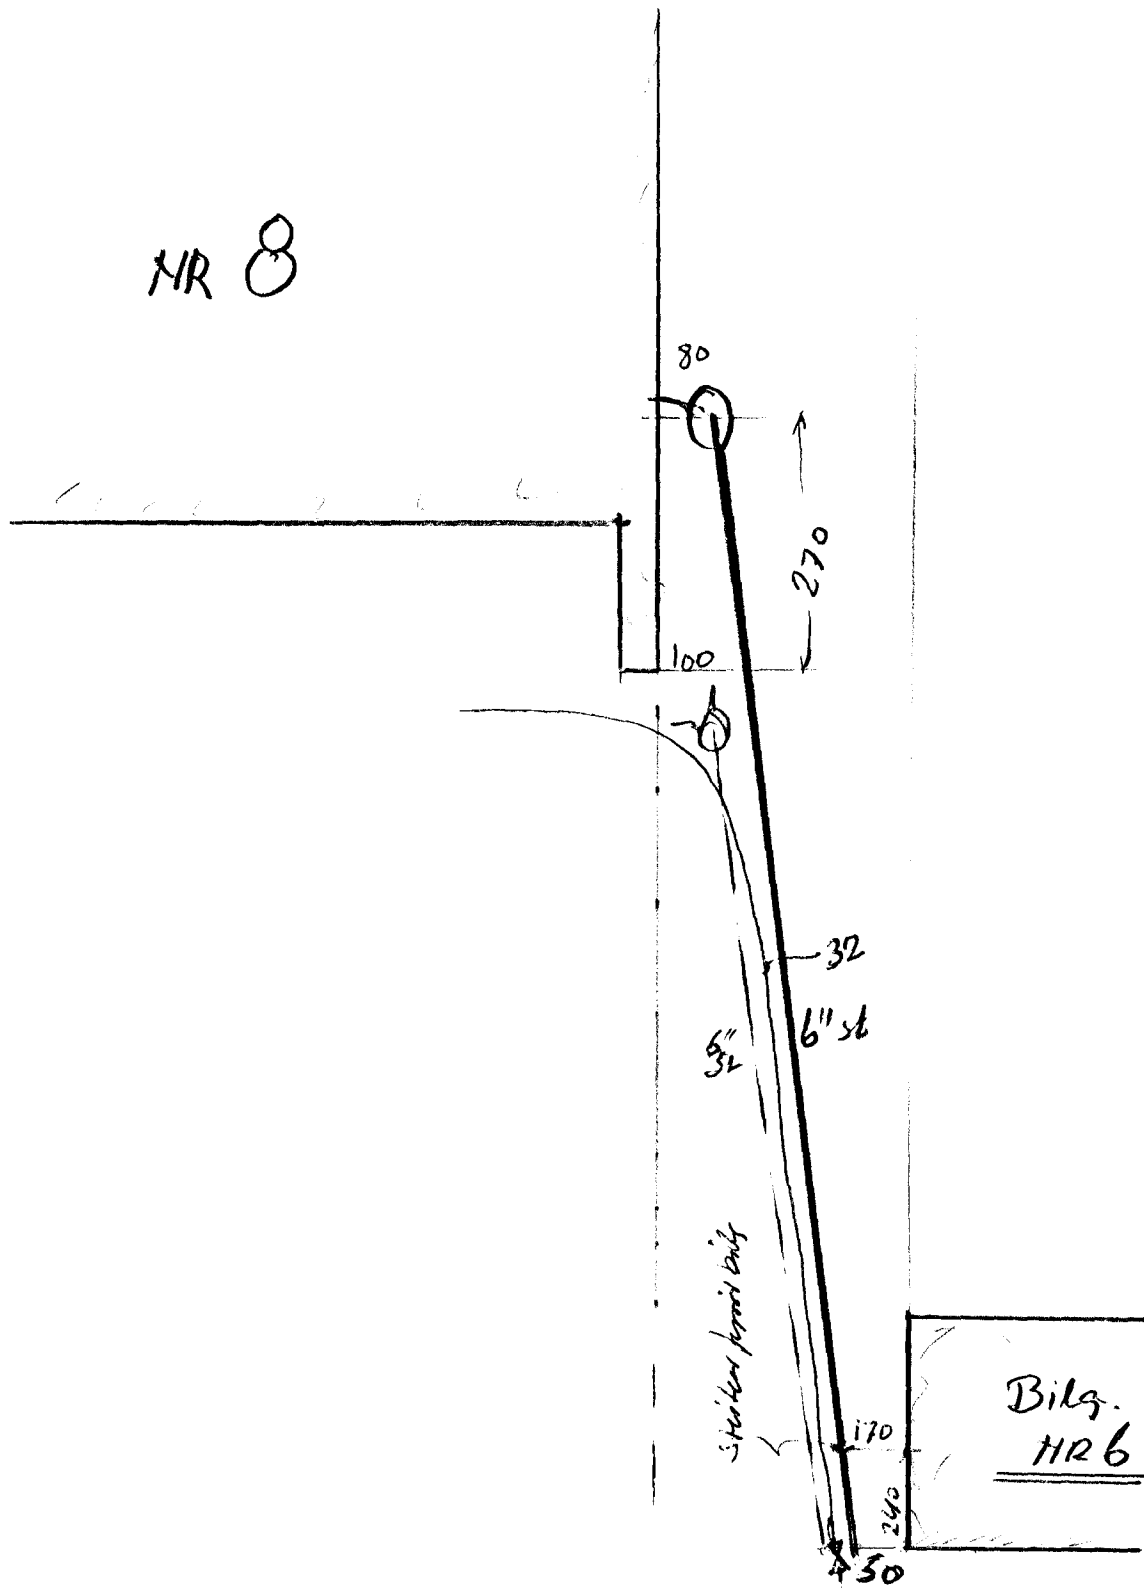

VALLARBADE

22/85
11 F.S.K.