

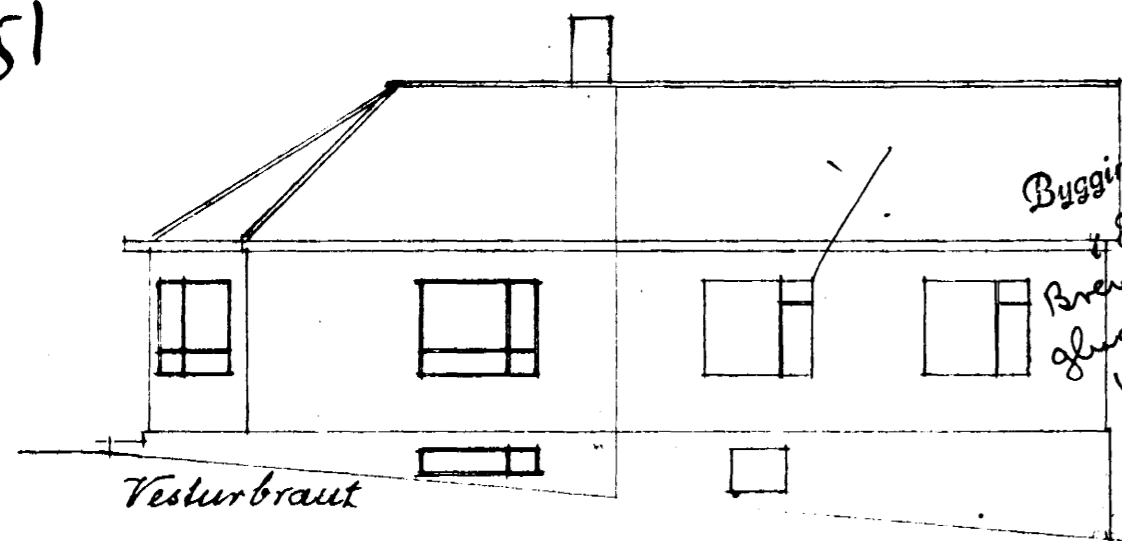
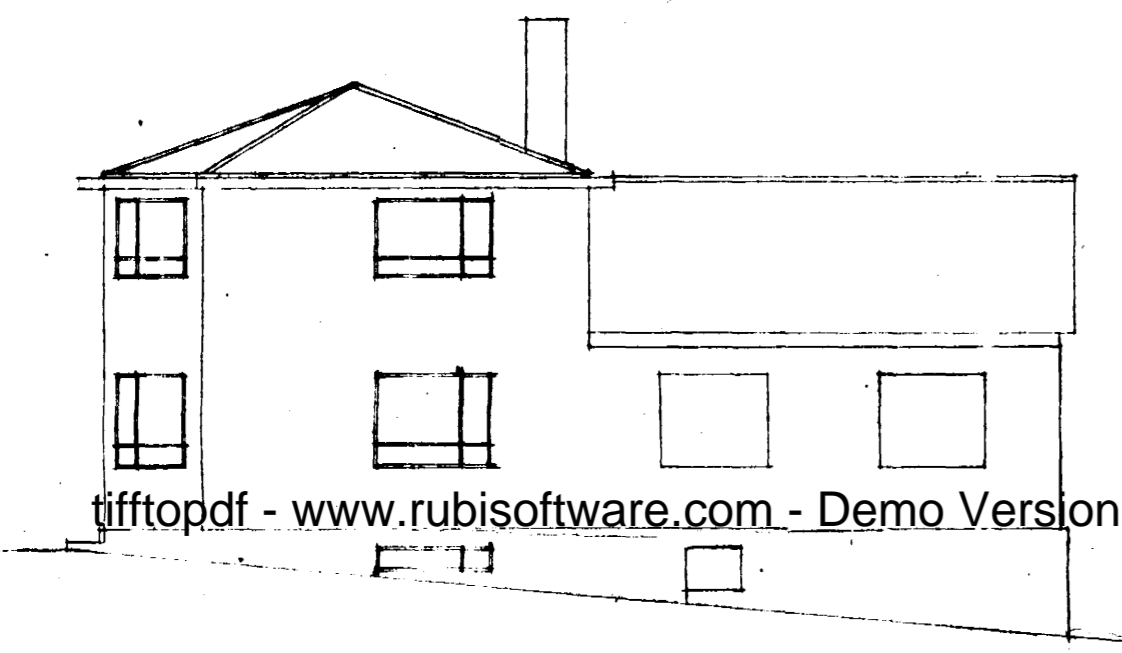
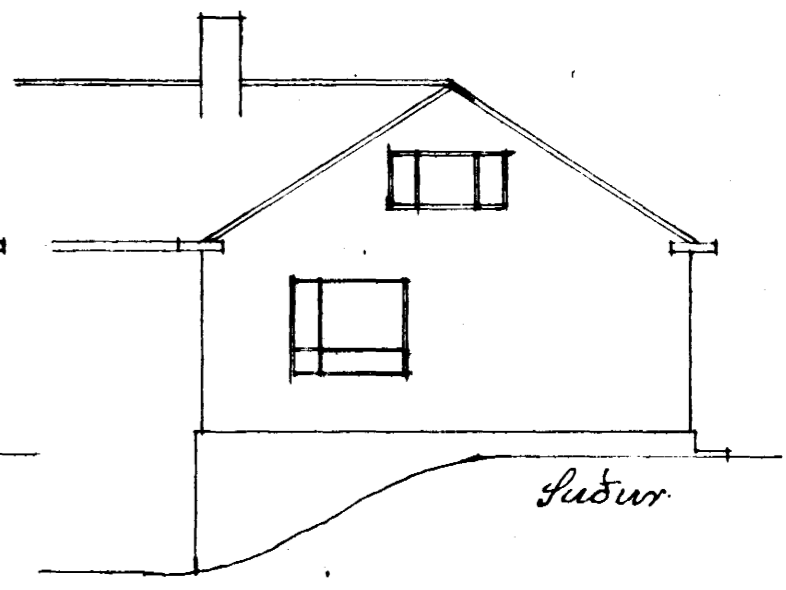






SP. 151
14/6 51

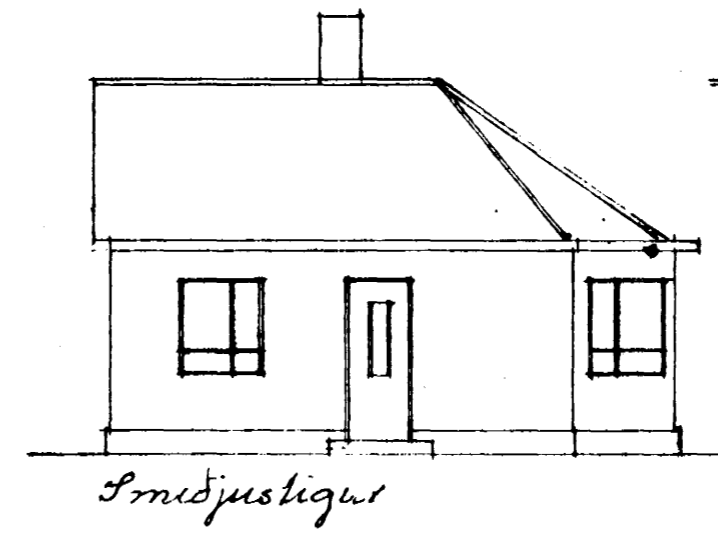


Byggingafullrúnn
á Hafnarfirði
Breitt spannum
gluggum 2-6' 6"
Jan Benzon

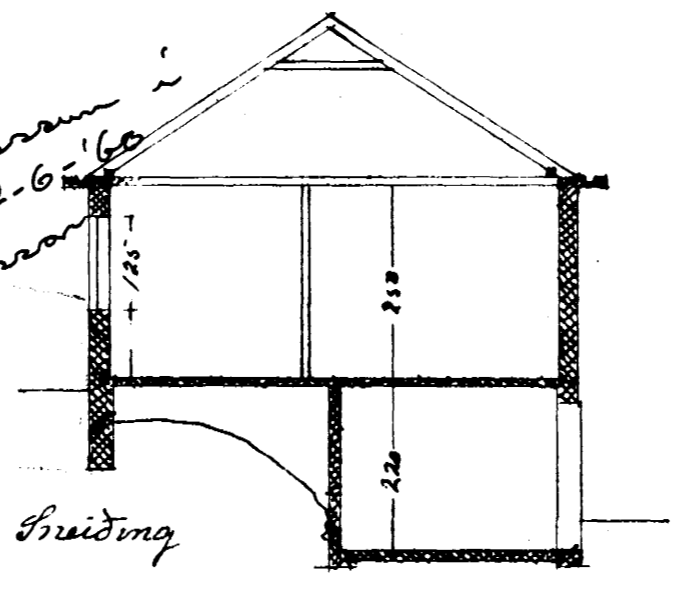


tifftopdf - www.rubissoftware.com - Demo Version

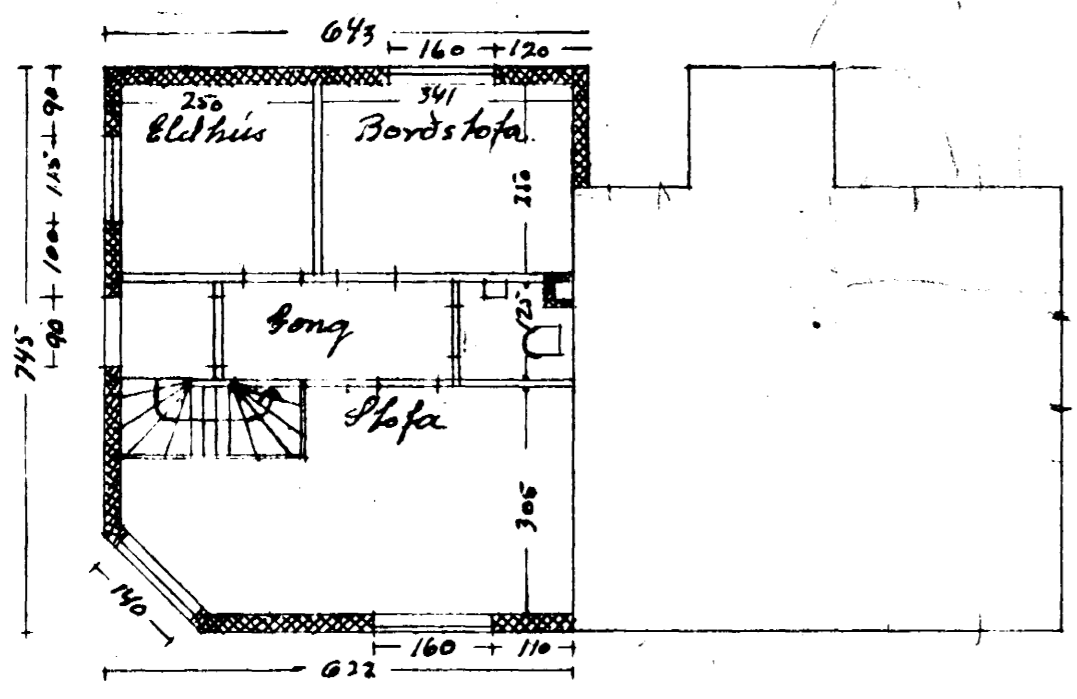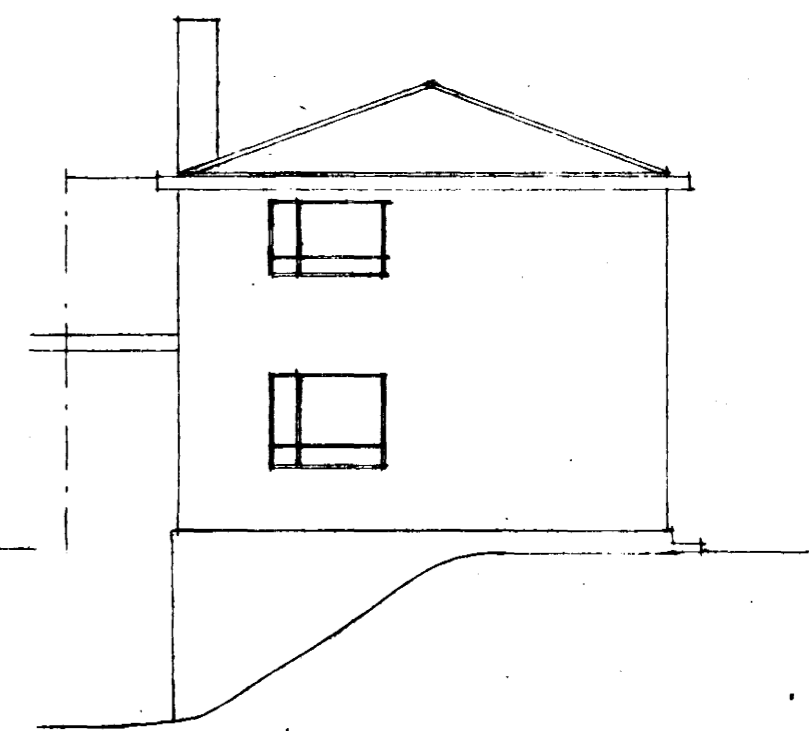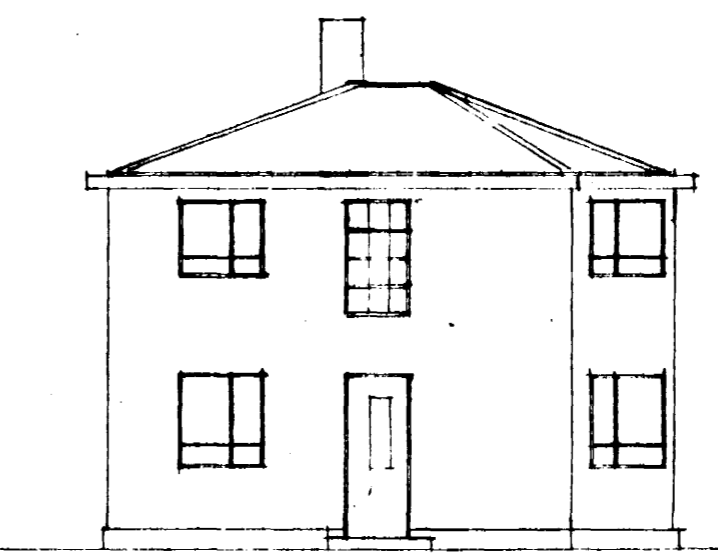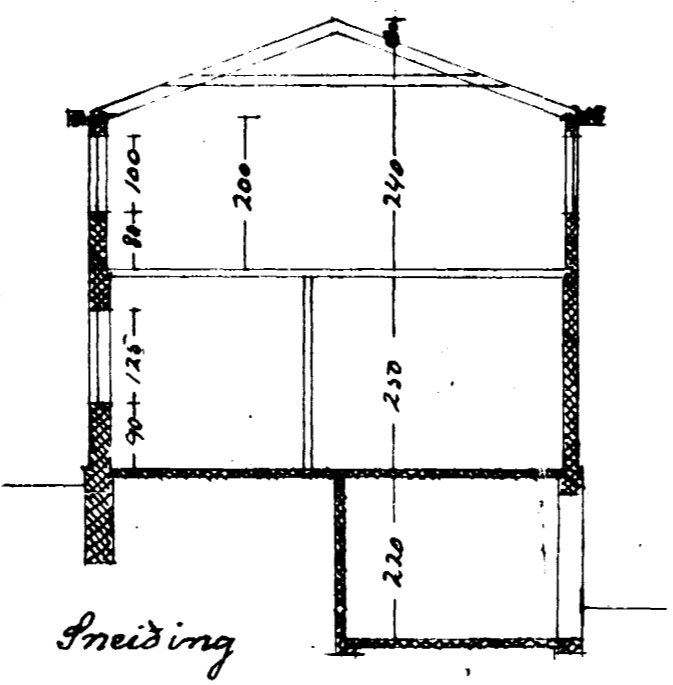


1. hæð

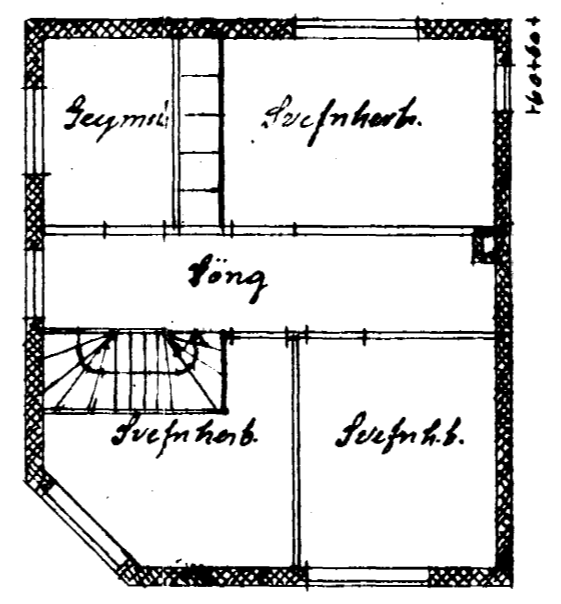

2. hæð

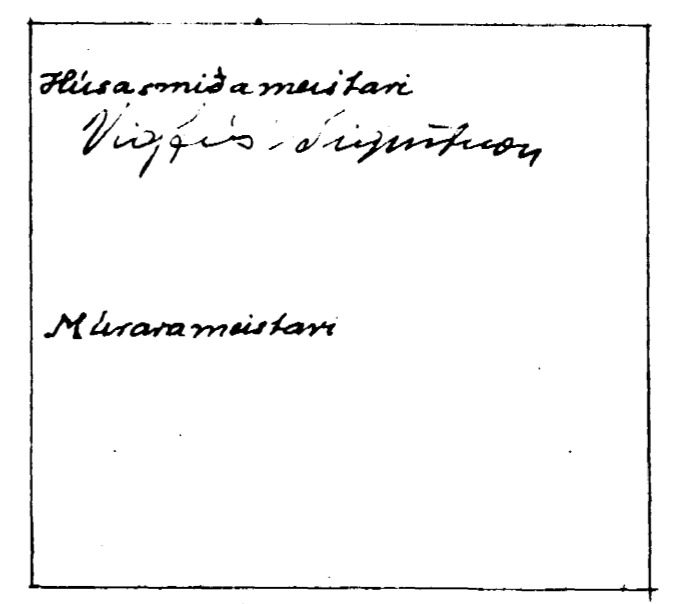

Múraramústari

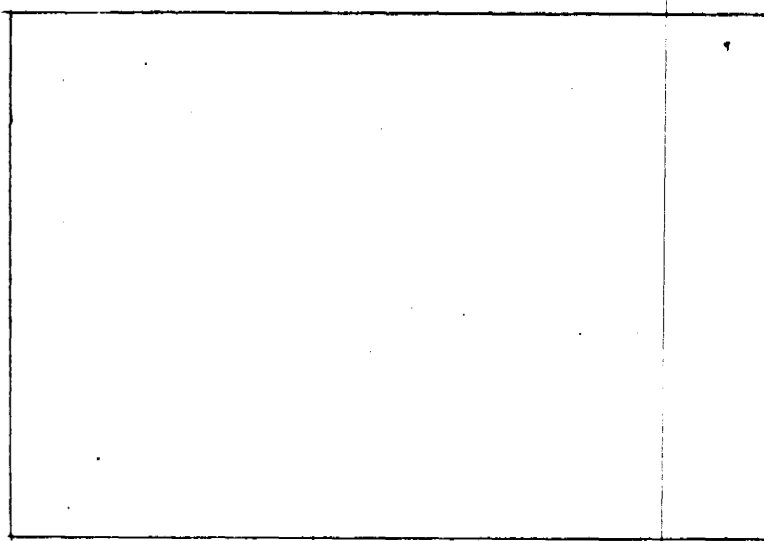

DM hús
nr. 10

Hafnarfirði maí 1951.
Vigfús Sigurðsson.