


NORÐURHLIO

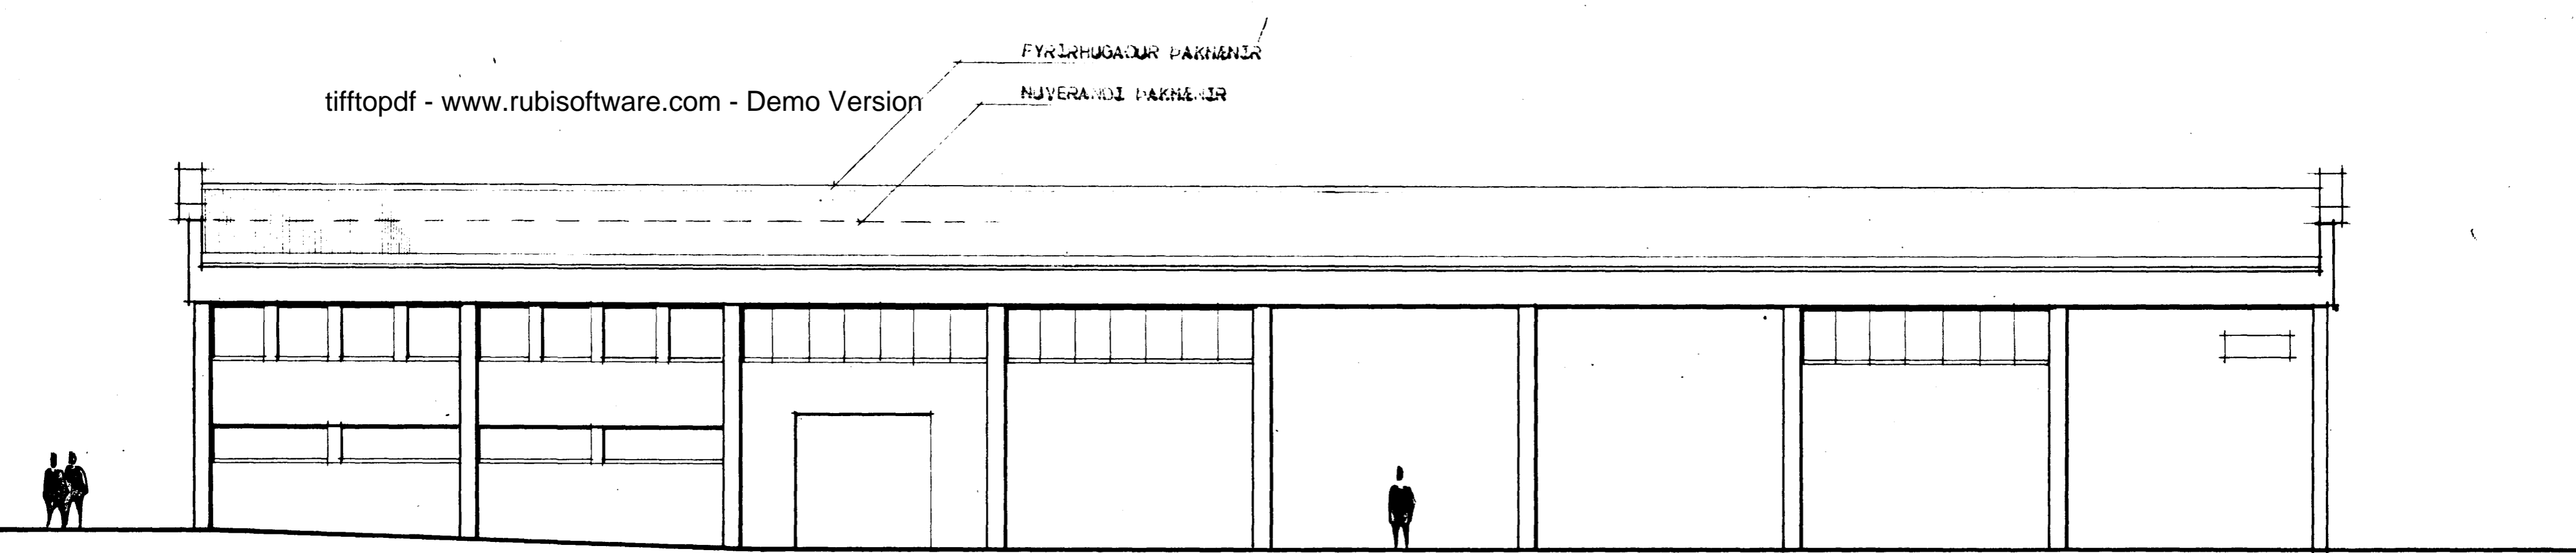

tifftopdf - www.rubissoftware.com - Demo Version

VESTURHLIO

VERKEFNI	MÁL	DAGB. JUL 1972
NORÐURSTJARNAN HF HAFNARFIRÐI	1:100	BR.
BREYTING A ÞAKI (TILLAGA)	TEIKN.	VERK NR.
	REIKN.	TEIKN NR.
	SAMP.	
STADALL TEIKNISTOFA, HVERFISGÖTU 106 A		SÍMI 21930