
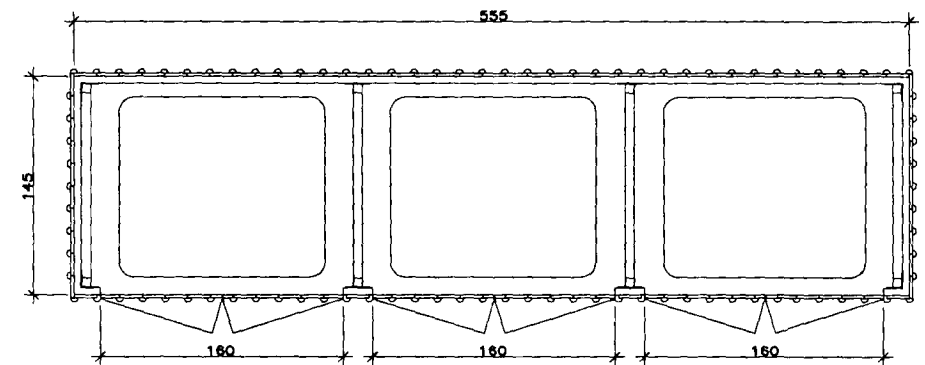
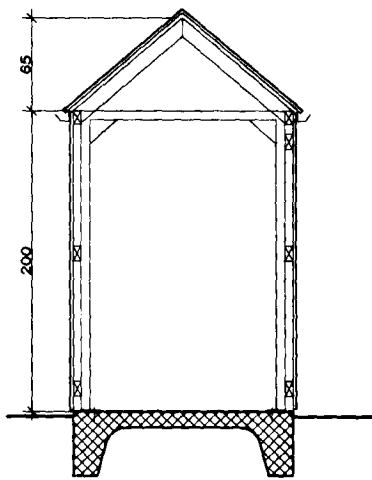






Sjá bókun.

Sorpgæmsla samþ. til bráðab.

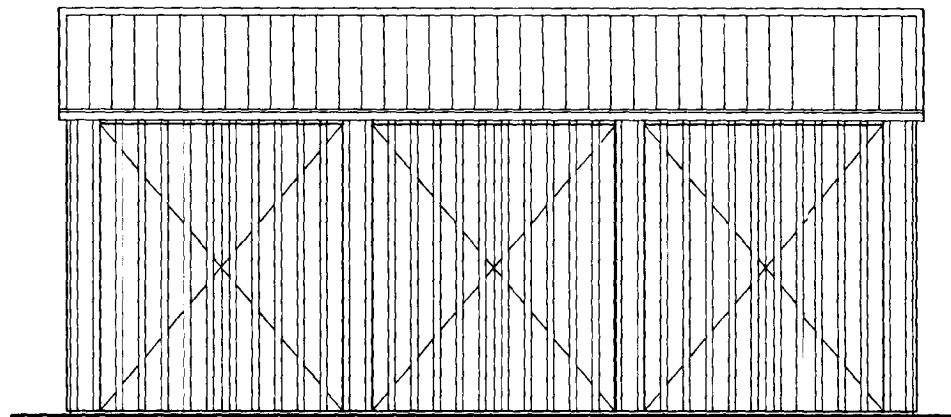

SORPGEYMSLA 1:50

SÖKKLAR STEYPTIR
GEYMSLAN ER ÚR TIMBRI Í SAMRÆMI VÍÐ HÚSID

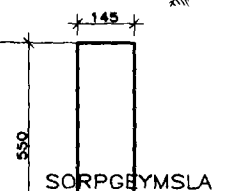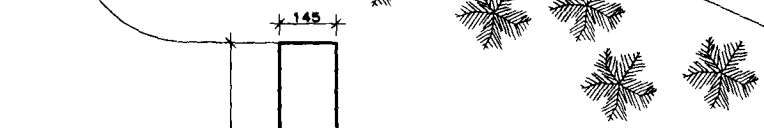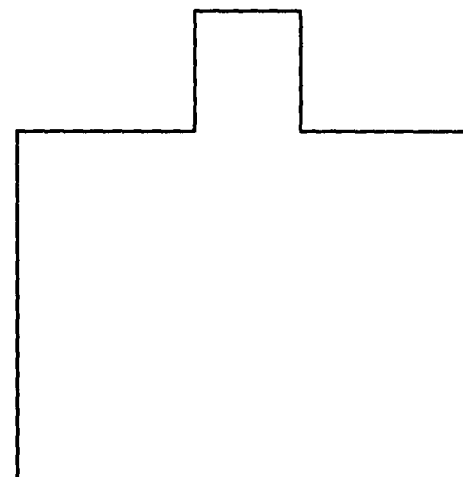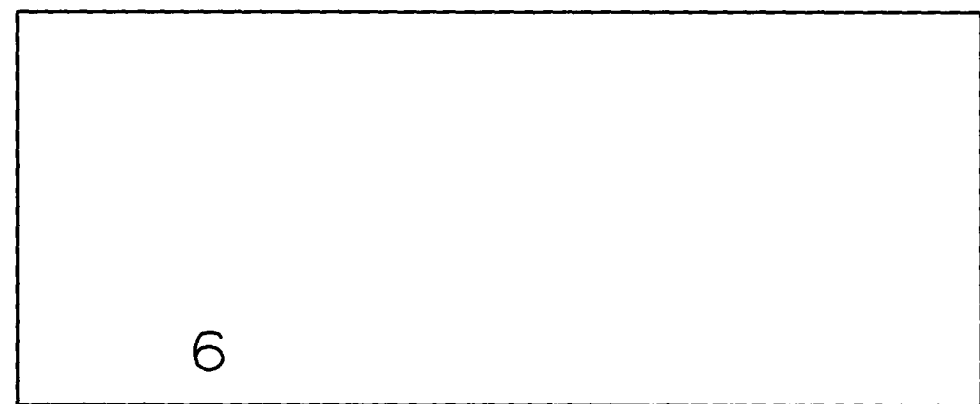

SORPGEYMSLA

680

80

145


4
A.HANSEN

NÚVERANDI GIRDING

GIRDING

470

VESTURGATA

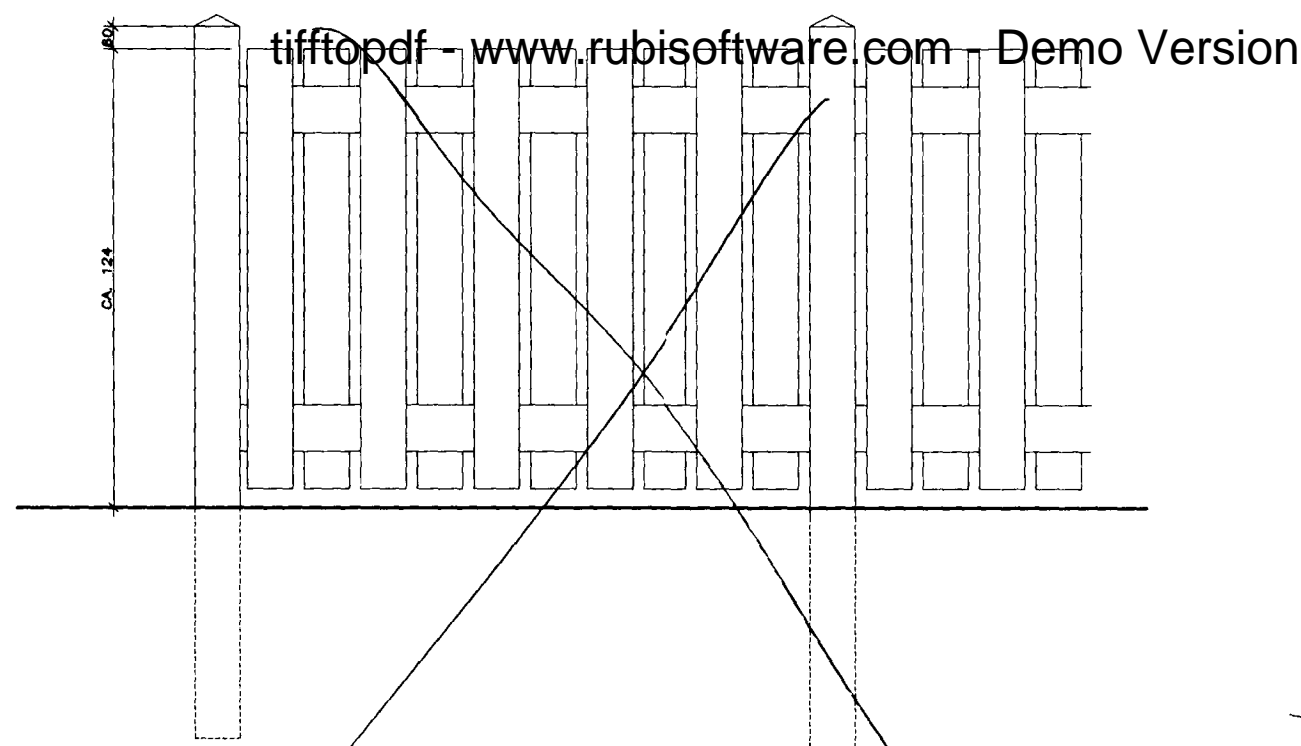

tiffopdf - www.rubissoftware.com - Demo Version

LANGBÖND 4.5X12

STAURAR 12 X 12 SM

GIRDING 1:20