



GRUNNMYND RISHÆÐAR 1:50

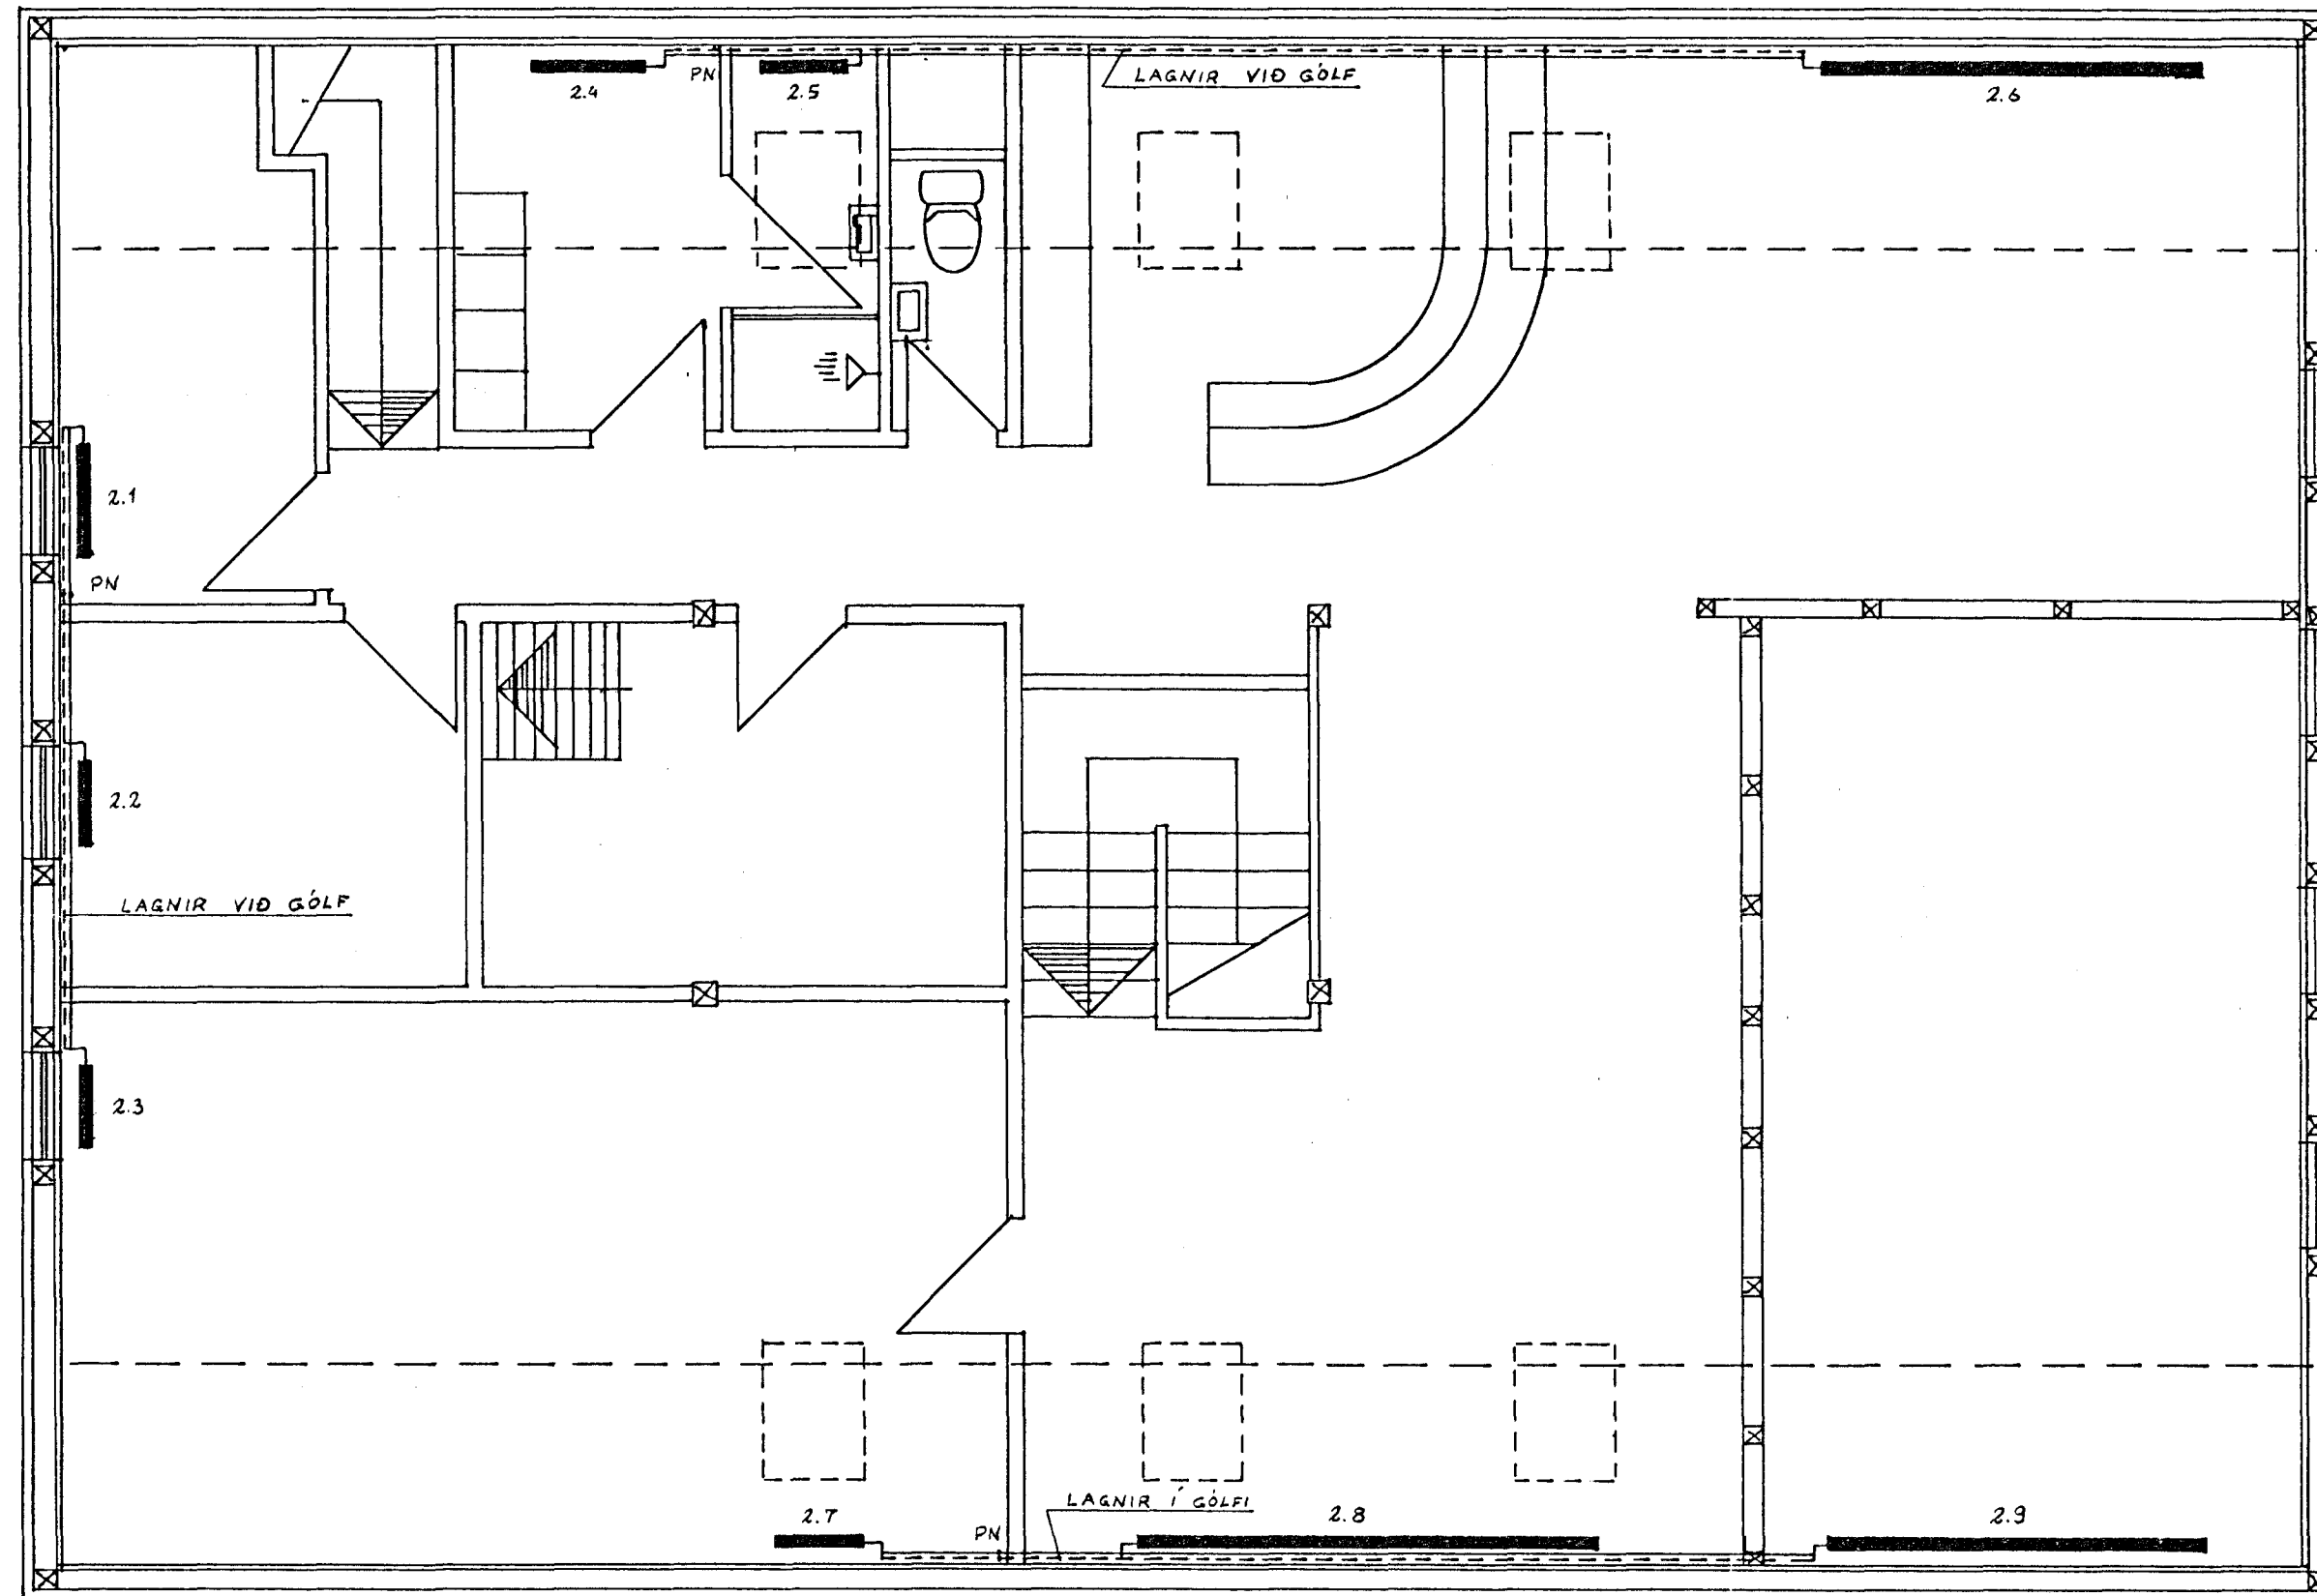

OFNASKRÁ $\Delta T=40^\circ C$

NR	Kcal/h	HÆÐ	LENGD	TENGI
1.1	844	600	800	AB
1.2	1404	500	1200	CD
1.3	623	1500	600	AB
1.4	2109	600	2000	AB
1.5	166	400	480	AB
1.6	799	500	1000	CD
1.7	799	500	1000	AB
1.8	953	1400	600	AB
1.9	1351	600	1000	AB
1.10	1351	600	1000	CD
2.1	744	600	800	CD
2.2	588	600	600	CD
2.3	483	600	600	CD
2.4	276	500	800	CD
2.5	350	500	600	CD
2.6	897	500	2600	AB
2.7	483	600	600	AB
2.8	1104	500	3200	CD
2.9	897	500	2600	CD

ALLIR OFNAR ERU PANELOFNAR

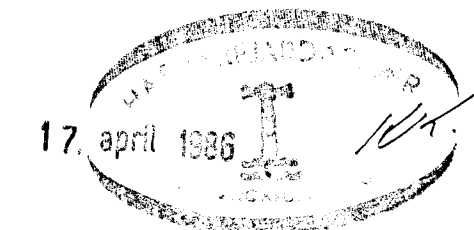

TEIKNAD UPP EFTIR LÝSINGU OG RISSI
FRÁ PÍPULAGNINGAMEISTARA.

TEIKNING FRÁ JÚNÍ '85 ÖGILD *APP*

VESTURGATA 4 HAFNARFIRÐI	VERK.	BL. NR.
		4.2
HITALAGNIR GRUNNMYND RISHÆÐAR OFNASKRÁ	Mkv. 1:50	REIKN. TEIKN. <i>APP</i>
VERKFRÆÐISTOFA HALLDÓRS HANNESSONAR SUDURGÖTU 14 HAFNARFIRÐI Sími: 54355		