



SNID Í ÚTVEGG 1:20

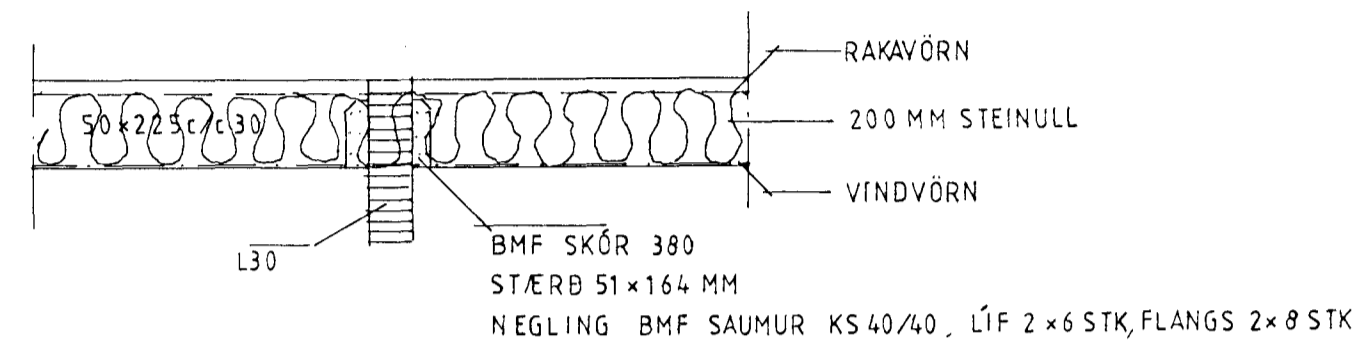

SMII SÉRMYND 1:20, GÓLF

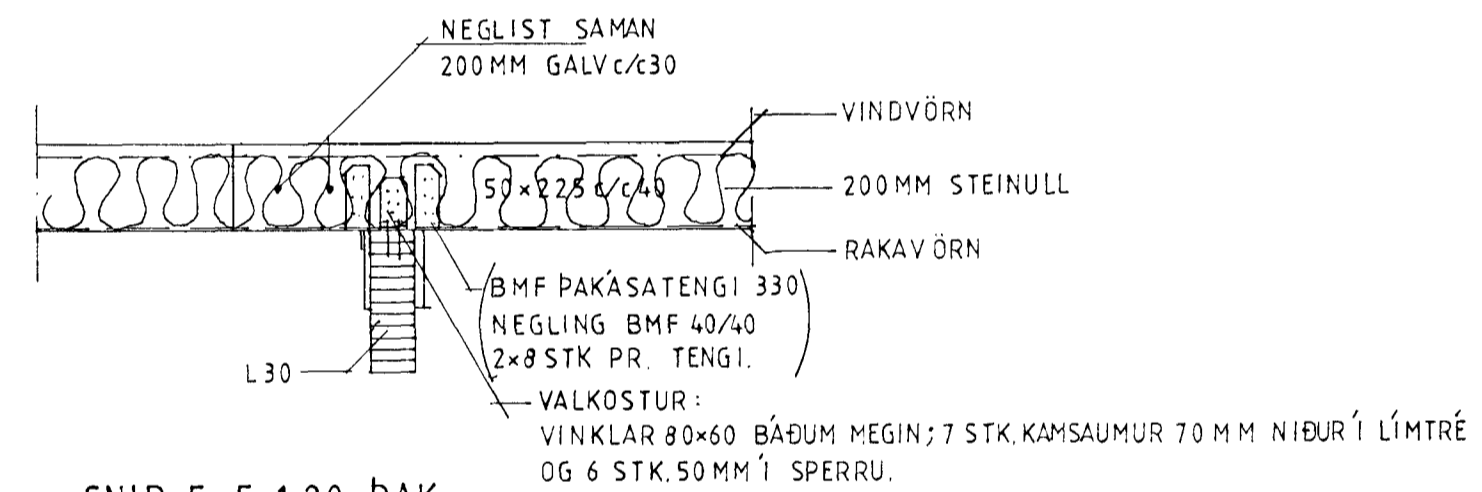

SNID F-F 1:20, ÞAK

Byggingatulltrúi Hafnarfjarðar
Afgreitt þann
05 FEB, 1996
Sigurbjartur Halldórsson

BREYTING JAN 96: SPERRUBIL		
VESTURHOLT 6		
BURÐARÞOL	H	T S
SNID Í ÚTVEGG	MKV 1:20	
GUDJON P RAGNARSSON	NR. 1.07	
TEKNIFR. MTFÍ KT 210351-3619	DAGS APRÍL '95	
SOGAVEGI 208 S34106		

GPE

Sigurbjartur Halldórsson