


AFSTADA 1:500

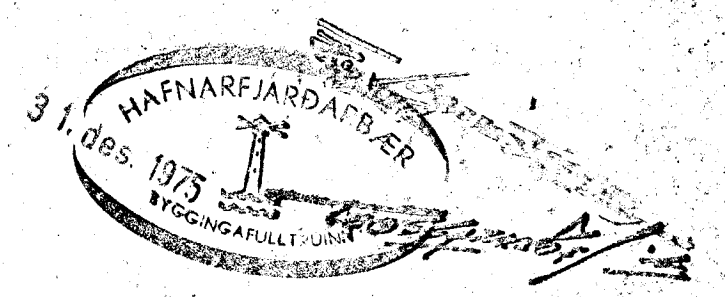

BREYTT Í DES. 1975
S.V.B.

STEINORÍMUR TH. ÞORLEIFSSON MTRK		
VESTURVANGUR NR. 47, HAFNARFJORDI		
MÁL	1:50	VAFNSLAGNIR
DAGS	JÚLÍ 1974	GRUNNEYND OG AFSTADA
BLAD	3	S. Þorleifsson