



OFNASKRÁ

OFN	MESTA		VARMA- ÞÖRF kcal klst	STAÐ- SETN. STÚTA	GERÐ OFNA			TÁKN FRAM- LEIDANDA.
	LENGD cm.	HÆÐ cm.			LENGD cm.	HÆÐ cm.	ÞYKKT cm.	
01	70	50	300	AB				
02	60	X	700	CD				
03	105	70	500	CD				
04	105	70	970	AB				
05	105	70	700	AB				
06	105	70	700	CD				
07	135	70	750	CD				
08	240	20	2300	AB				
09	105	20	1000	CD				
10	105	70	1200	CD				
11	40	X	530	CB				
12	X	X	2000	AB				
13	75	70	600	AB				
14								
15								
16								
17								
18								
13 Stk.			12.250 kcal klst					

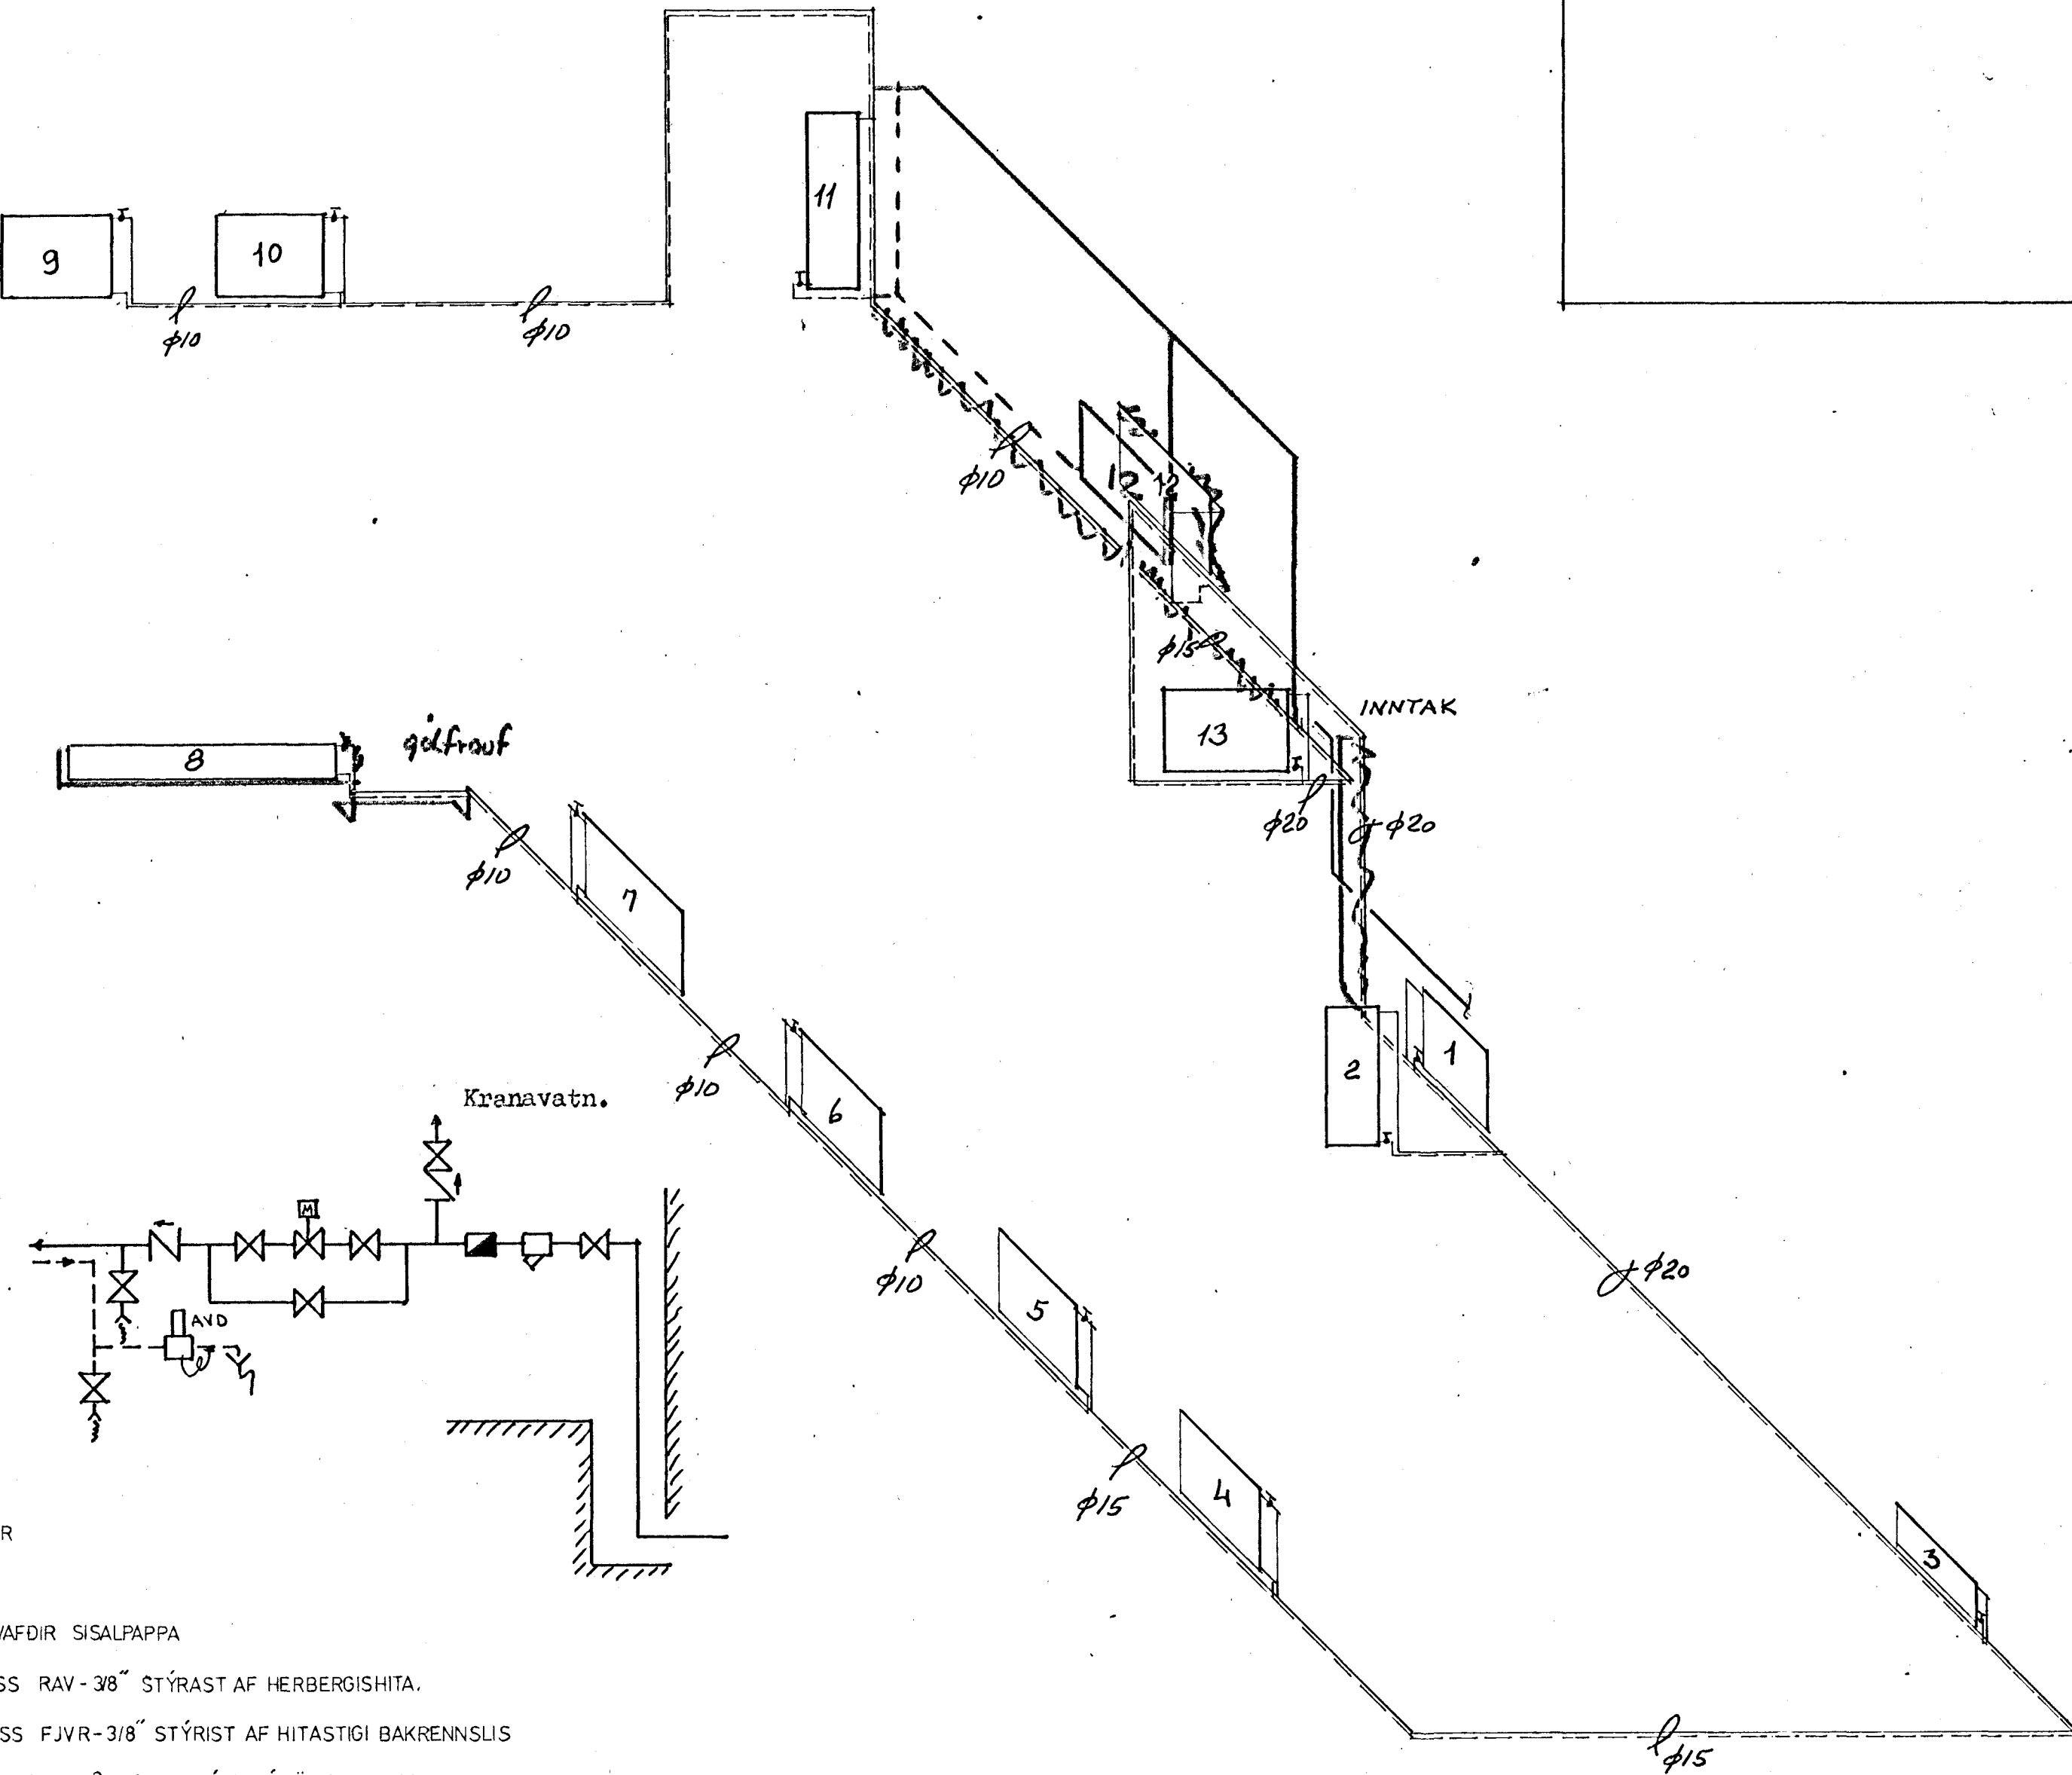

STAÐSETNING STÚTA
(SÉD FRAMAN Á)

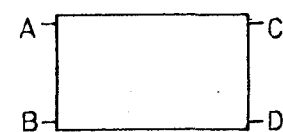

að ofnum.
frá ofnum.

SKÝRINGAR:

- | | | | | |
|-------|--------------------|---|-----------------------------|--|
| — | FRAMRENNSLI | — | PÍPUR | SVÖRT HEILDREGIN STÁL RÖR |
| - - - | BAKRENNSLI | — | FITTINGS | SVARTUR RANDFITTINGS |
| ■ | MAGNMÆLIR | — | EINANGRUN | 20MM GLERULLARHÓLKAR VAFDIR SISALPAPPA |
| □ | SÍA | — | OFNLOKAR Á FRAMRENNSLI T.D. | DANFOSS RAV-3/8" STÝRAST AF HERBERGISHITA. |
| ⊗ | TÆMING | — | Á BAKRENNSLI T.D. | DANFOSS FJVR-3/8" STÝRIST AF HITASTIGI BAKRENNSLIS |
| ⊗ | RENNILOKI | — | OFNAR | STÁL OFNAR PRÓFADIR VID 8 kg/cm ² LOFTSKRÚFUR Á ÖLLUM OFNUM |
| ⊗ | EINSTREYMISLOKI | — | PRÓFUN | LÖGNINA SKAL PRÓFA VID 6 kg/cm ² SEM SKAL STANDA Í 12 KLST. |
| ⊗ | HEMILL | — | | ÁN ÞESS AD FALLA |
| ⊗ | MÓTORLOKI | | | |
| ⊗ | ÖRYGGISLOKI | | | |
| ⊗ | BLÖNDUNARLOKI | | | |
| □AVD | DANFOSS SLAUFULOKI | | | |
| □AVTB | HITASTILLILOKI | | | |

2. Jan 1978
HAFIARFIÐDABER
BYGGINGARULL
LAUGAVEGUR 120
PÓSTHÓLF 5076, REYKJAVÍK.
SÍMI 25600.

VERK HP.	RVK 1 des 75	VERK! Vesturvangur 48, 18 Hafnarfirði.	LAUGAVEGUR 120 PÓSTHÓLF 5076, REYKJAVÍK. SÍMI 25600.	GERÐ NR. HL.
	REIKN. TEIKN. SGS YFIRF.			VERK NR. 236
	MÆLIKV. 1:50	HITALÖGN - RUMMYND - TENGILYND - OFNASKRÁ		TEIKN NR. 25