
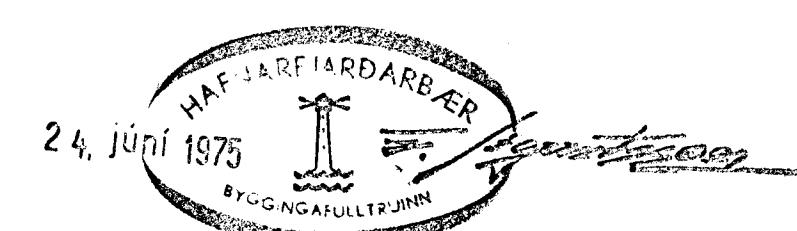


VESTURVANGUR NR. 58 28

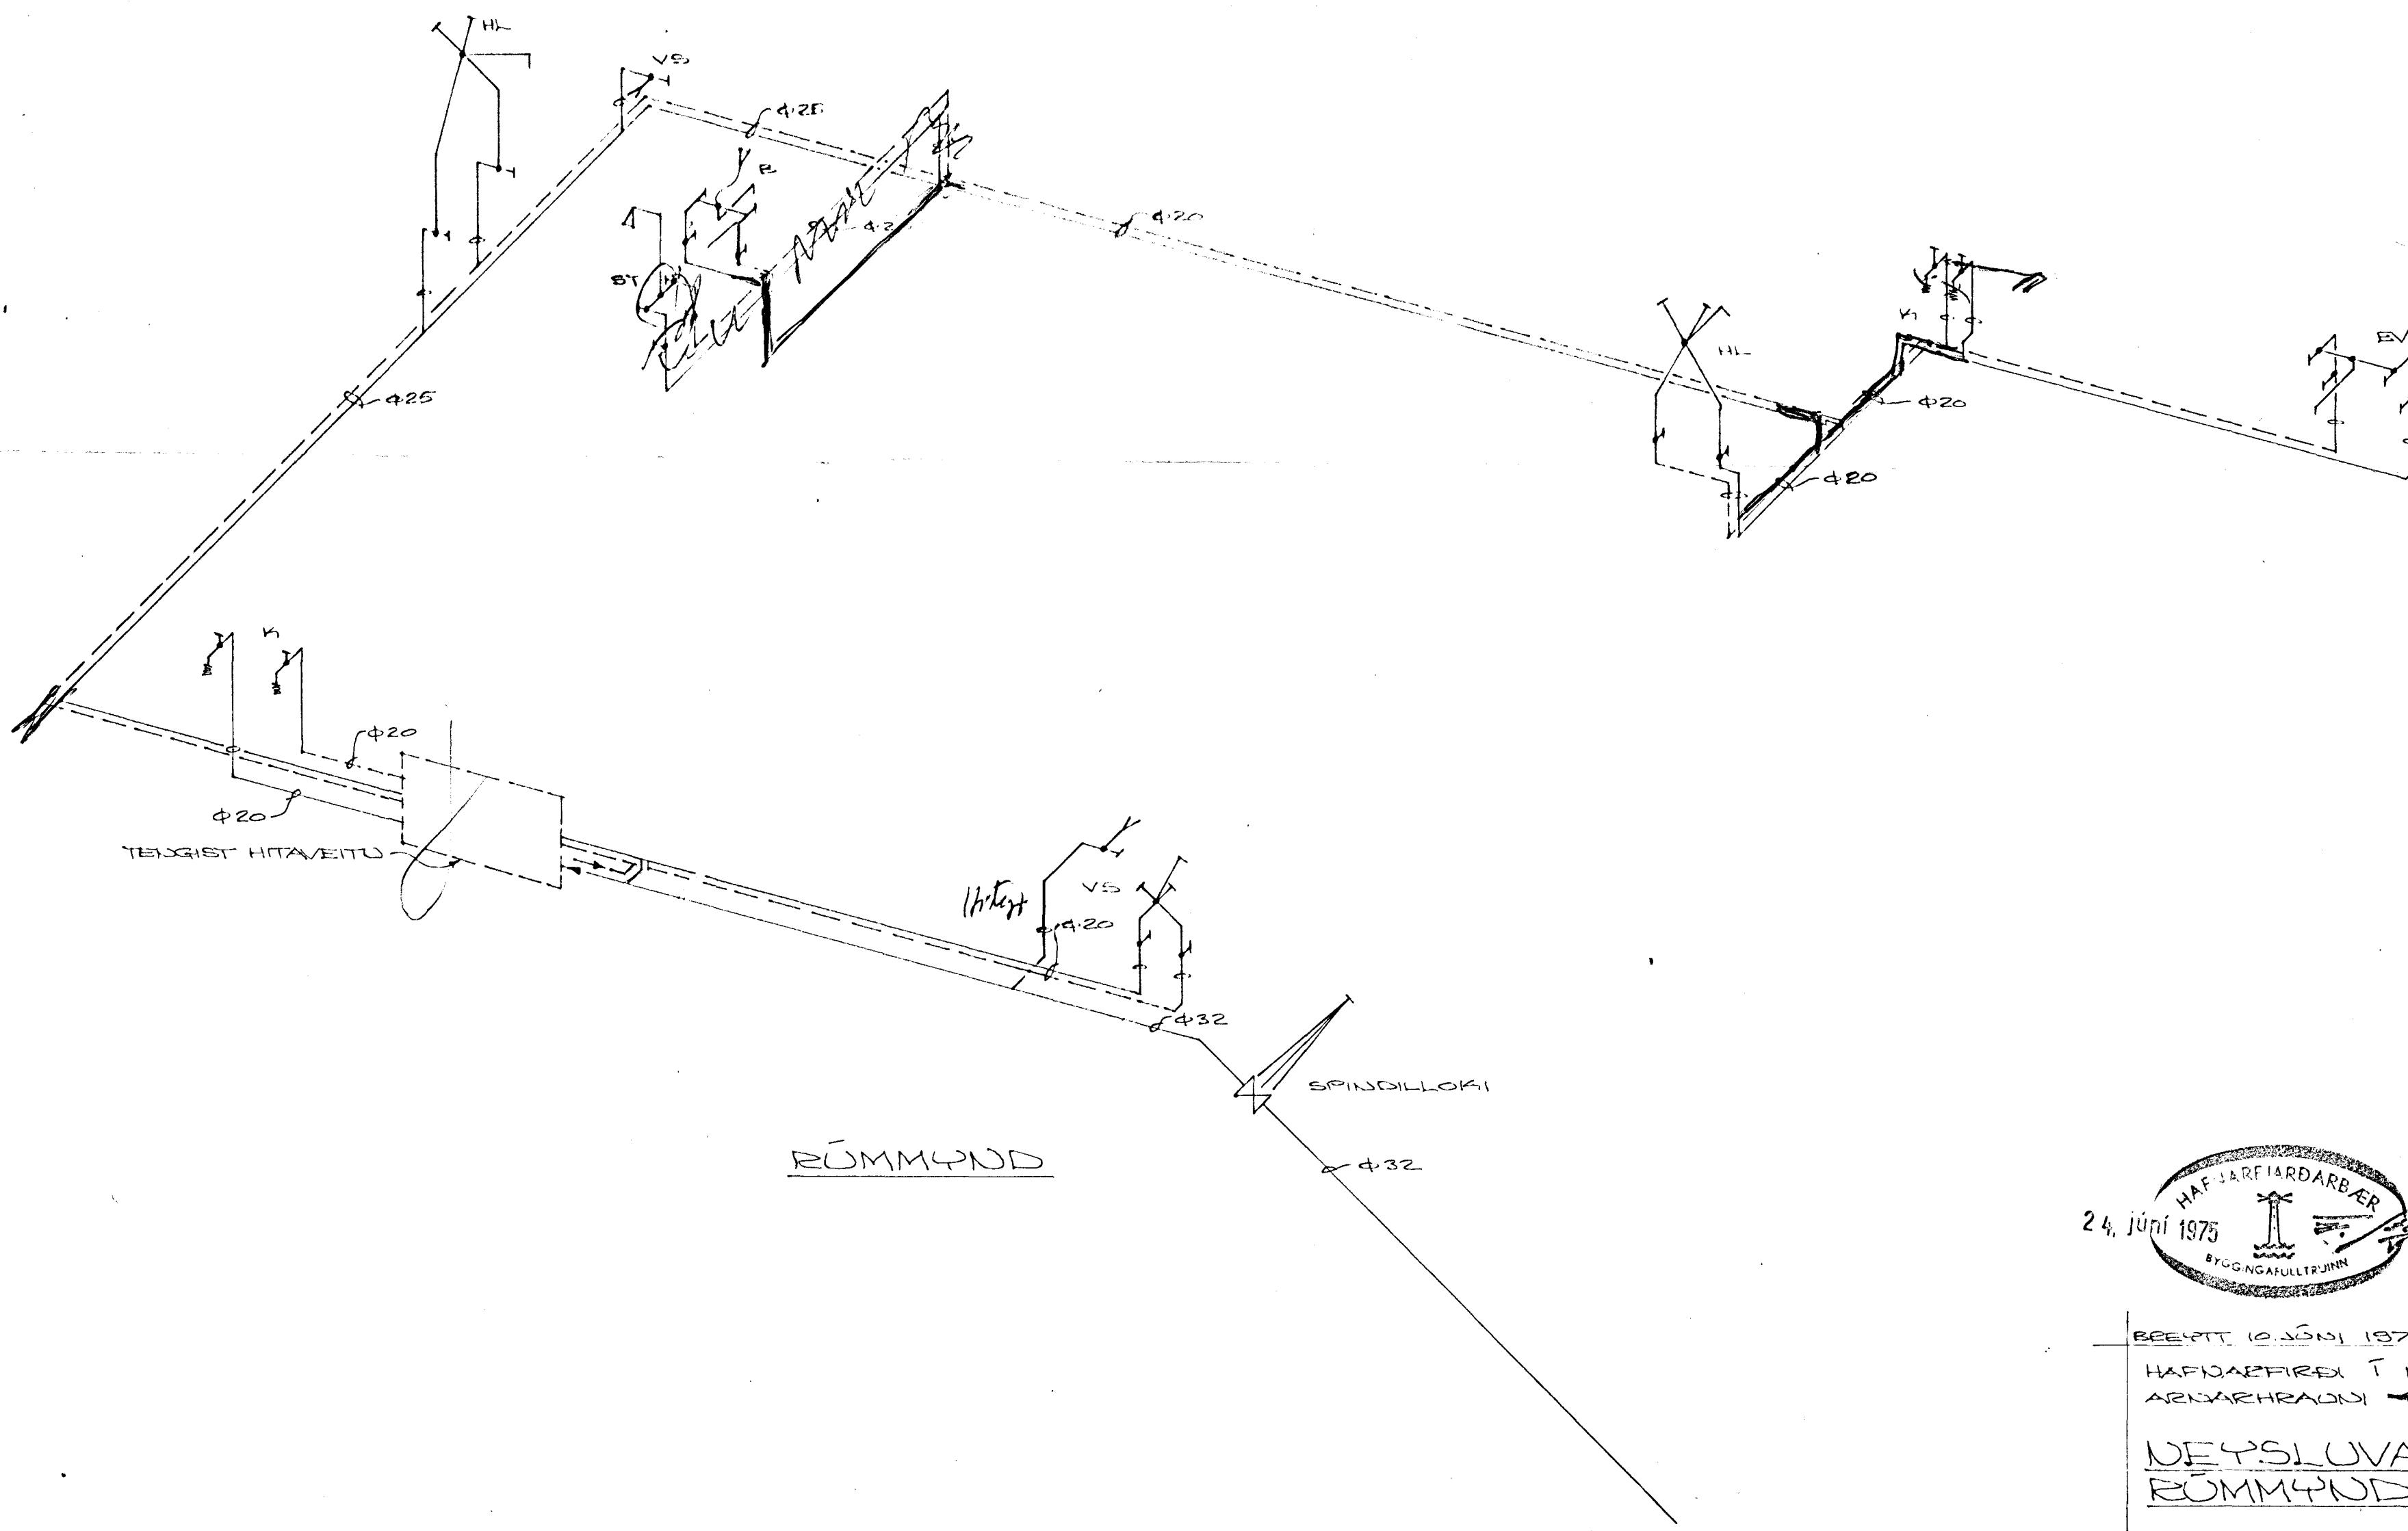

BREYTT 10. JÓULI 1975

HAFNARFJARDARÞER 1 MAI 1975  
ARKVARFHRAÐNI → 50587

NEYSLUVATNSLÖGN  
RÚMMUND

Ágúst Þorláksson, MVI