



Halt ogkalt  
vegi á milli!  
N

VESTURVANGUR

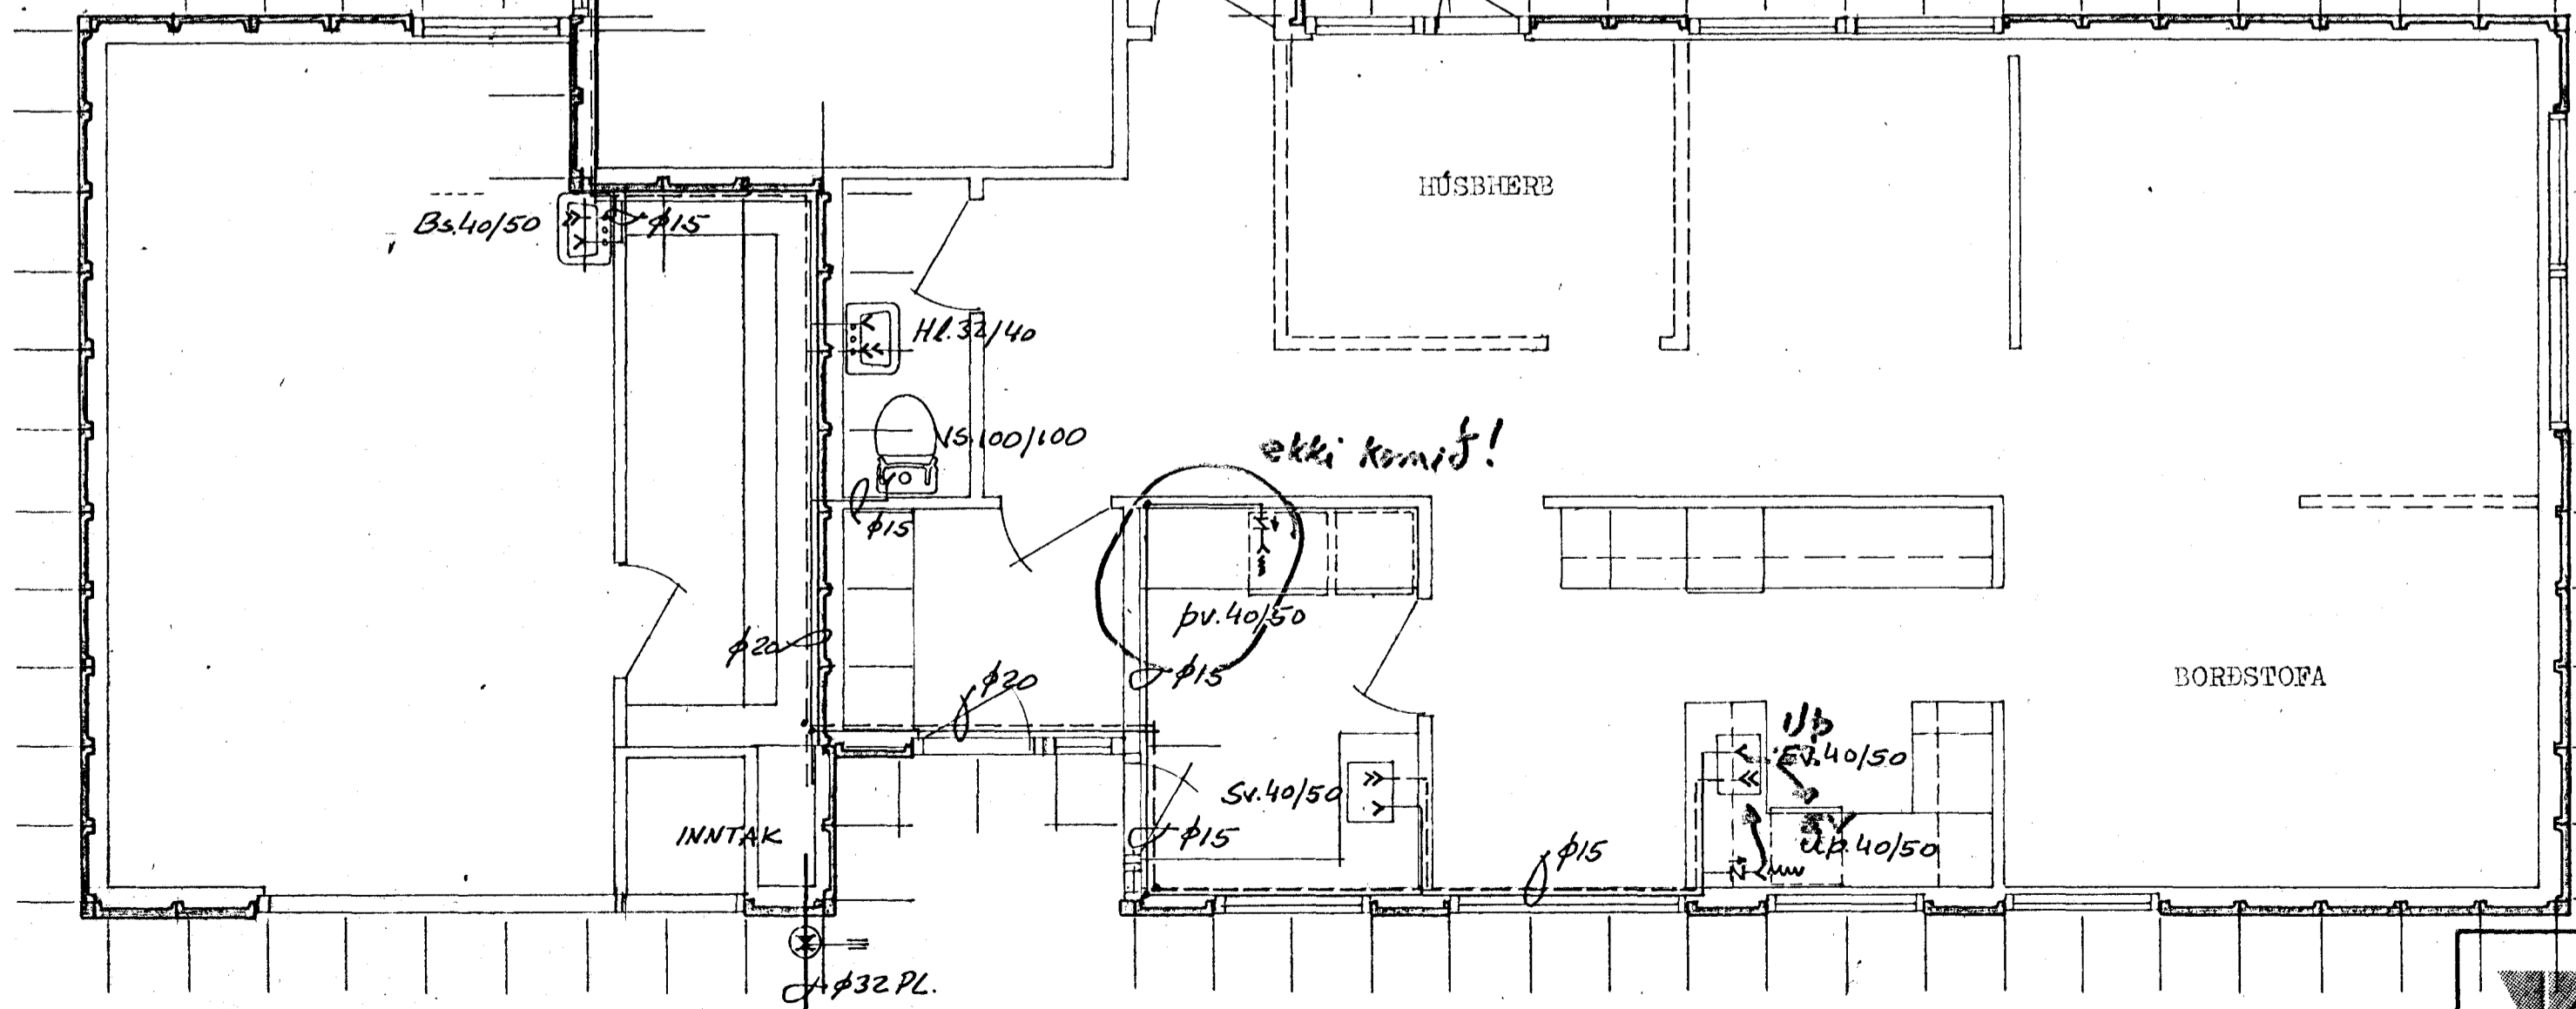

	RVK í des 75	<b>VERK</b> LAUGAVEGUR 120 PÓSTHÓLF 507A, REYKJAVÍK. Sími 25600.	GERD NR. VL	
	REIKN. TEIKN. SGS YFIRF.		VESTURVANGUR 32, HAFNARFIRDI.	VERK NR. 235
	MÆLIKV. 1:50		VATNSLÖGN-GRUNNMYND.	TEIKN NR. 24