

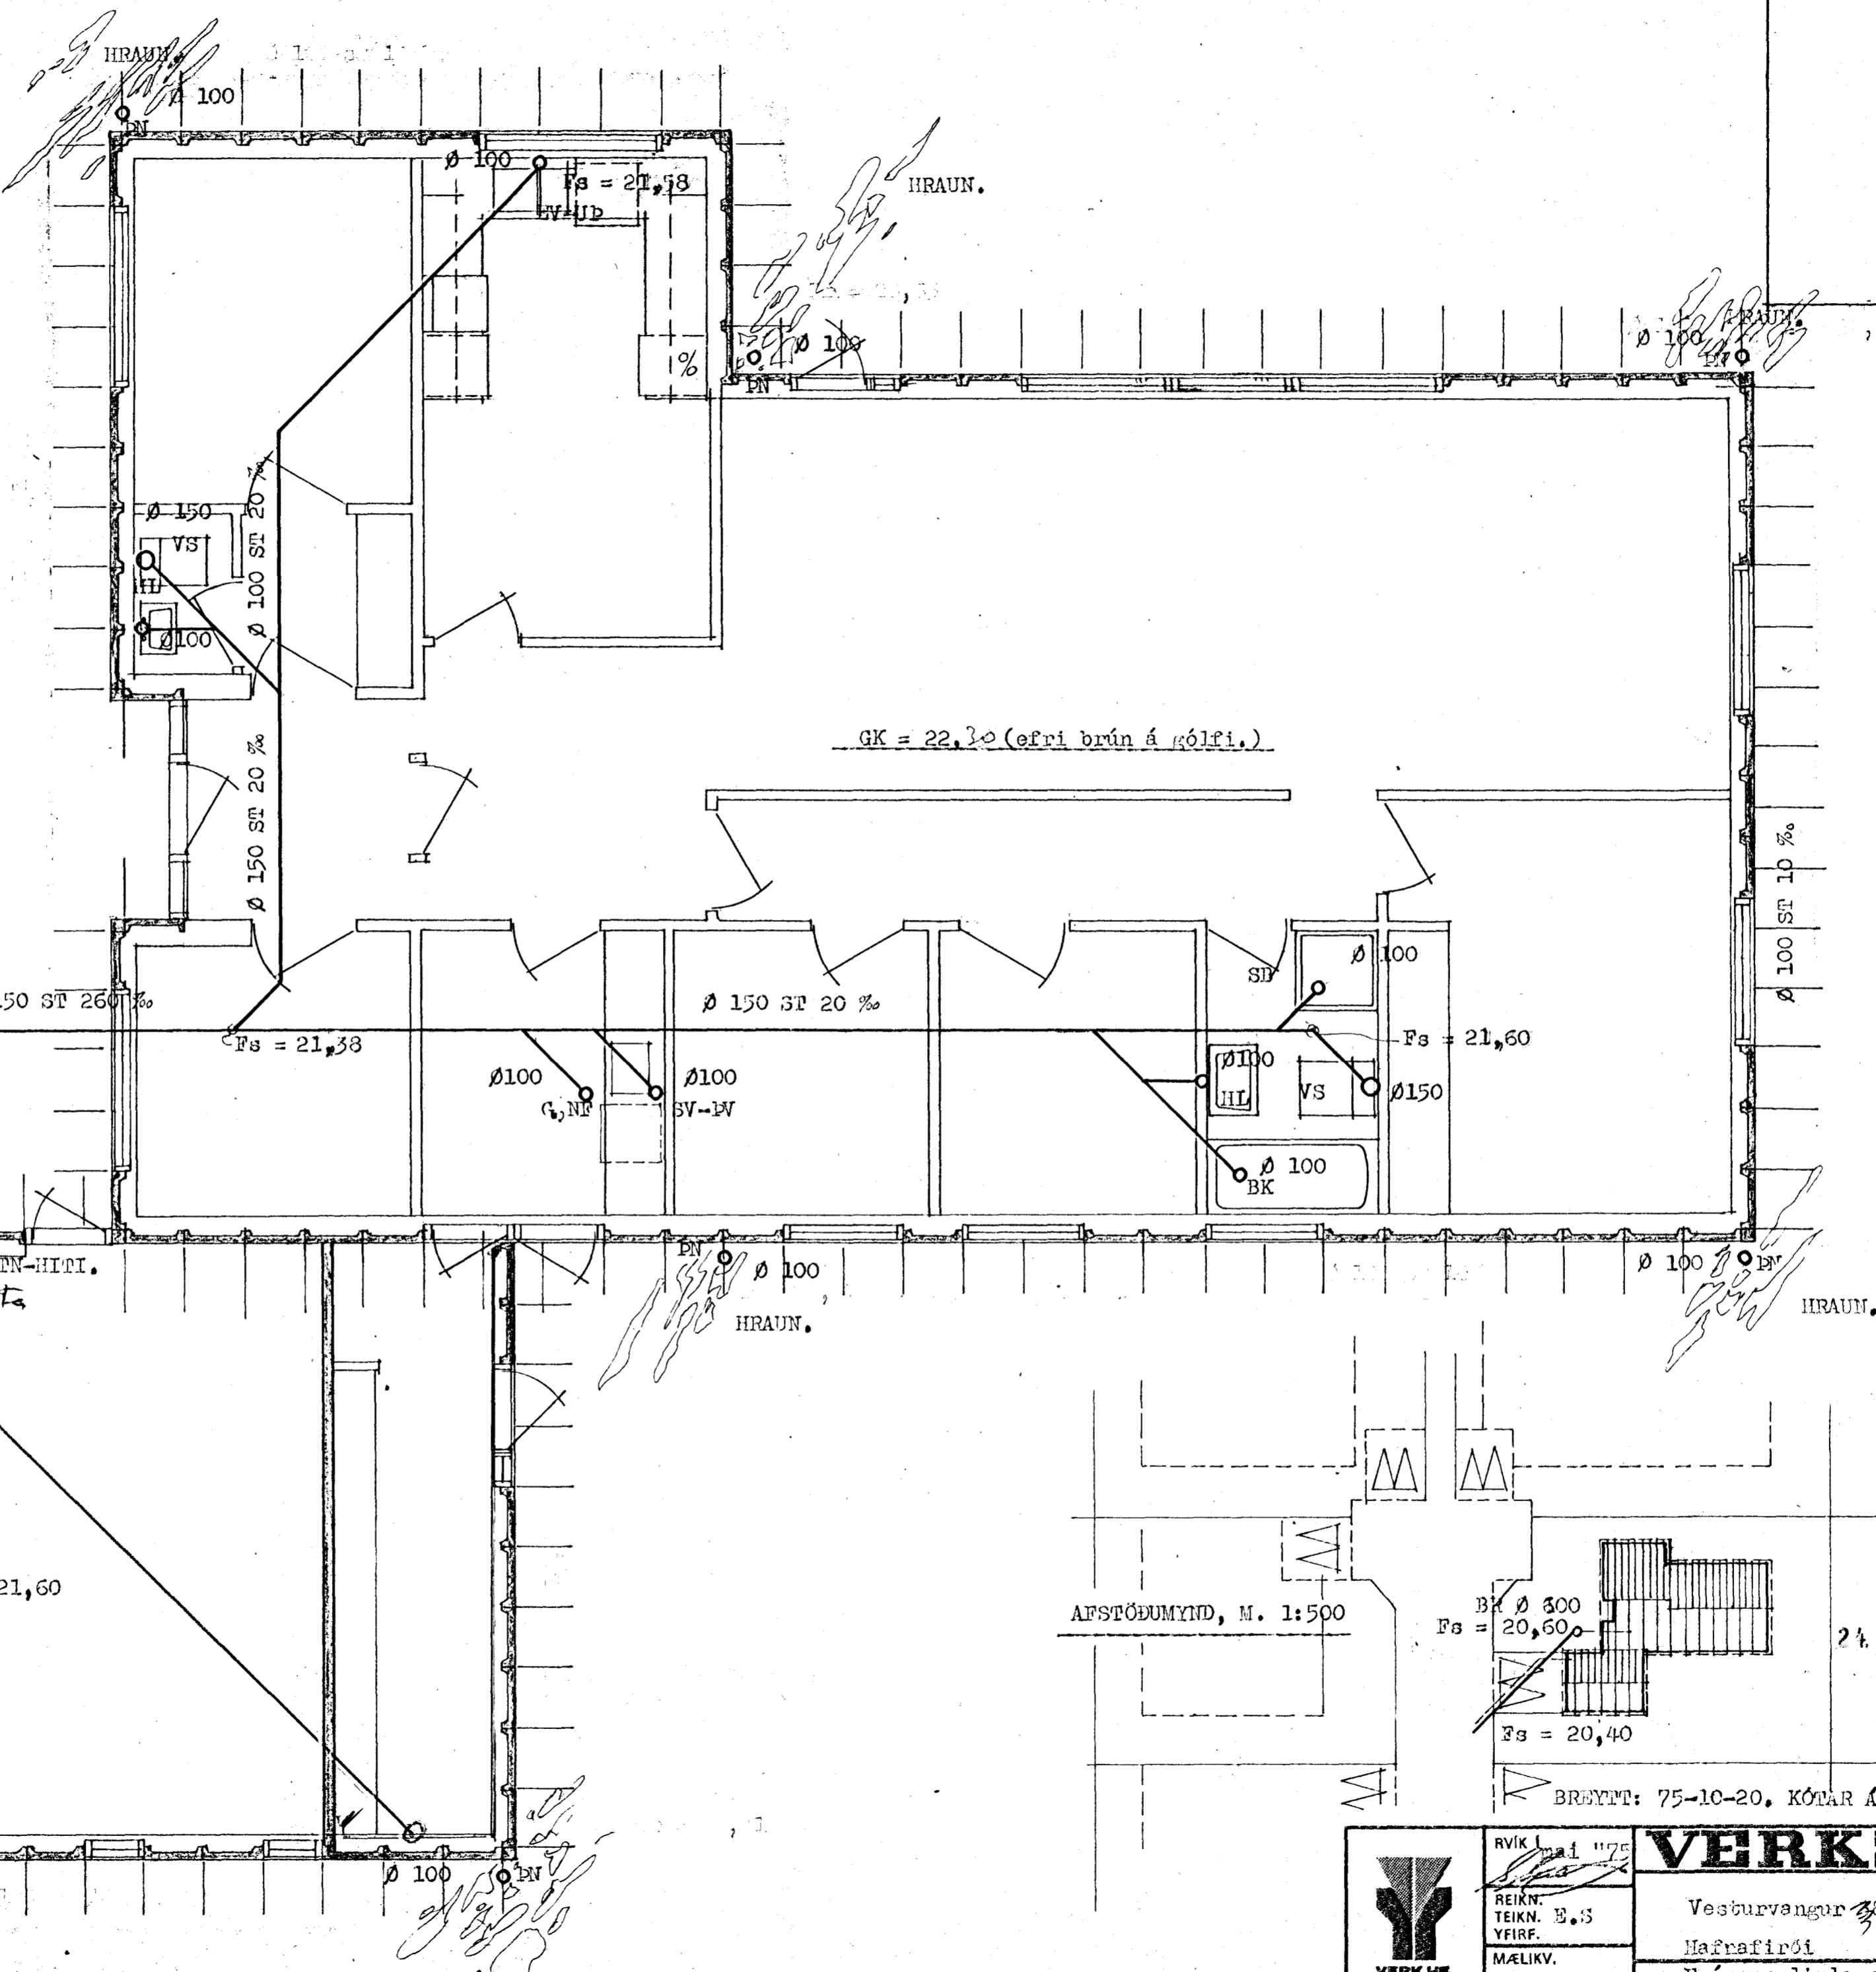



Halli á lögn
seakvamt fyrir
Byggingarfulltrúa.

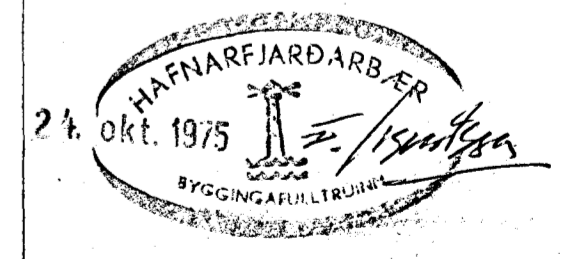

AFSTÖÐUMYND, M. 1:500

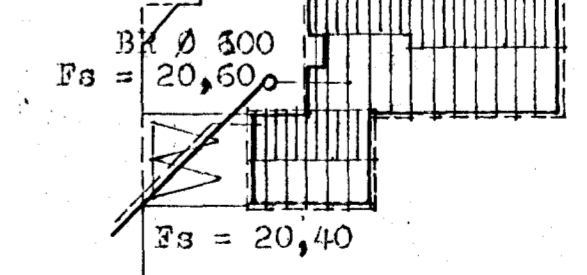

BREYTT: 75-10-20. KÓÐAR Á PLÖTU. REGNVATNSLÖGN.

	RVK 1:50	VERK HF LAUGAVEGUR 120 PÓSTHÓLF 5076, REYKJAVÍK SÍMI 25600.	GERD NR.
	REIKN. TEIKN. E.S. YFIRF.		40
	MÆLIKV. 1:50		VERK NR. 221
			TEIKN NR. 21

Vesturvangur 38
Hafnarfirði
Frærennslislagirnir.