

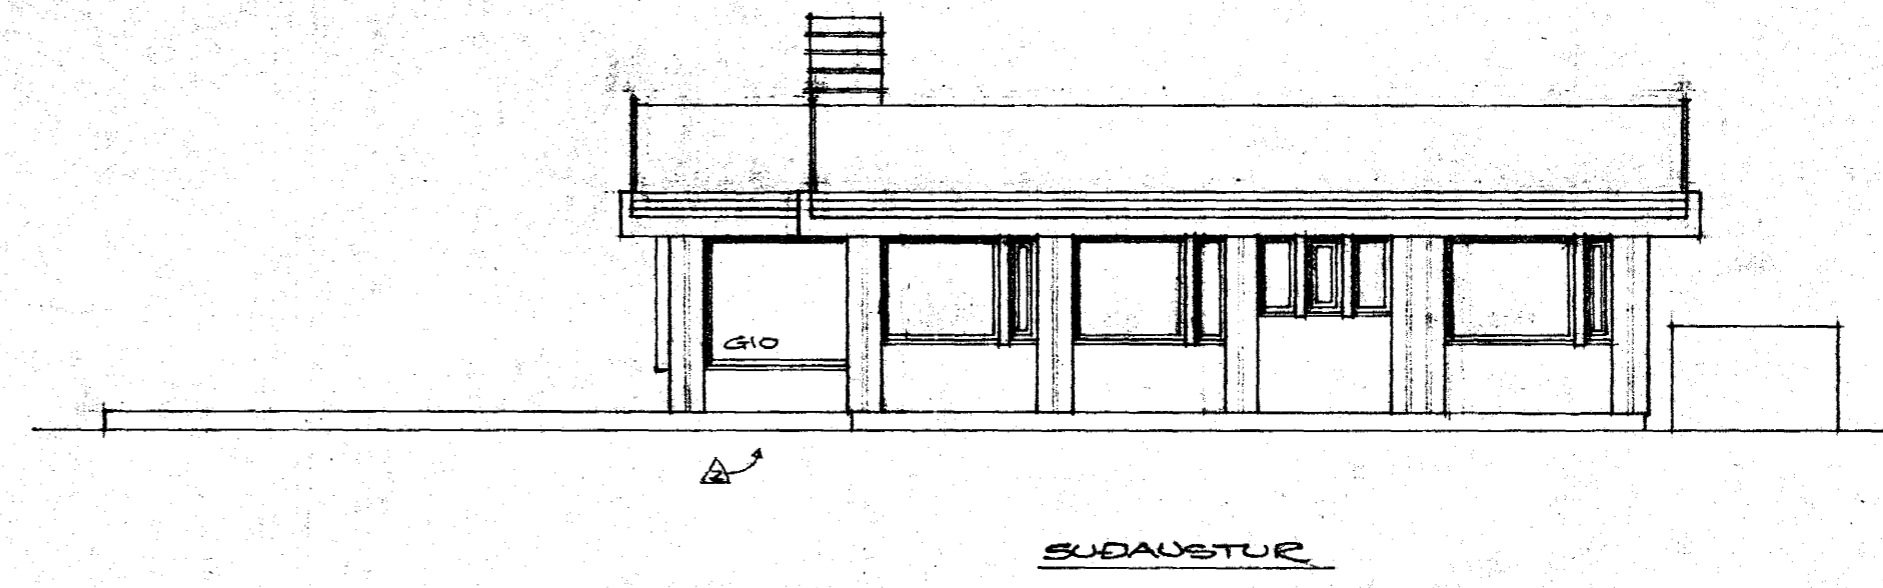
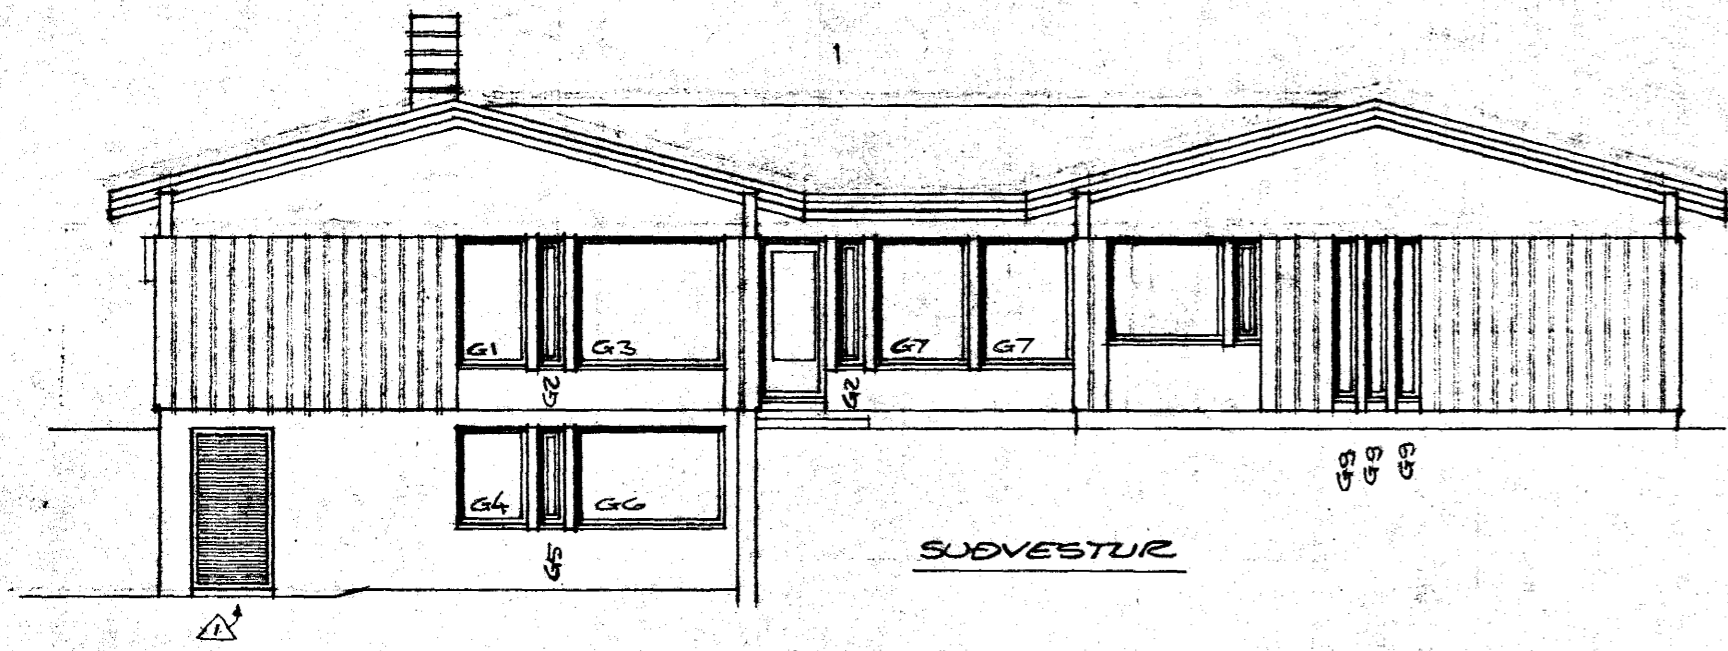


Samþykkt á fundi bygginga-  
nefndar þ. 6.19.1978  
BYGGINGAFULLTRÚINN  
Í HAFNARFIRDI  
*Þh. Einar Sigurdsson*

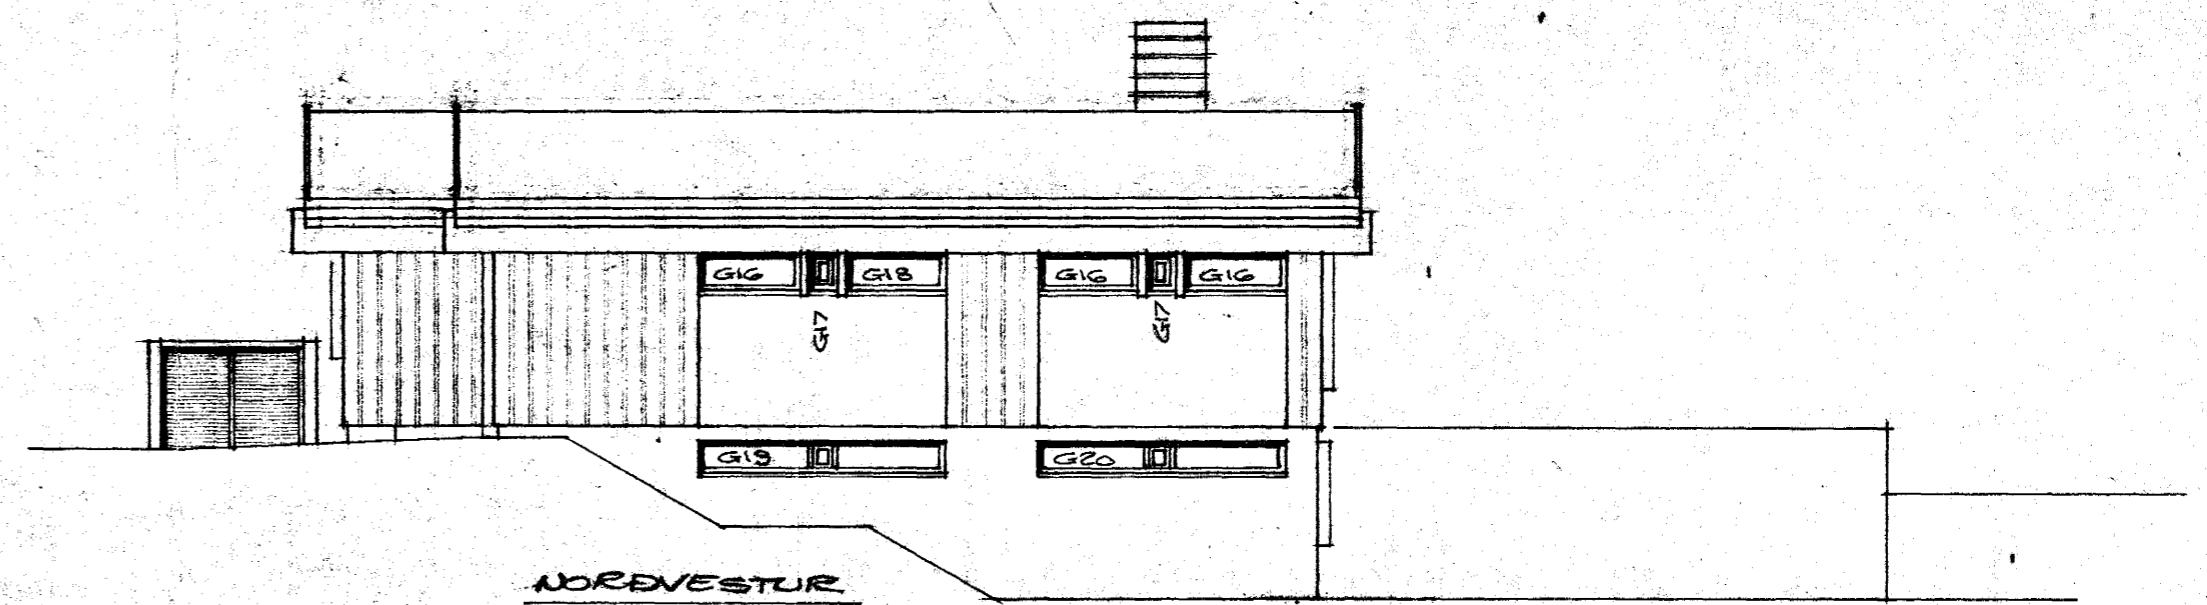

tifftopdf - www.rubissoftware.com - Demo Version

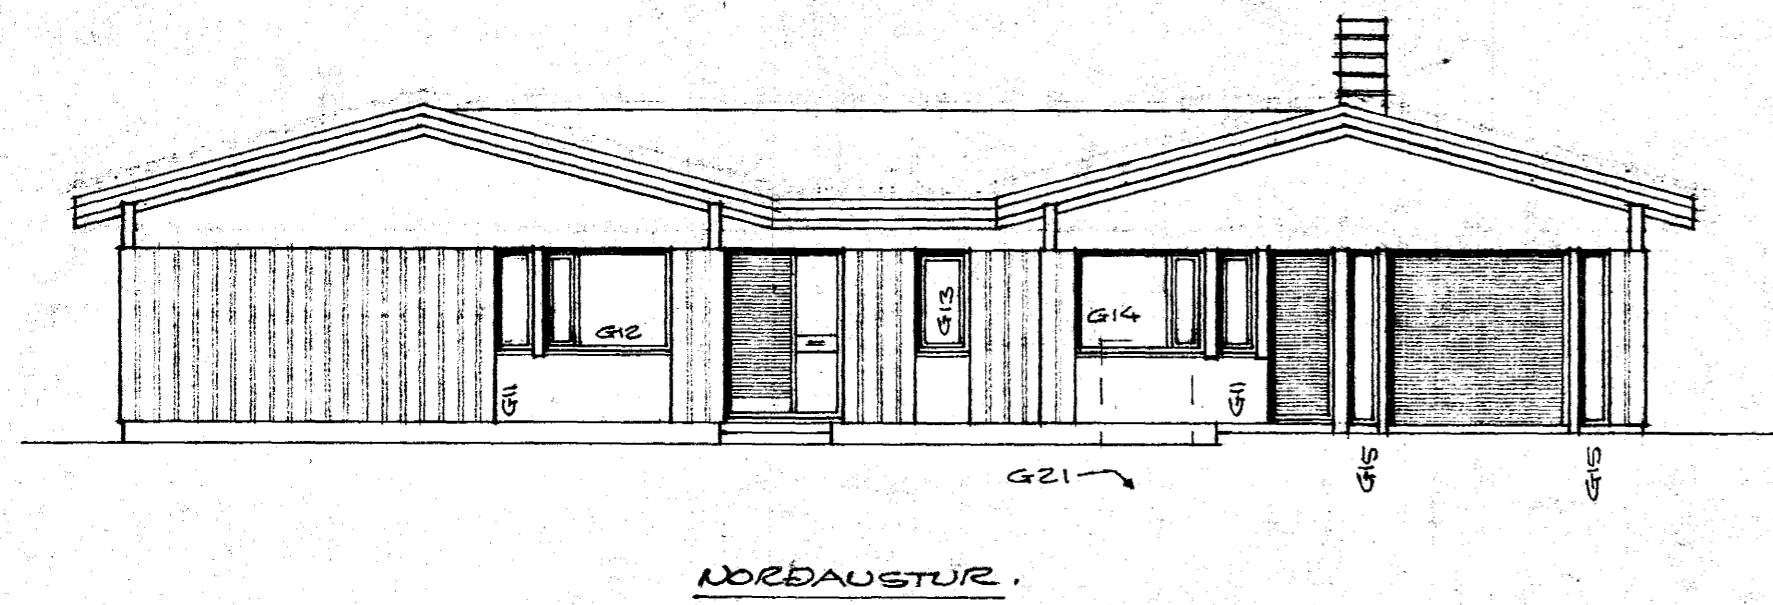

VÍÐIVANGUR NR. 10, M=1:100  
HAFNARFIRDI Í APRÍL 1977  
ARNARHRAUNI 47 50587

BRETT 4.7.1978  
BRETT 20.6.1977  
BRETT 22.4.1977

*Arnald Magnússon*