




GRUNNMYND HÆÐAR 1:50

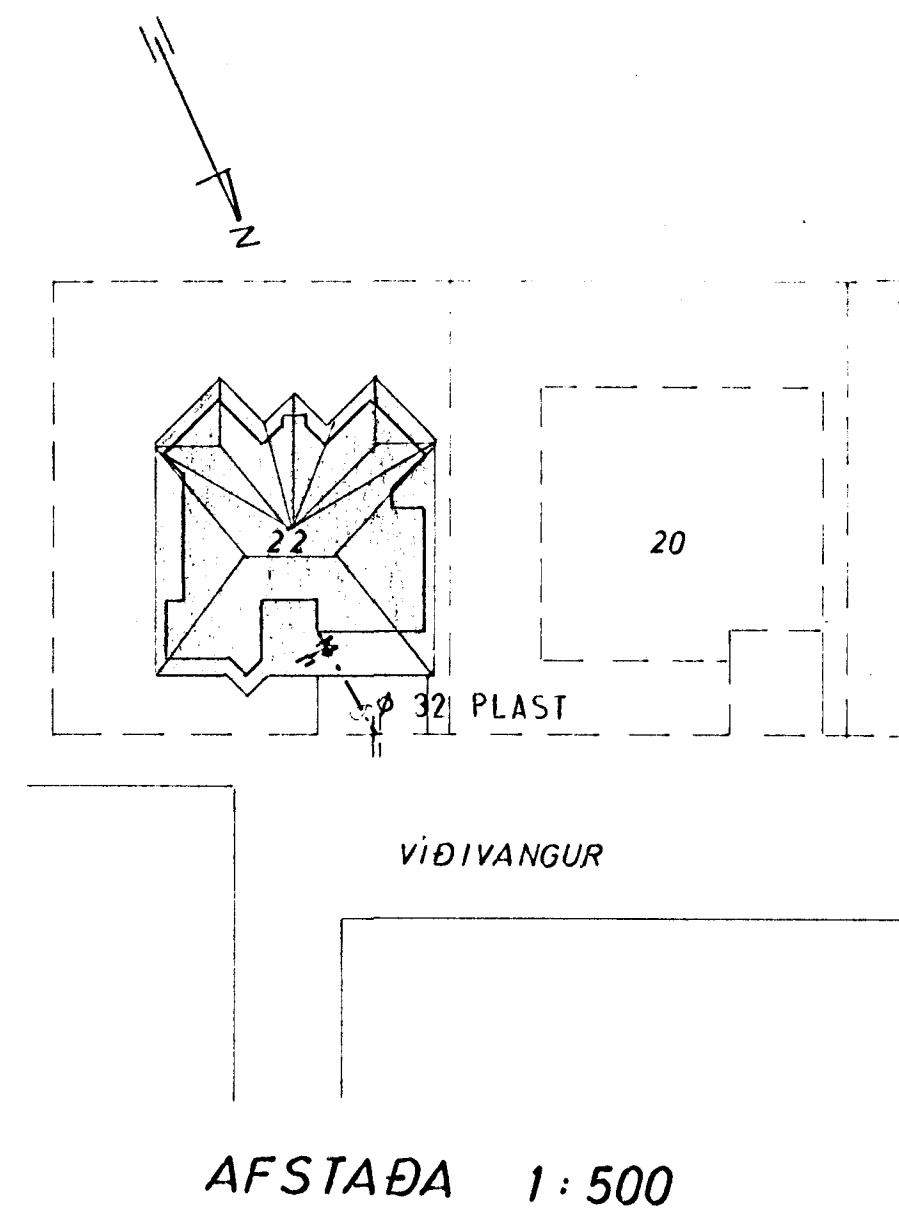

AFSTADA 1:500

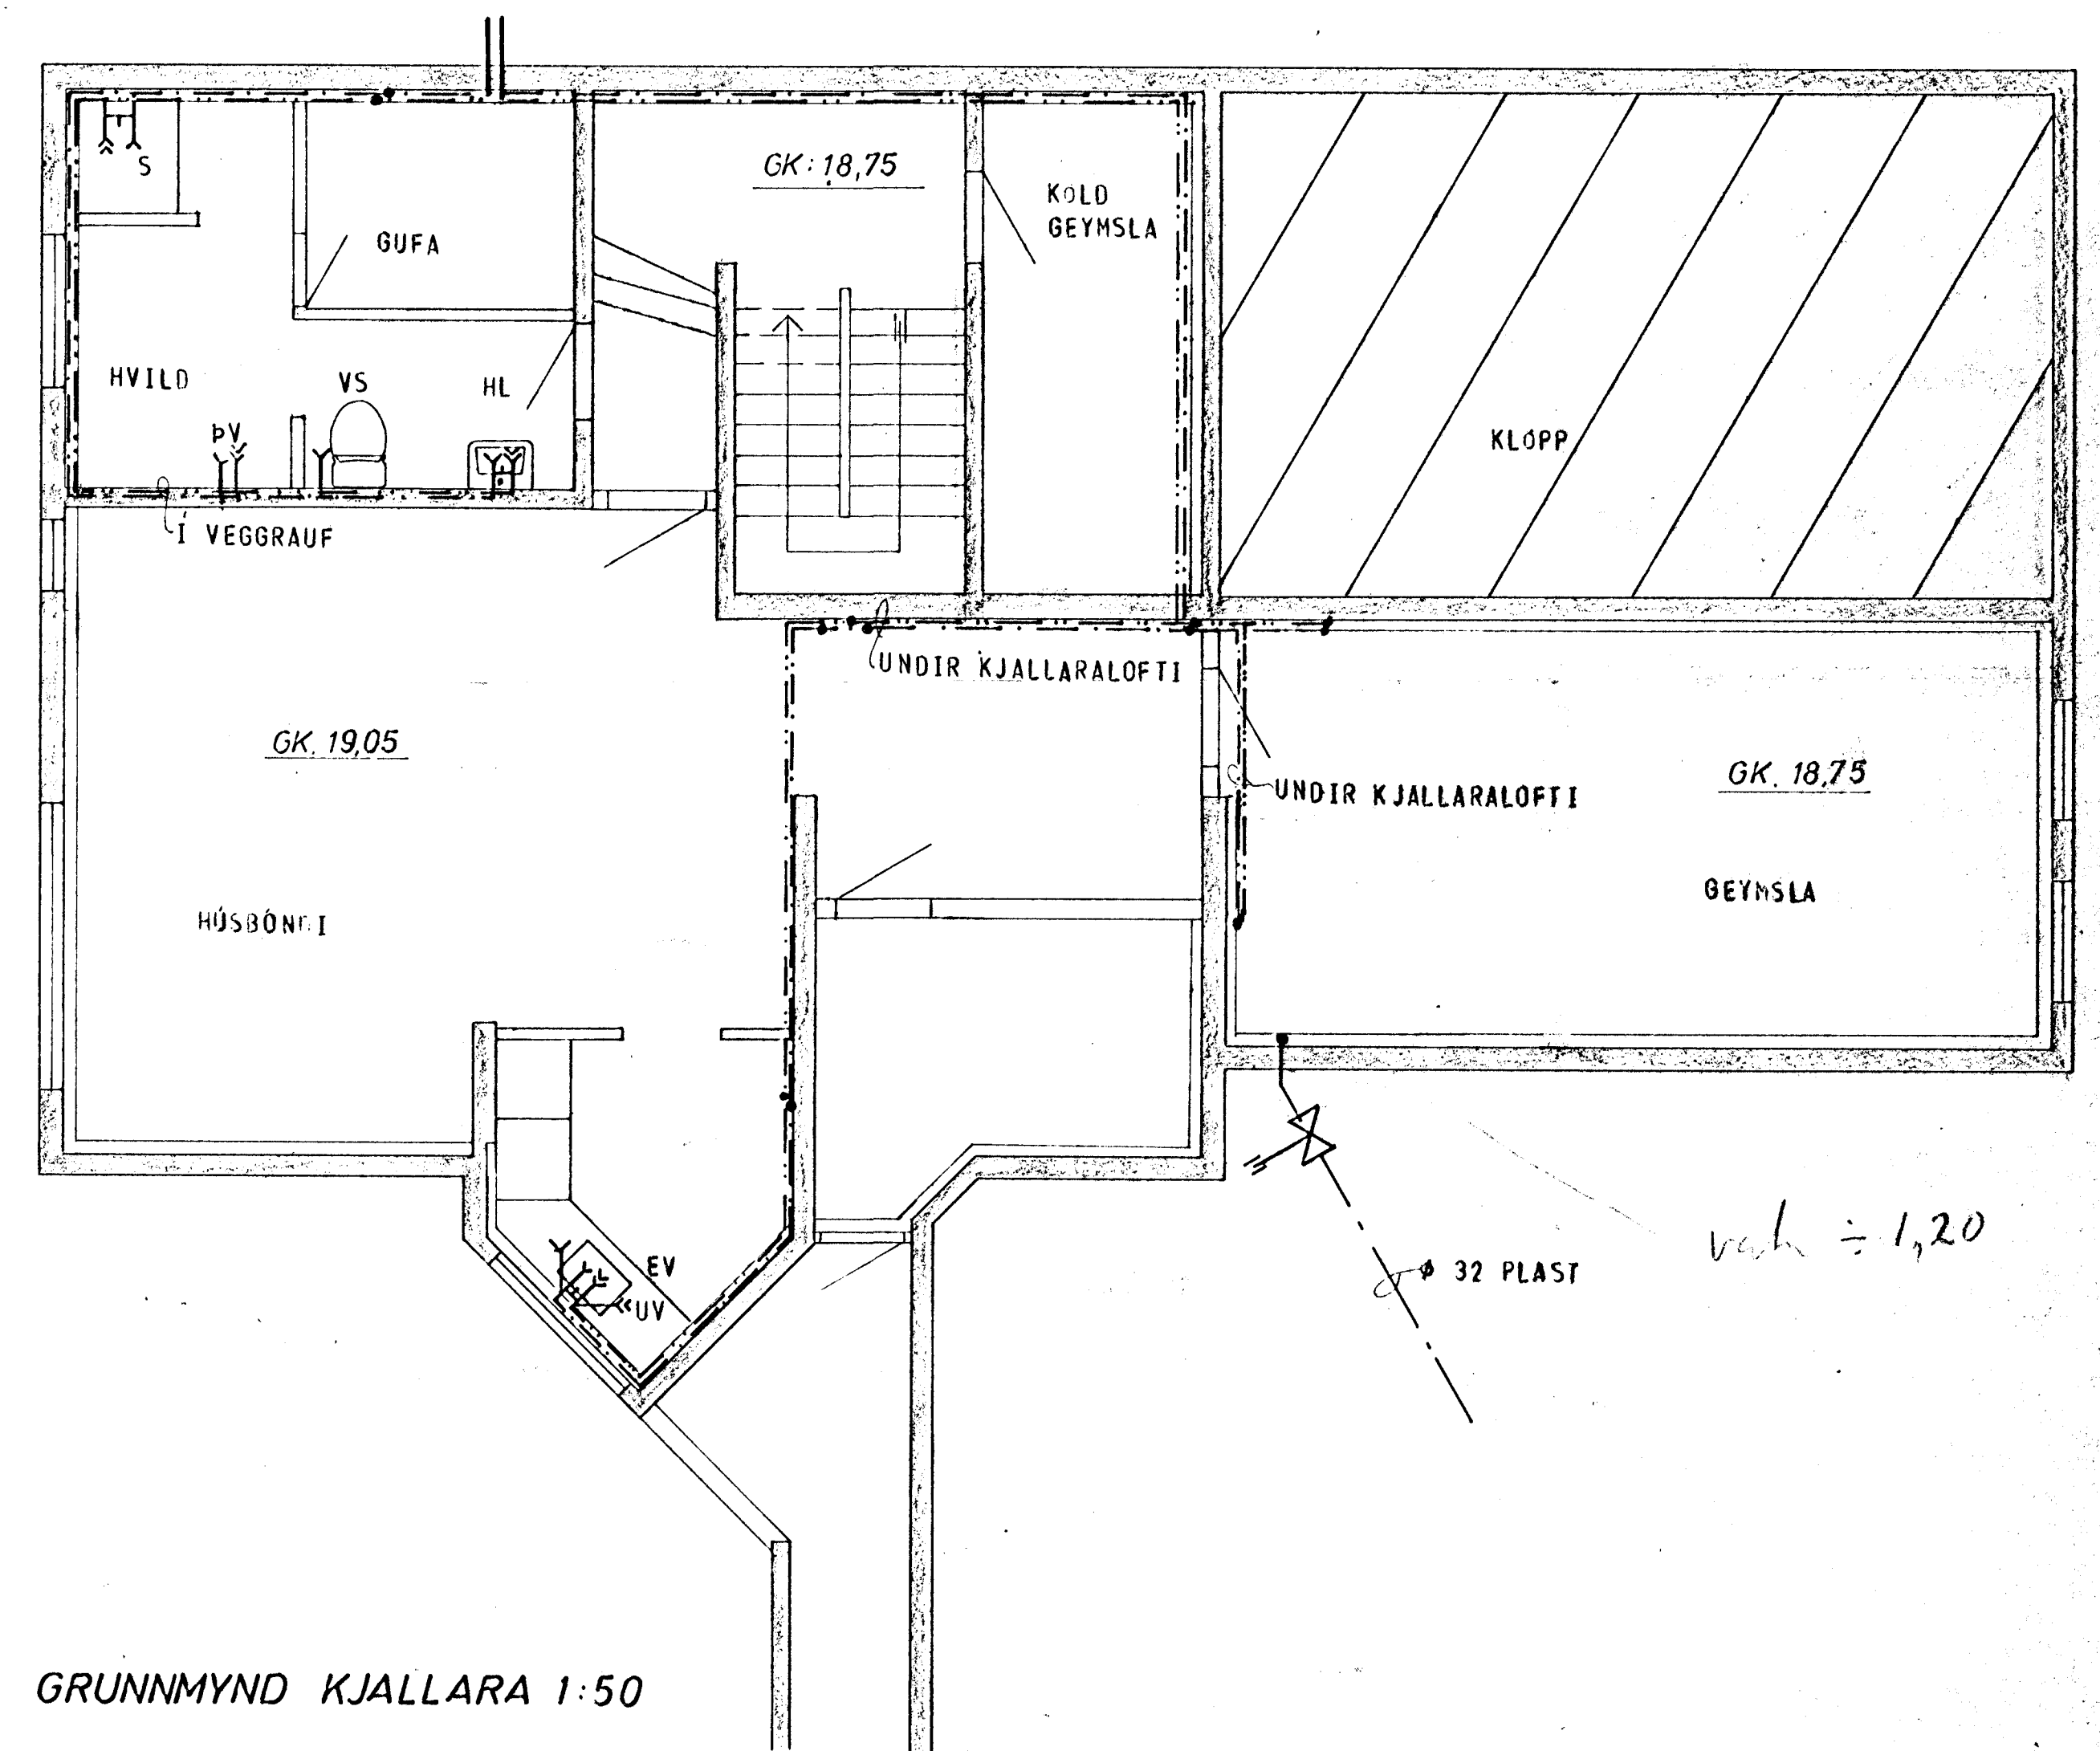

GRUNNMYND KJALLARA 1:50

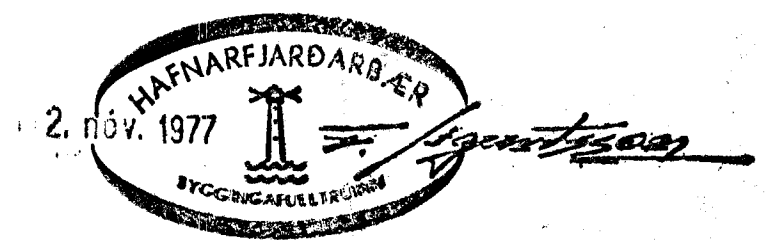

SKÝRINGAR SJÁ TEIKN NR. 2.0.

VÍÐIVANGUR 22	MÆLIKVARDI 1 : 50 1 : 500	VERK 2714	TEIKN NR. 24
VATNSLÖGN - GRUNNMYND.	HannaS. Teiknað: S. O.	Virtand: Samþ.	DAGS JUNÍ '77
JÓHANN GUNNAR BERGPÓRSSON VERKFR. M.V.F. STRANDGÖTU 11 - HAFNARFIRÐI - SÍMI 93319	BREYTT		