
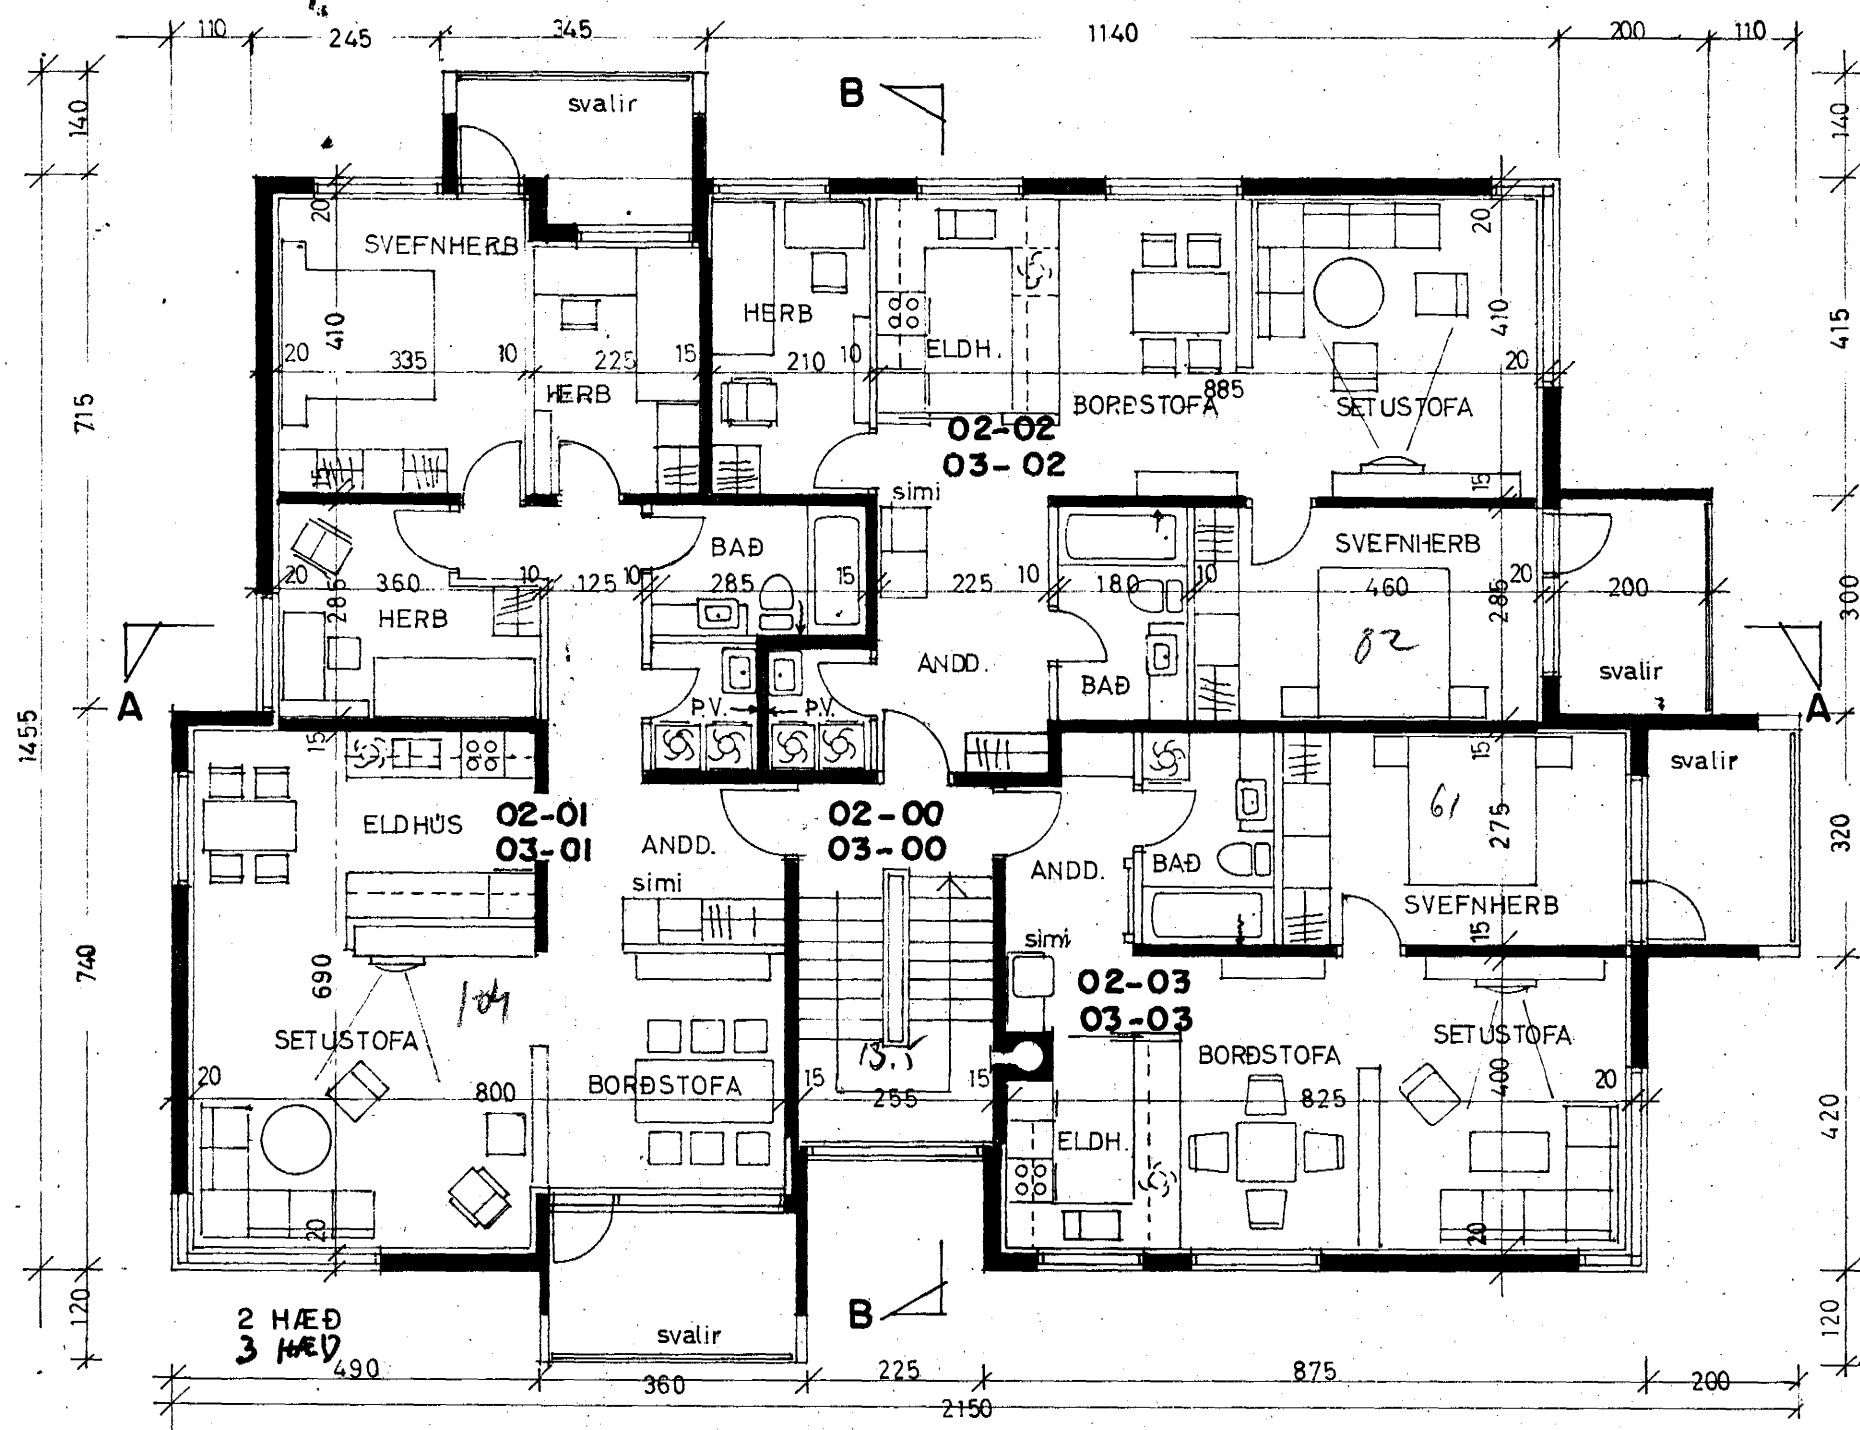
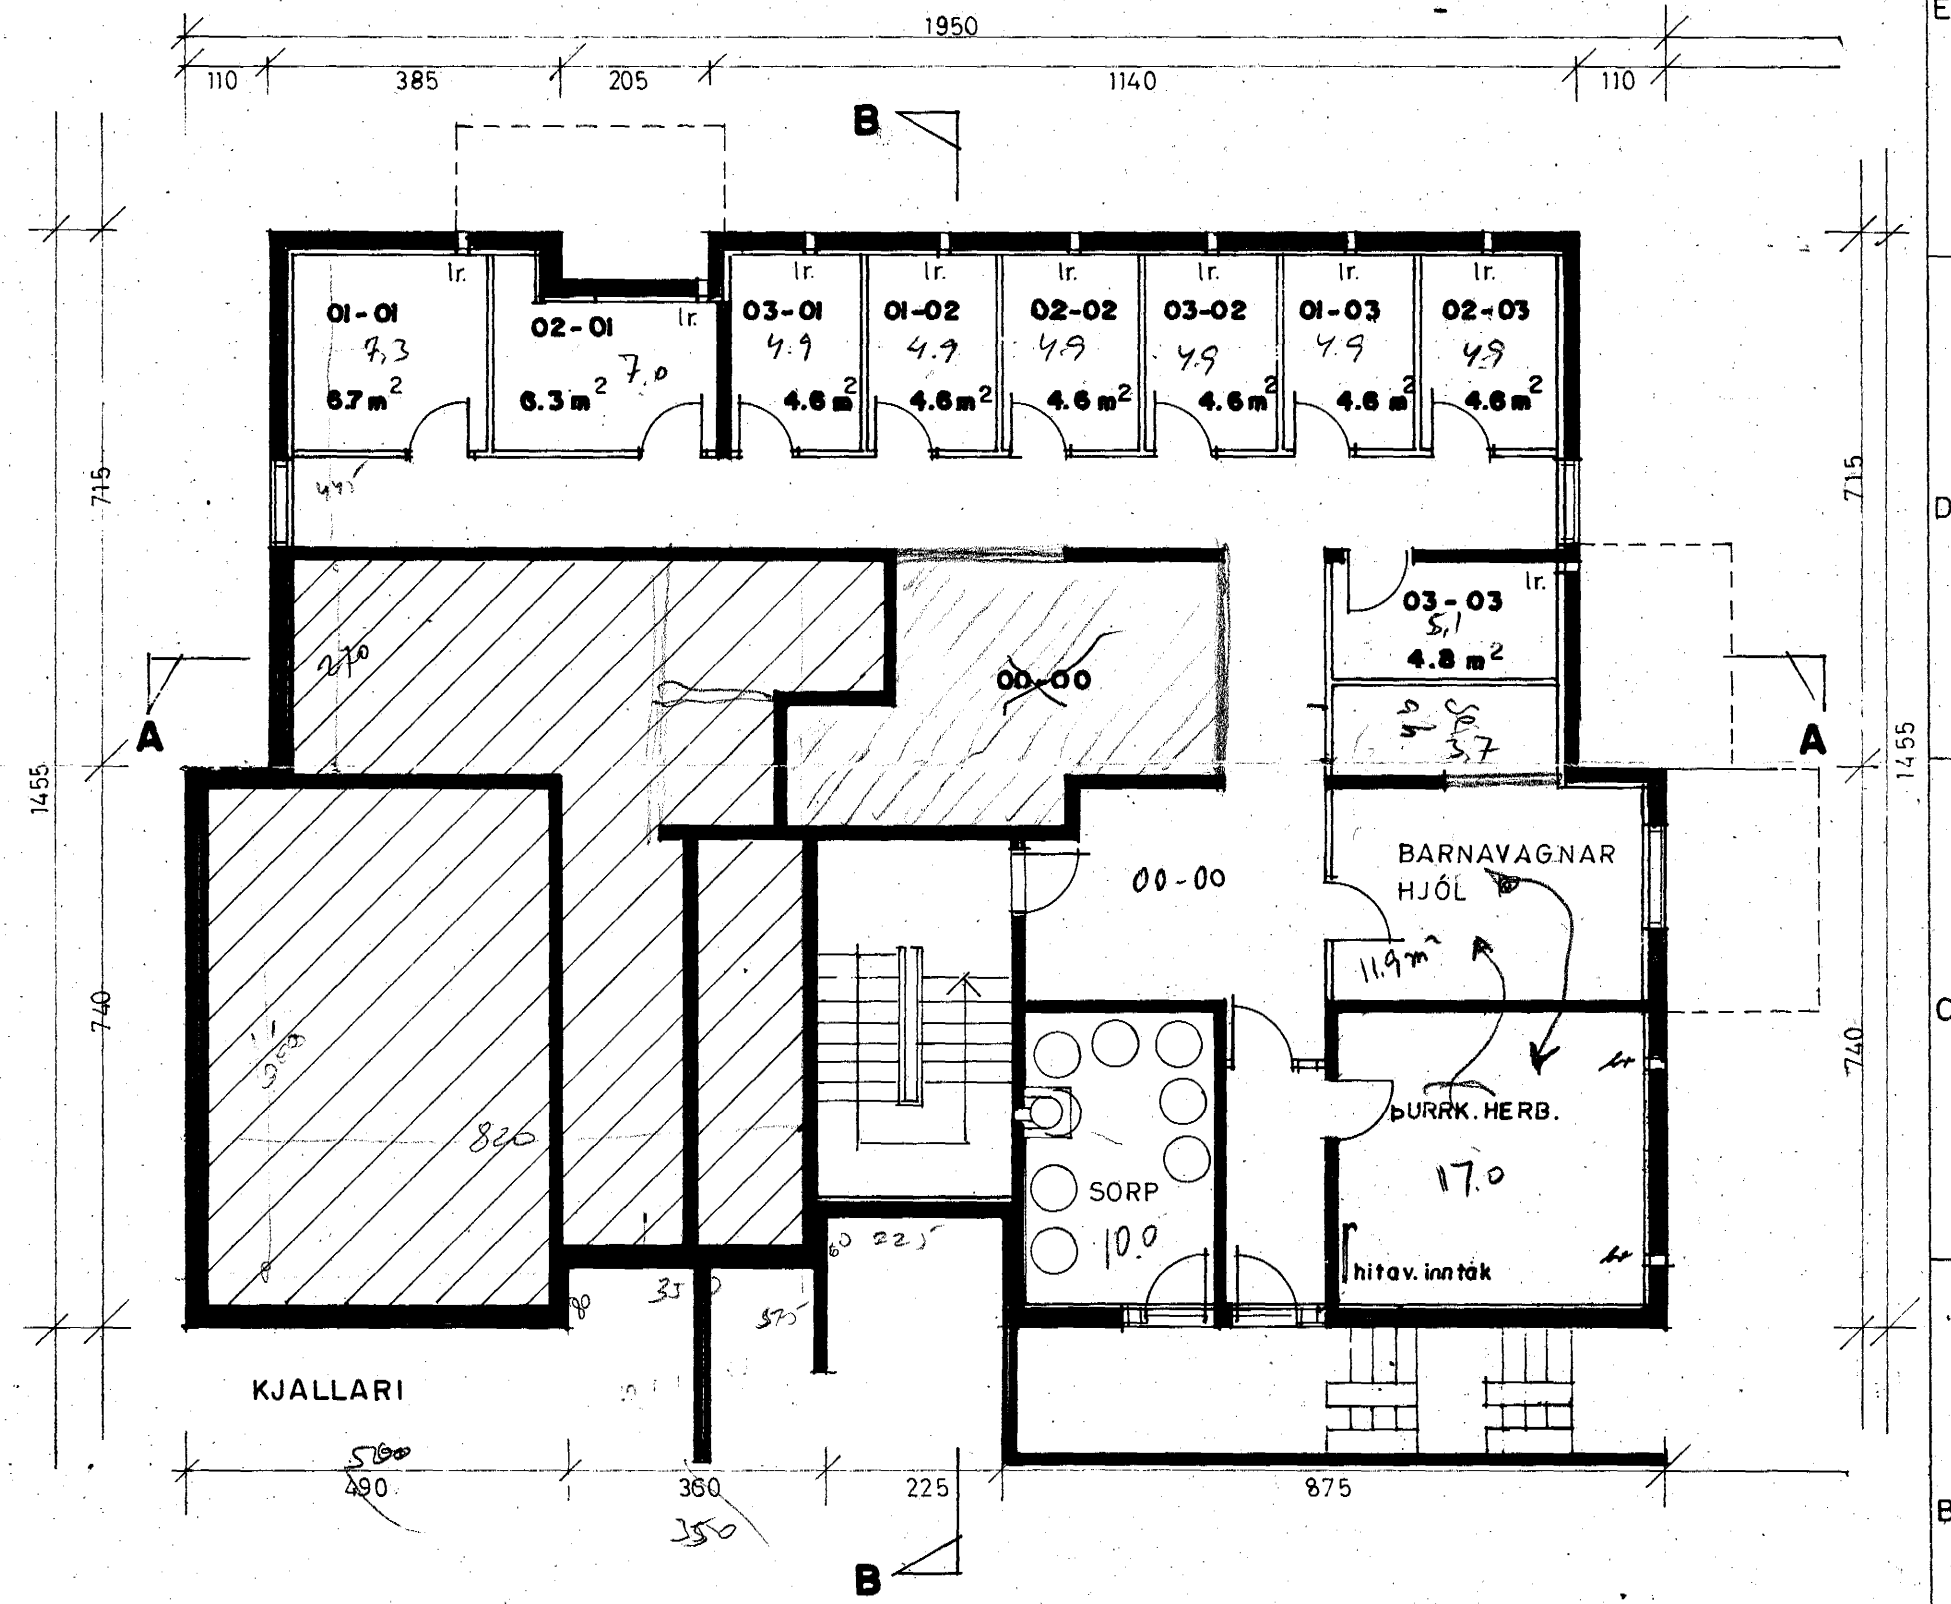


# VÍÐIVANGUR 5

Samþykkt & fundi bygginga-  
nefndar þ. 6. 6. 1979  
BYGGINGAFULLTRÚINN  
Í HAFNARFIRÐI

FLATARMÁL	BRÚTTÓ M <sup>2</sup>	NETTÓ M <sup>2</sup>
ÍBÚÐ 01.02.03-03	61.0	55.3
01.02.03-02	82.0	76.2
01-01	95.0	87.0
02.03-01	104.0	94.3
STIGAHÚS 2 OG 3 HÆÐ	13.5	12.7
1 HÆÐ	21.0	19.5
KJALLARI	13.5	12.7
KJALLARI	146.6	135.0
GRUNNFL. MÁL HÚSS	260.5	
BRÚTTÓRÚMMÁL HÚSS	2760.0 m <sup>3</sup>	2891.0 m <sup>3</sup>

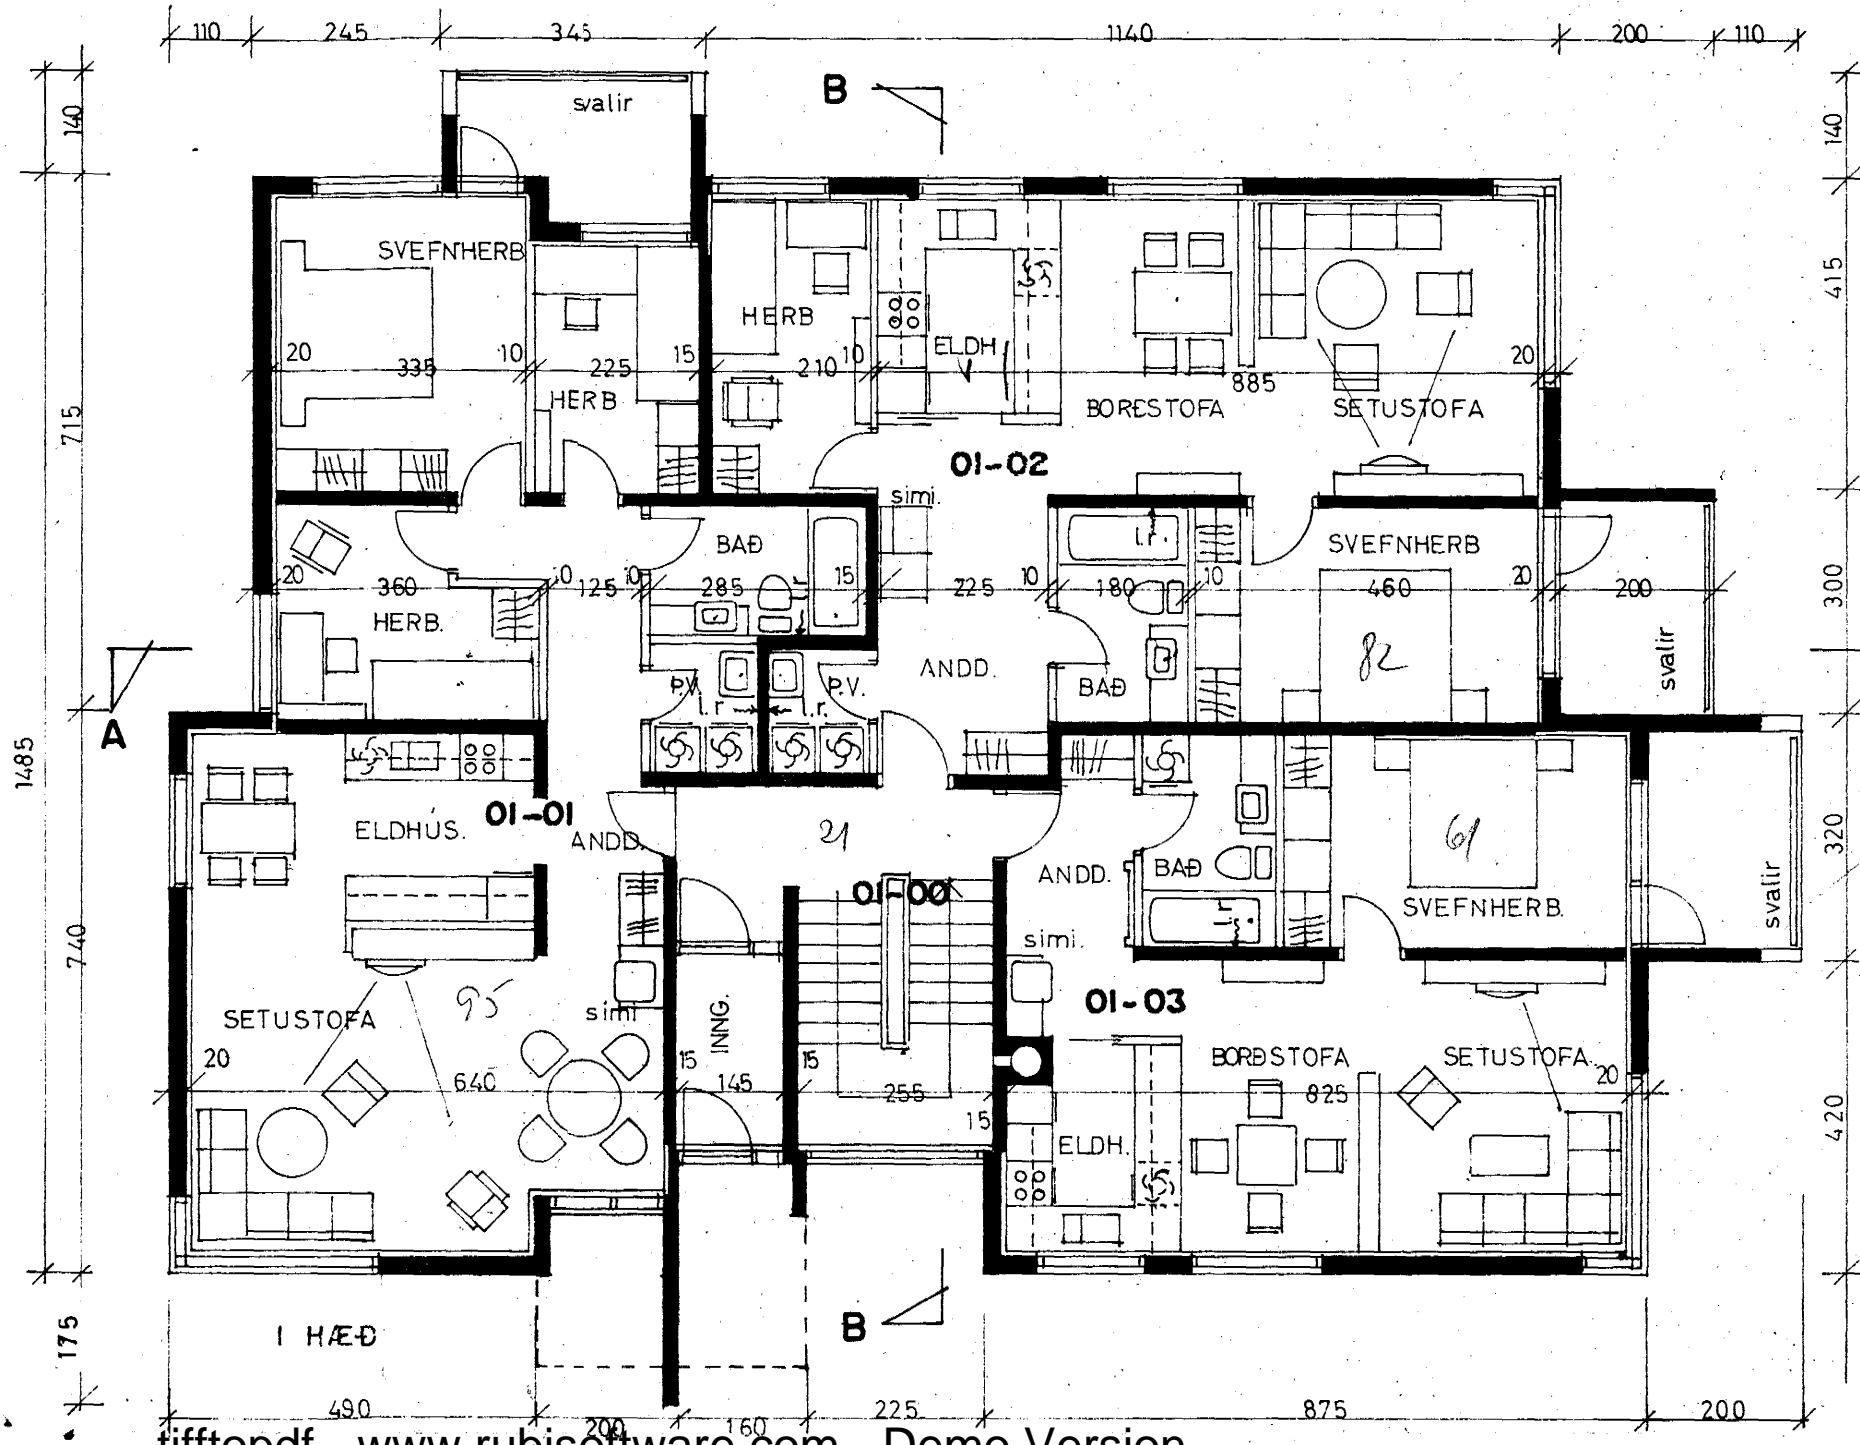

## VÍÐIVANGUR 5 HAFNARFIRÐI

VERK :	KVAFÐI :	1:100
TEIKNING : GRUNNMYND KJ, 1, 2 HÆÐ	VERK NR :	257
TEIKNAD : MAÍ '79	TEIKN.NR :	109
BREYTT :		

NB. SNEIBINGAR SJÁ BL. 112.



**ARKITEKTASTOFAN SF**  
ORMAR ÞÓR GUÐMUNDSSON OG ÓRNÓLFUR HALL ARKITEKTAR FA Í  
SÍÐUMÚLA 23 REYKJAVÍK *Órnólfur Hall* SÍMI 83655