




Austurhlíð

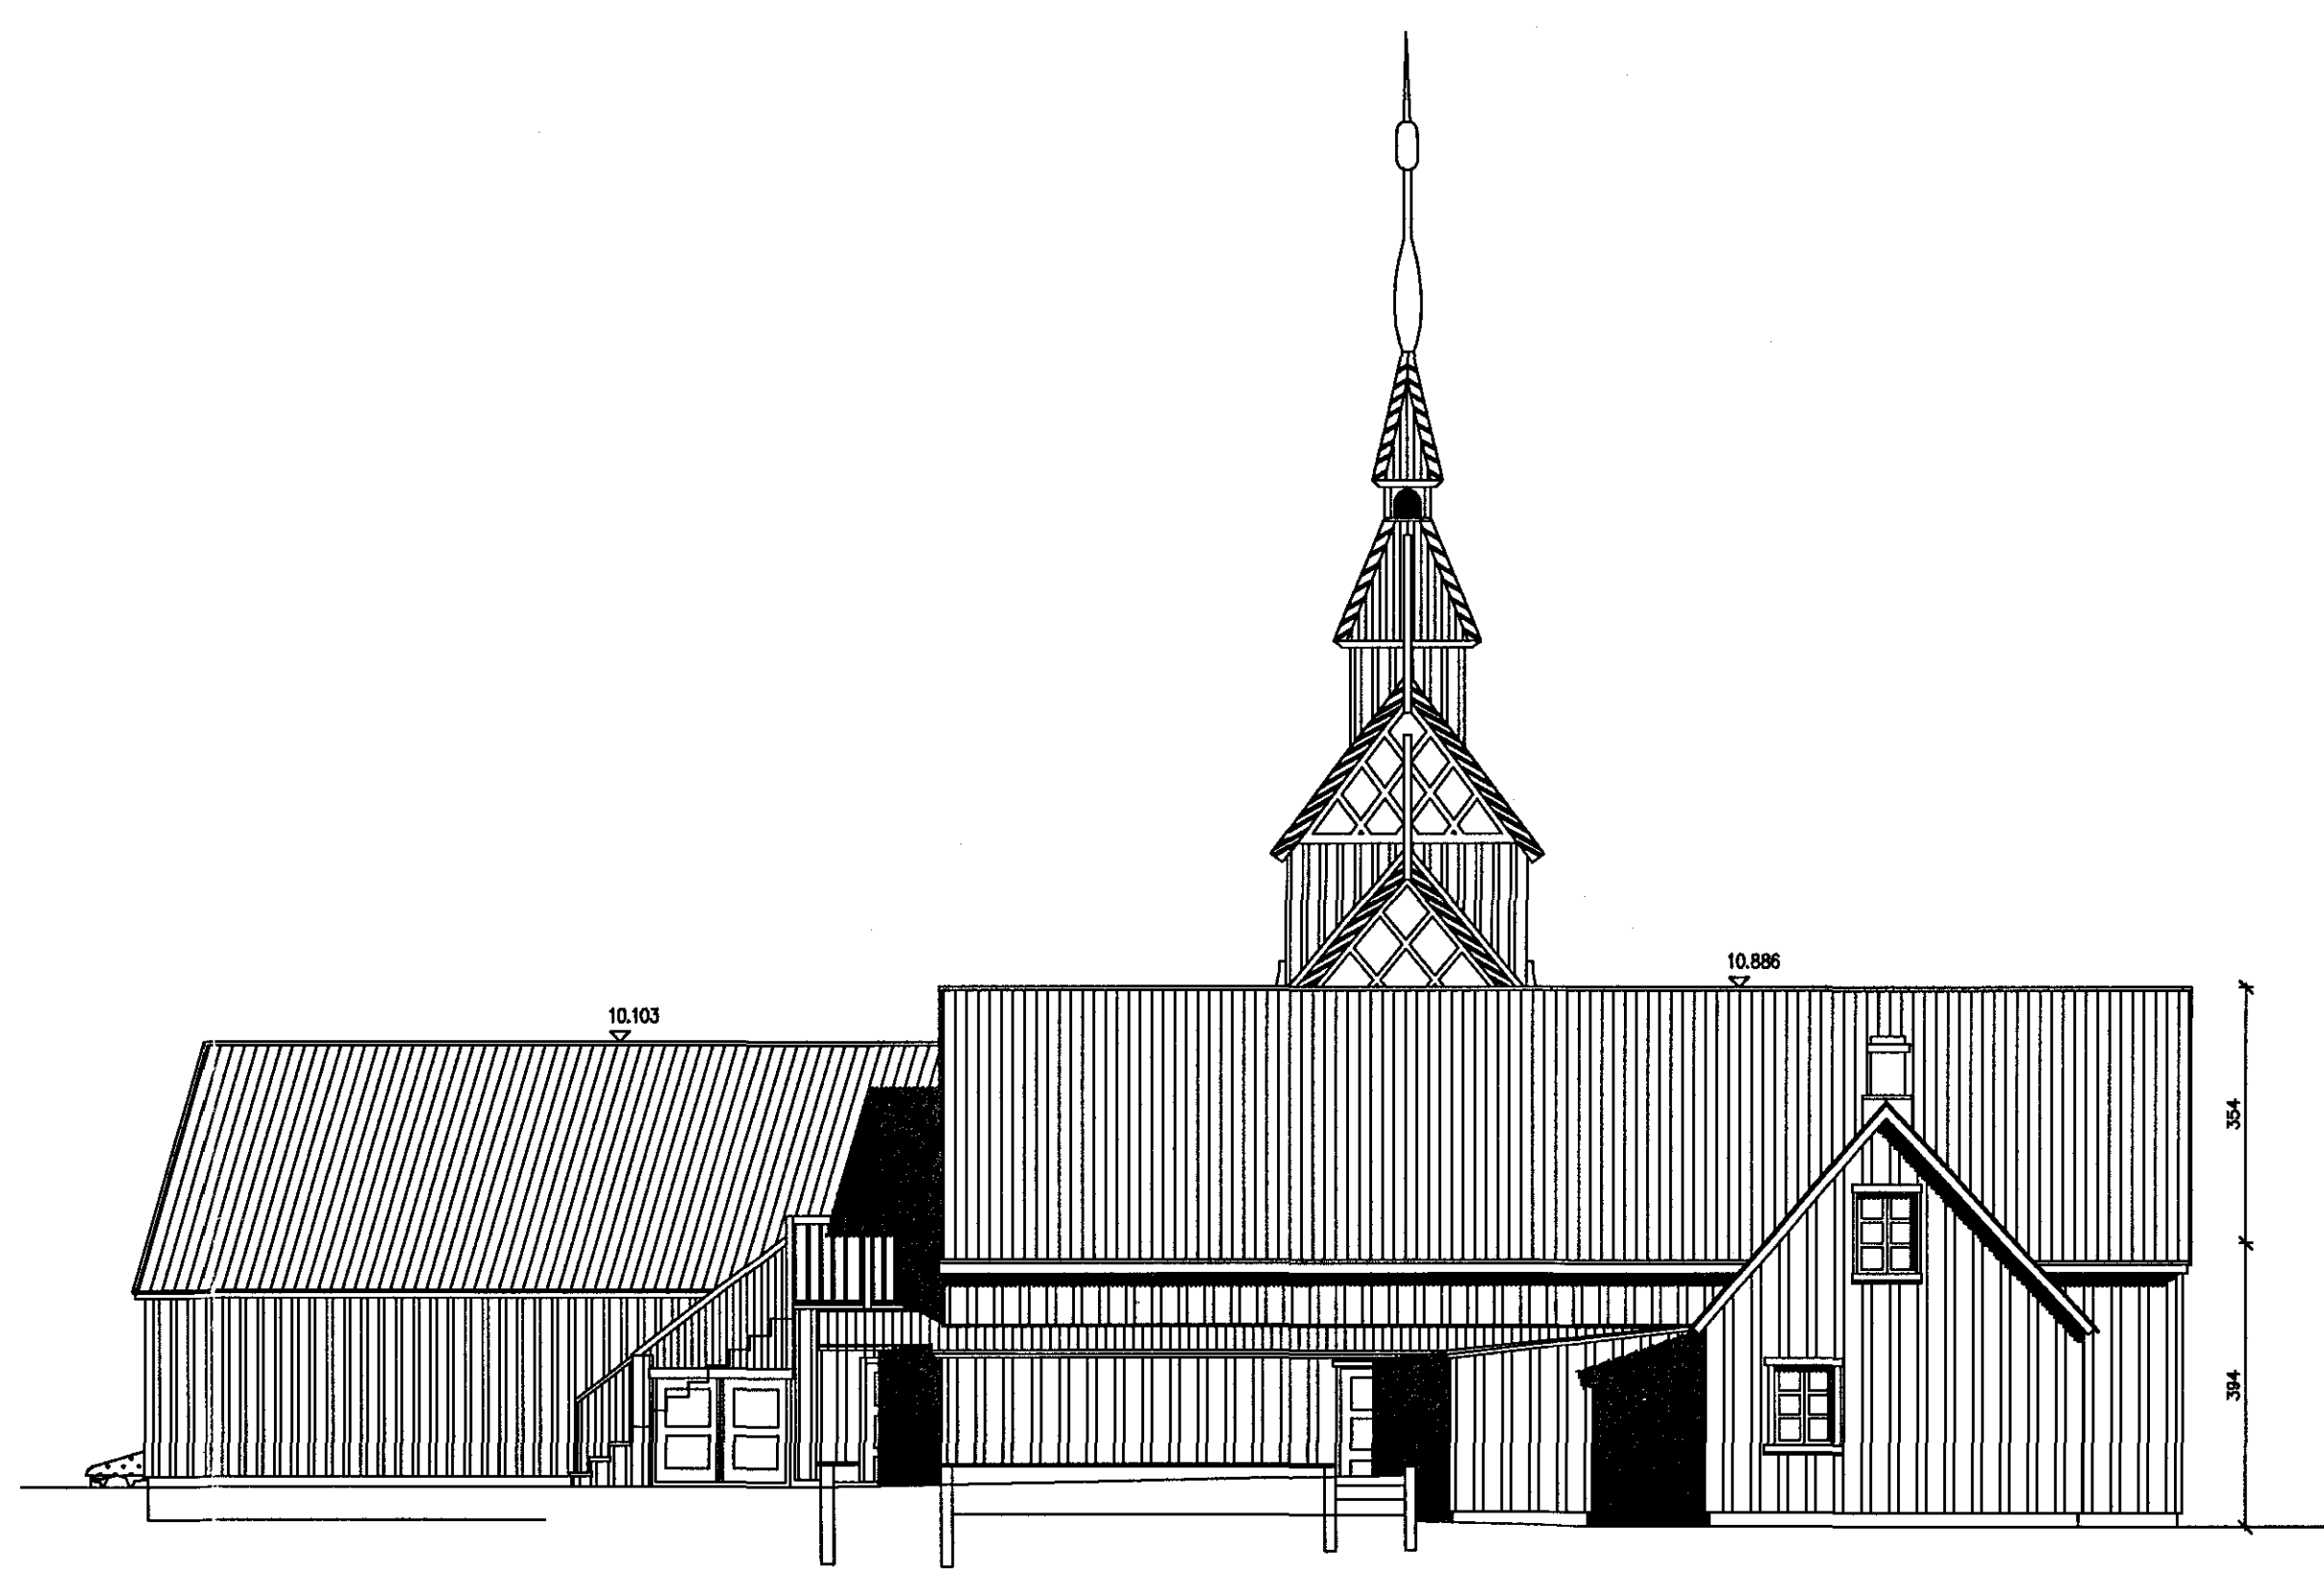


Norðurhlíð

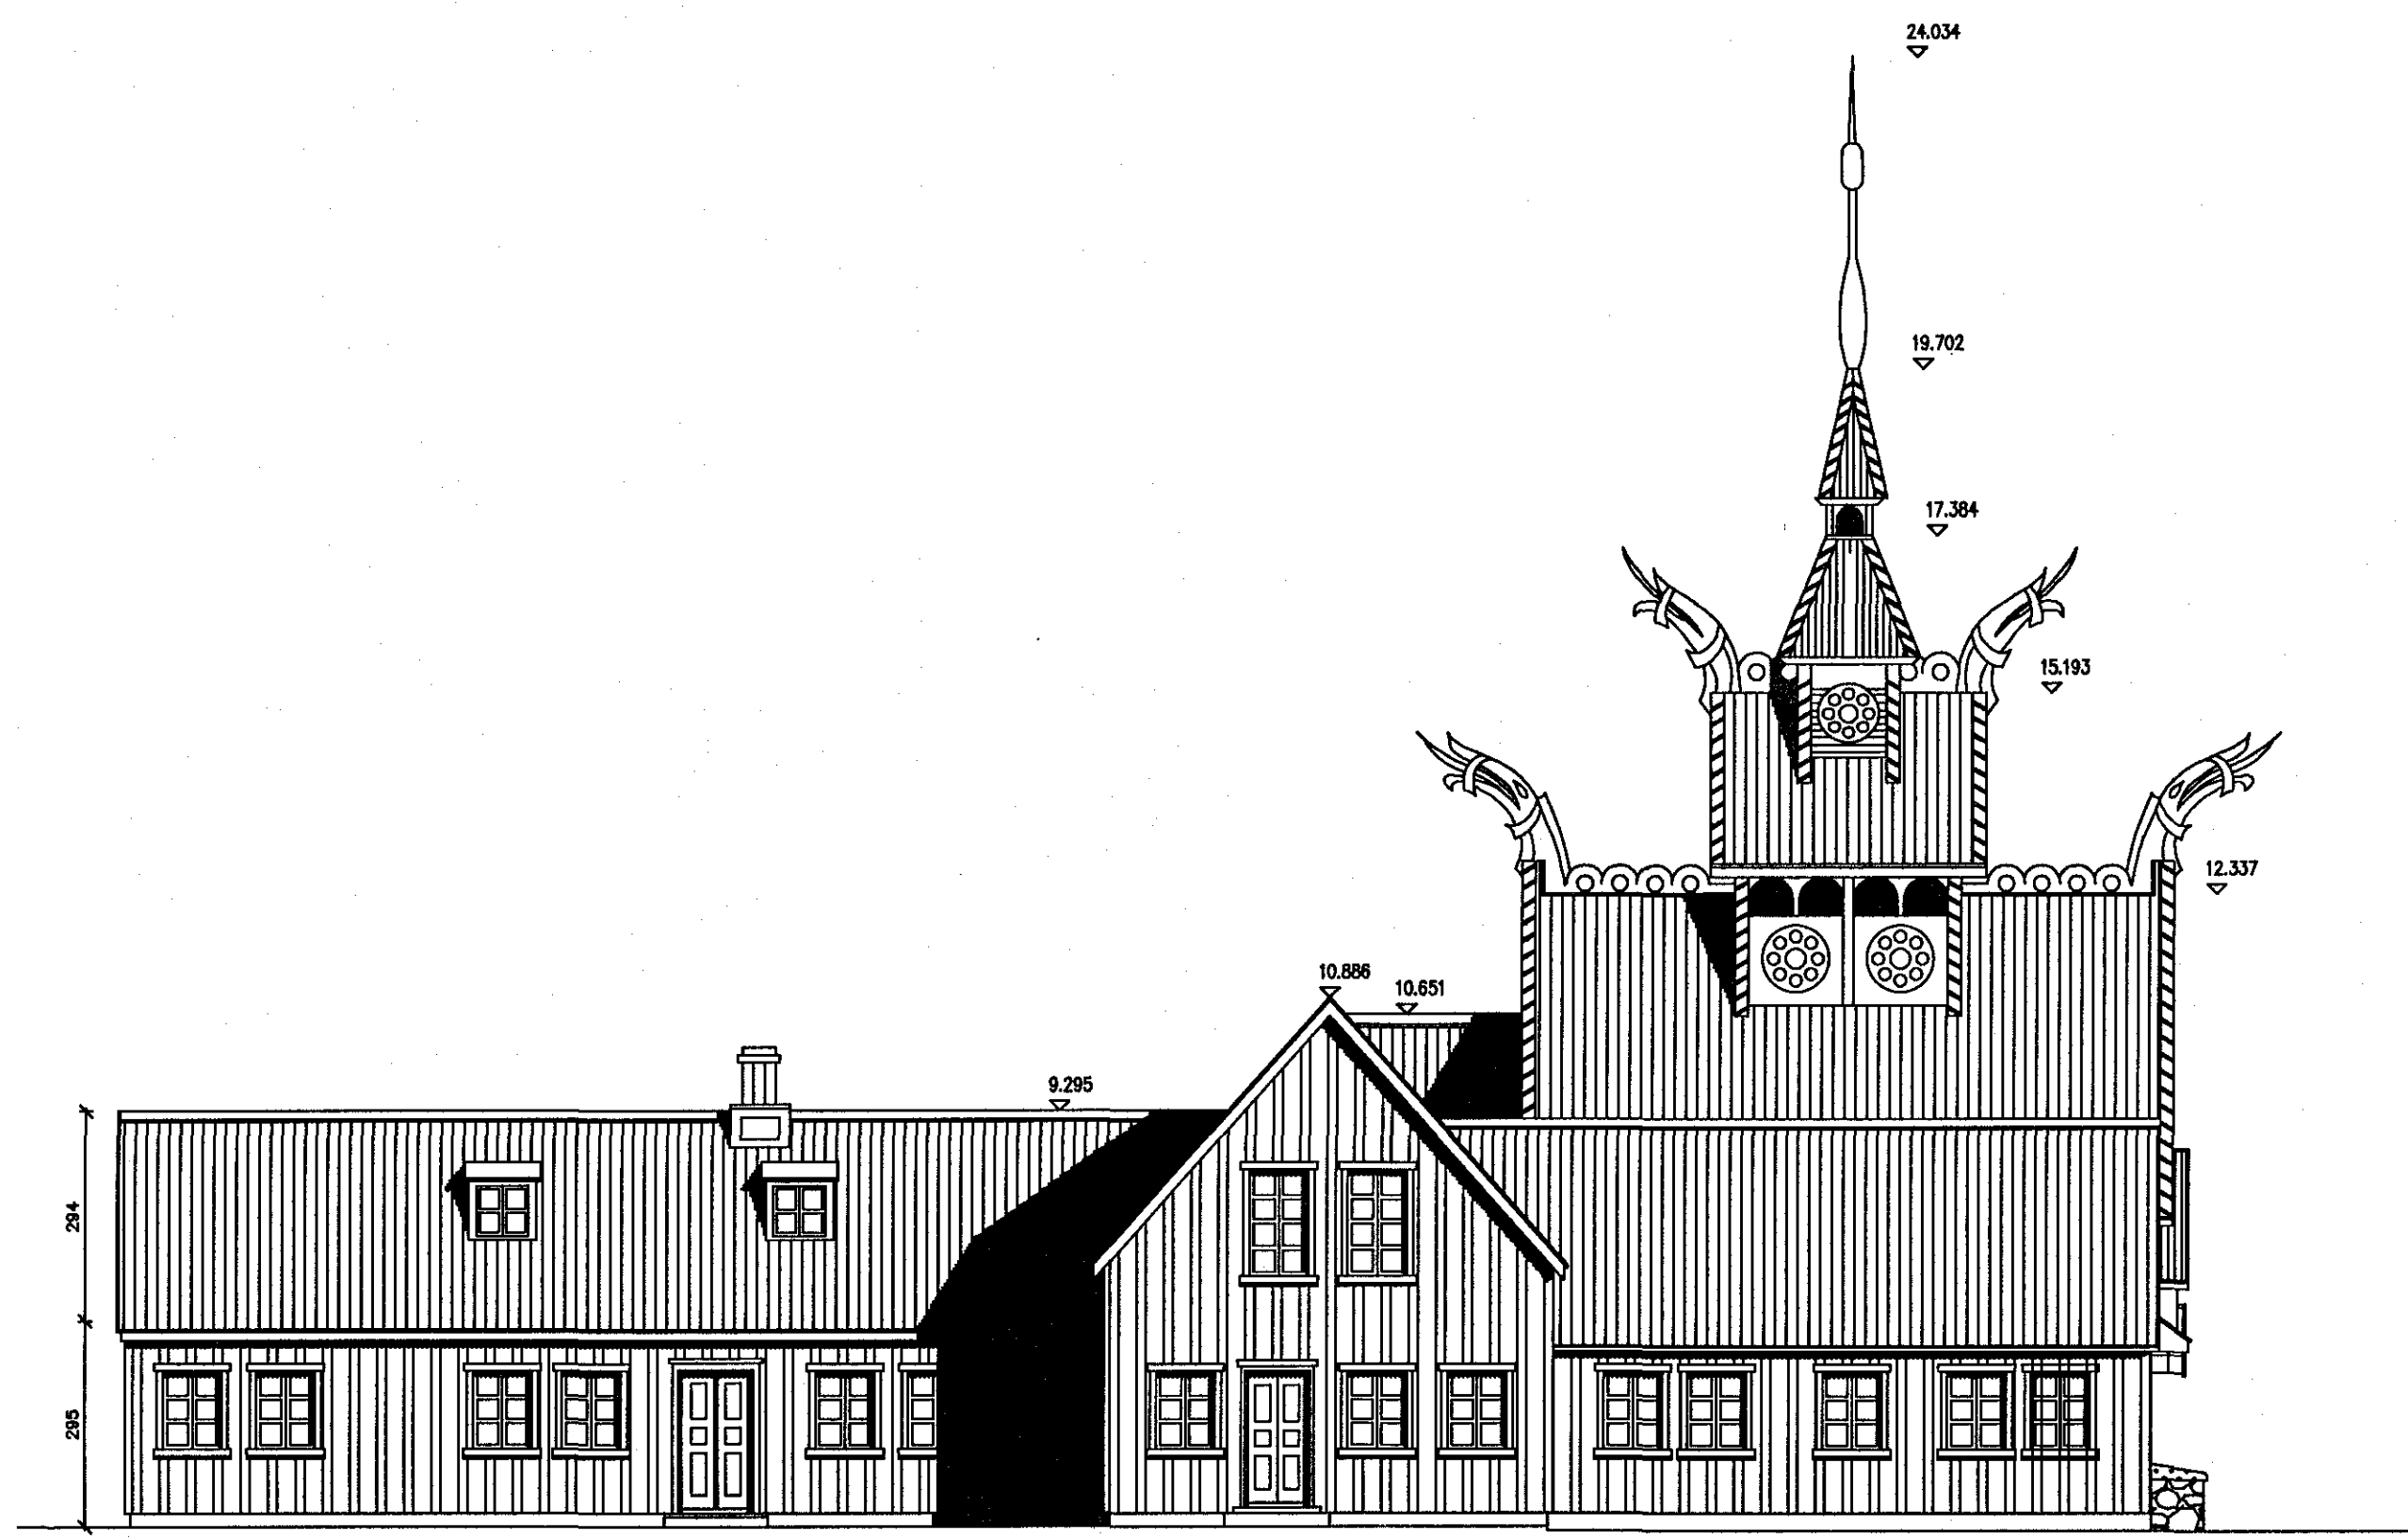

Vesturhlíð

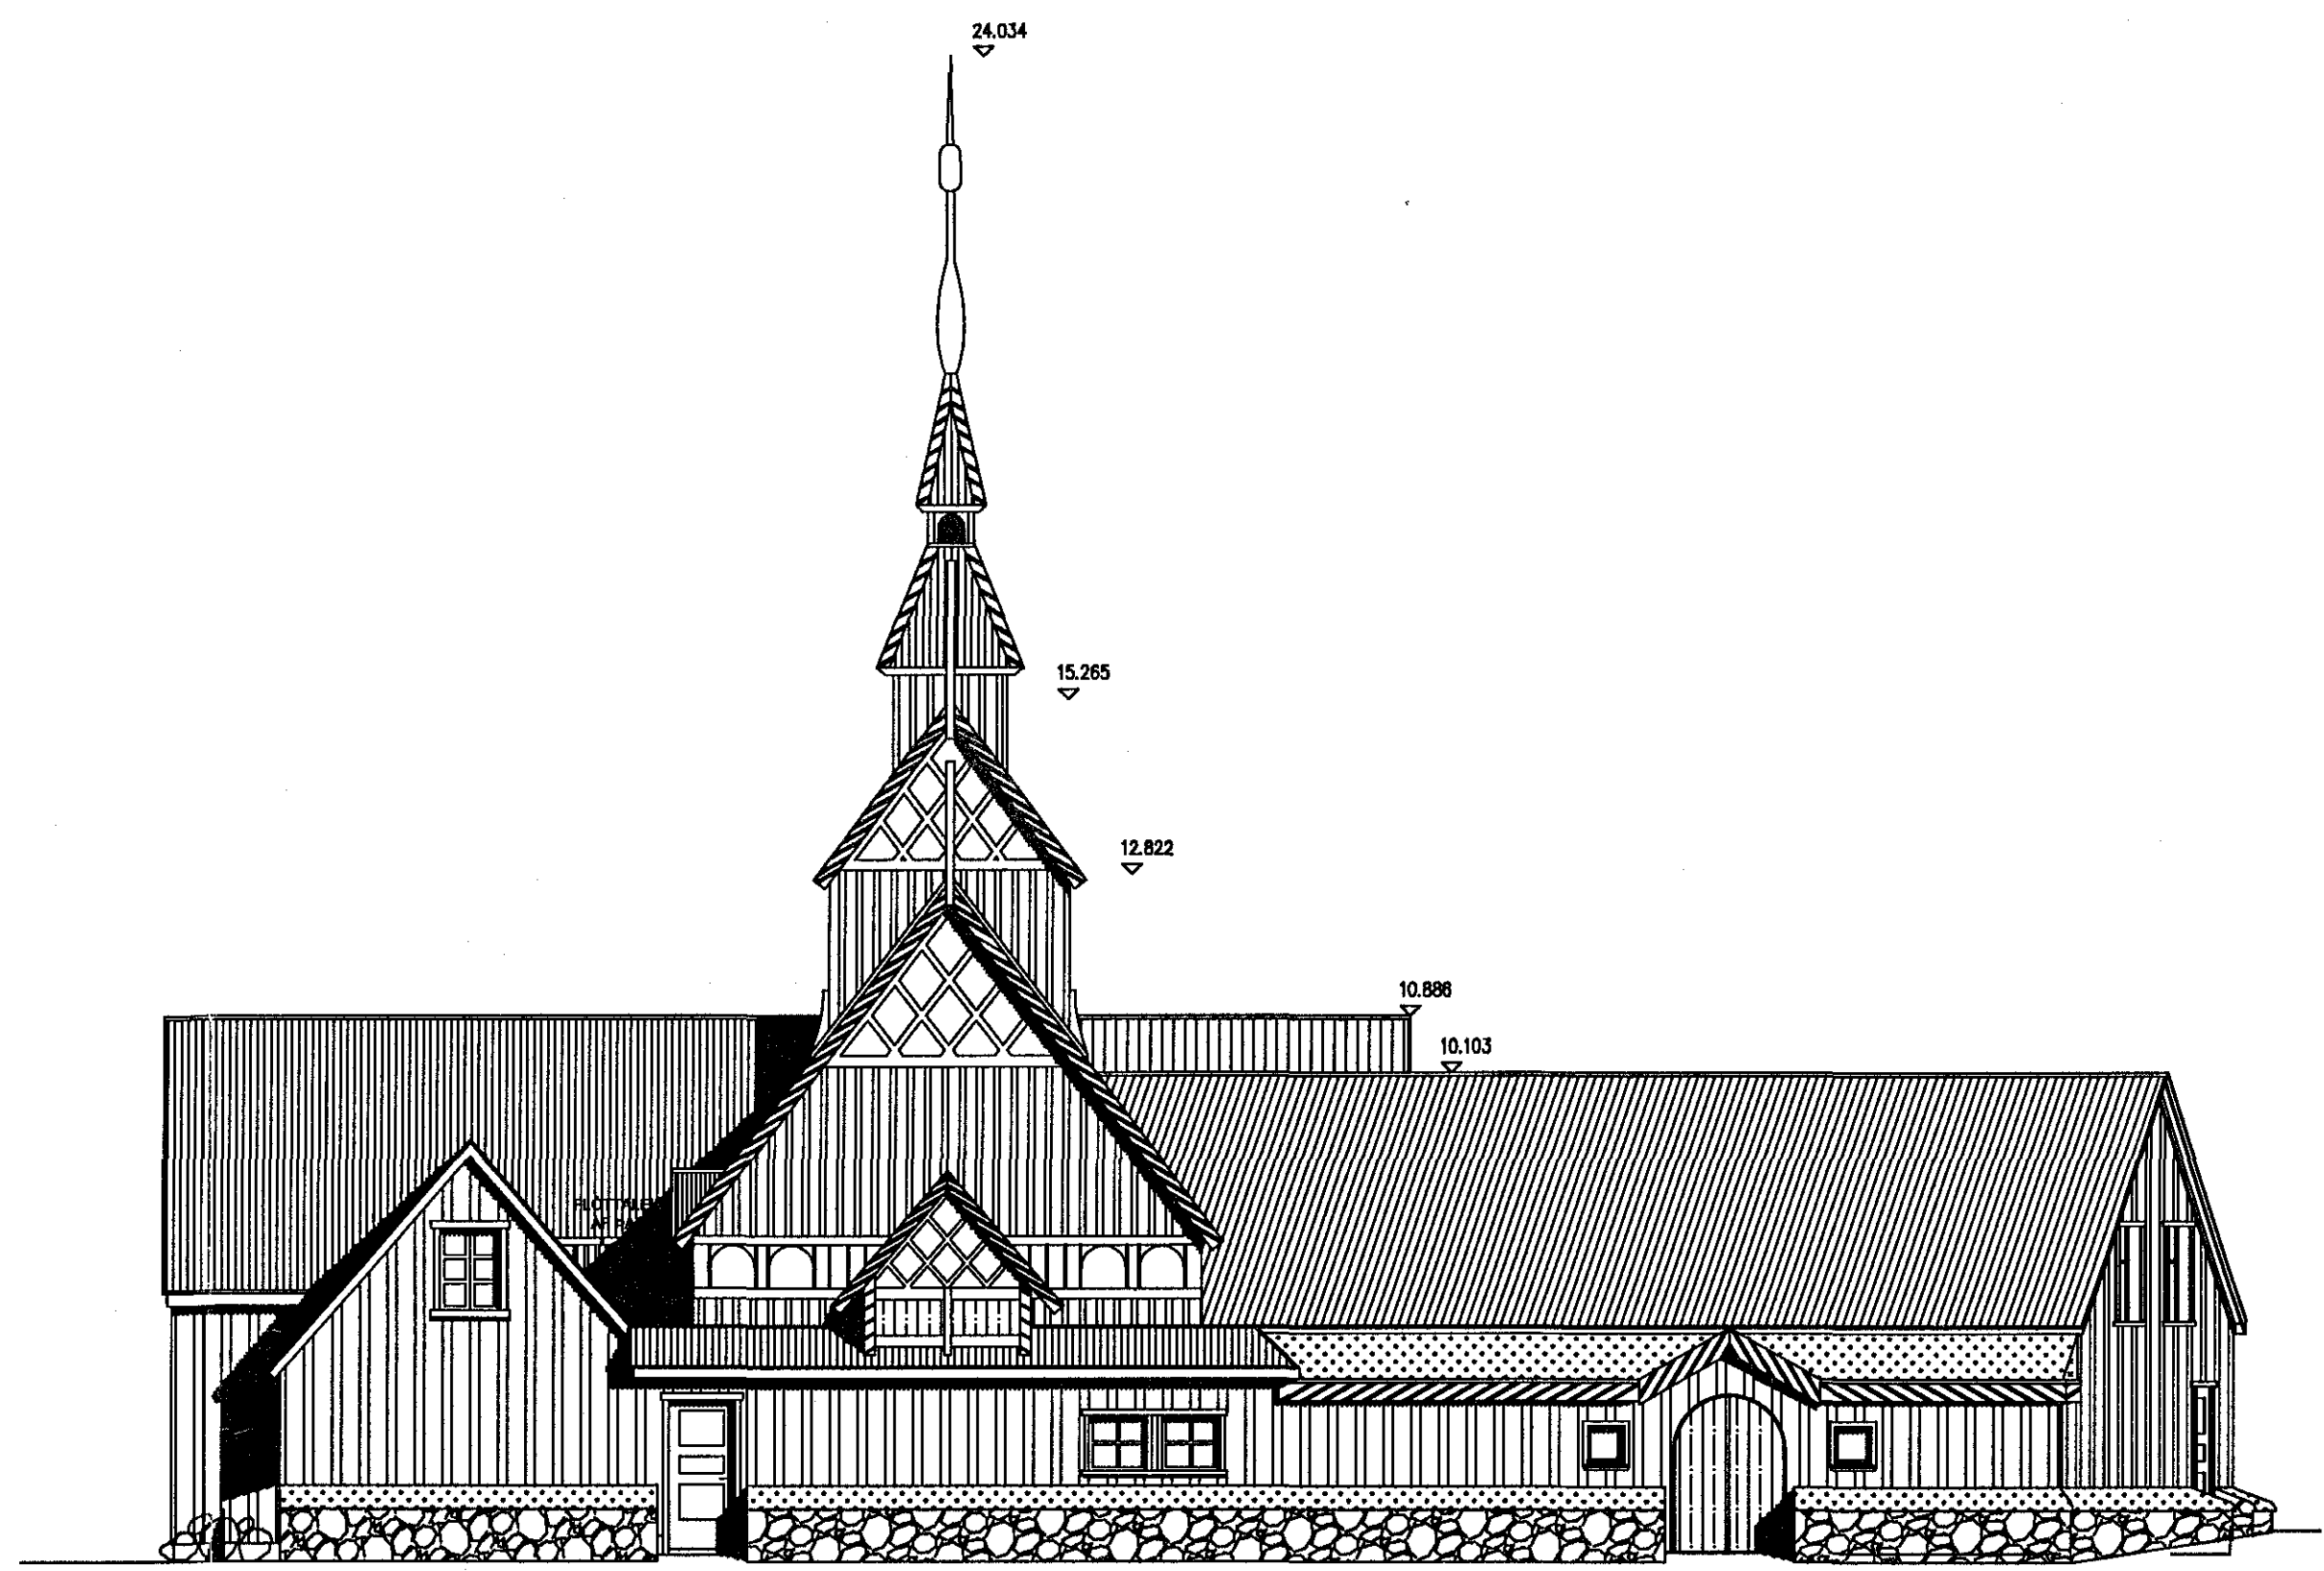

Suðurhlíð

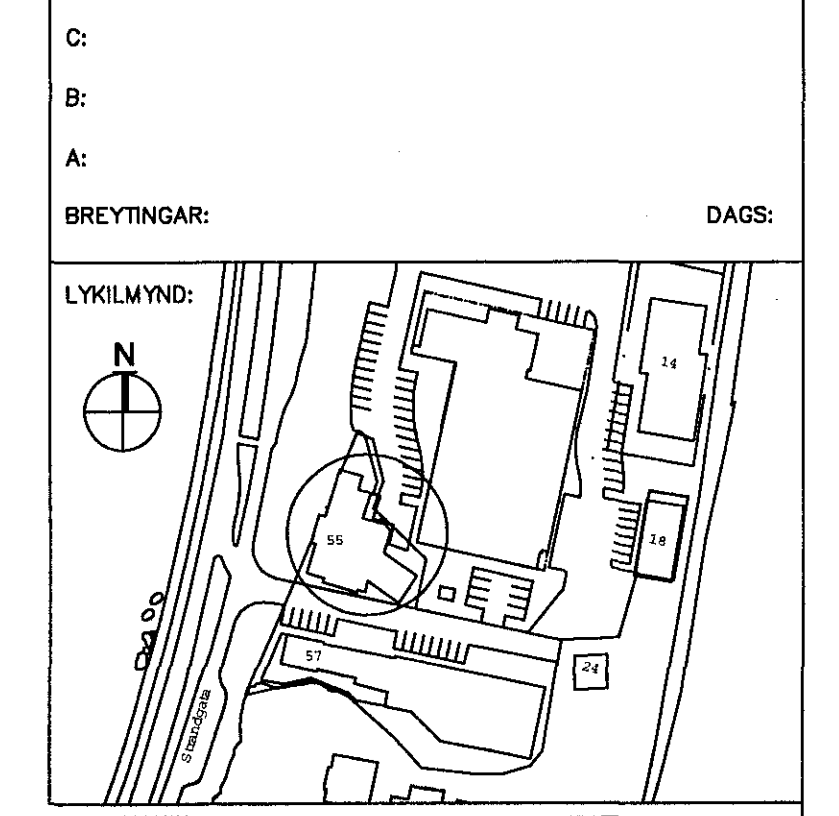

VERKKAUPI:

FJÖRUKRÁIN ehf.
Strandgötu 55.
220 Hafnarfirði.

ADALUPPDRATTUR / REYNDARTEIKNING.
ÓTLIT

VERK: FJÖR-0408 TEIKNINGANR: A-0102
KVARDI: 1:100 TEIKNAD: ÞMM
DAGS: 10.10.2005. SKRÁ: .DWG

ÚTI INNI

ARKITEKTAR

ÞINGHOLTSSTRÆTI 27 101 REYKJAVÍK
SÍMAR 5527860 & 5627860 FAX 5527861
NEIFANG u@u.is
VEFFANG http://www.u.is

BALDUR Ó. SVAVARSSON ARKITEKTAR FAI
120357-9149

JÓN ÞÓR ÞORVALDSSON ARKITEKTAR FAI
021258-7579

A-0102

2/10.05
